





New Curtain Wall, Abut 1

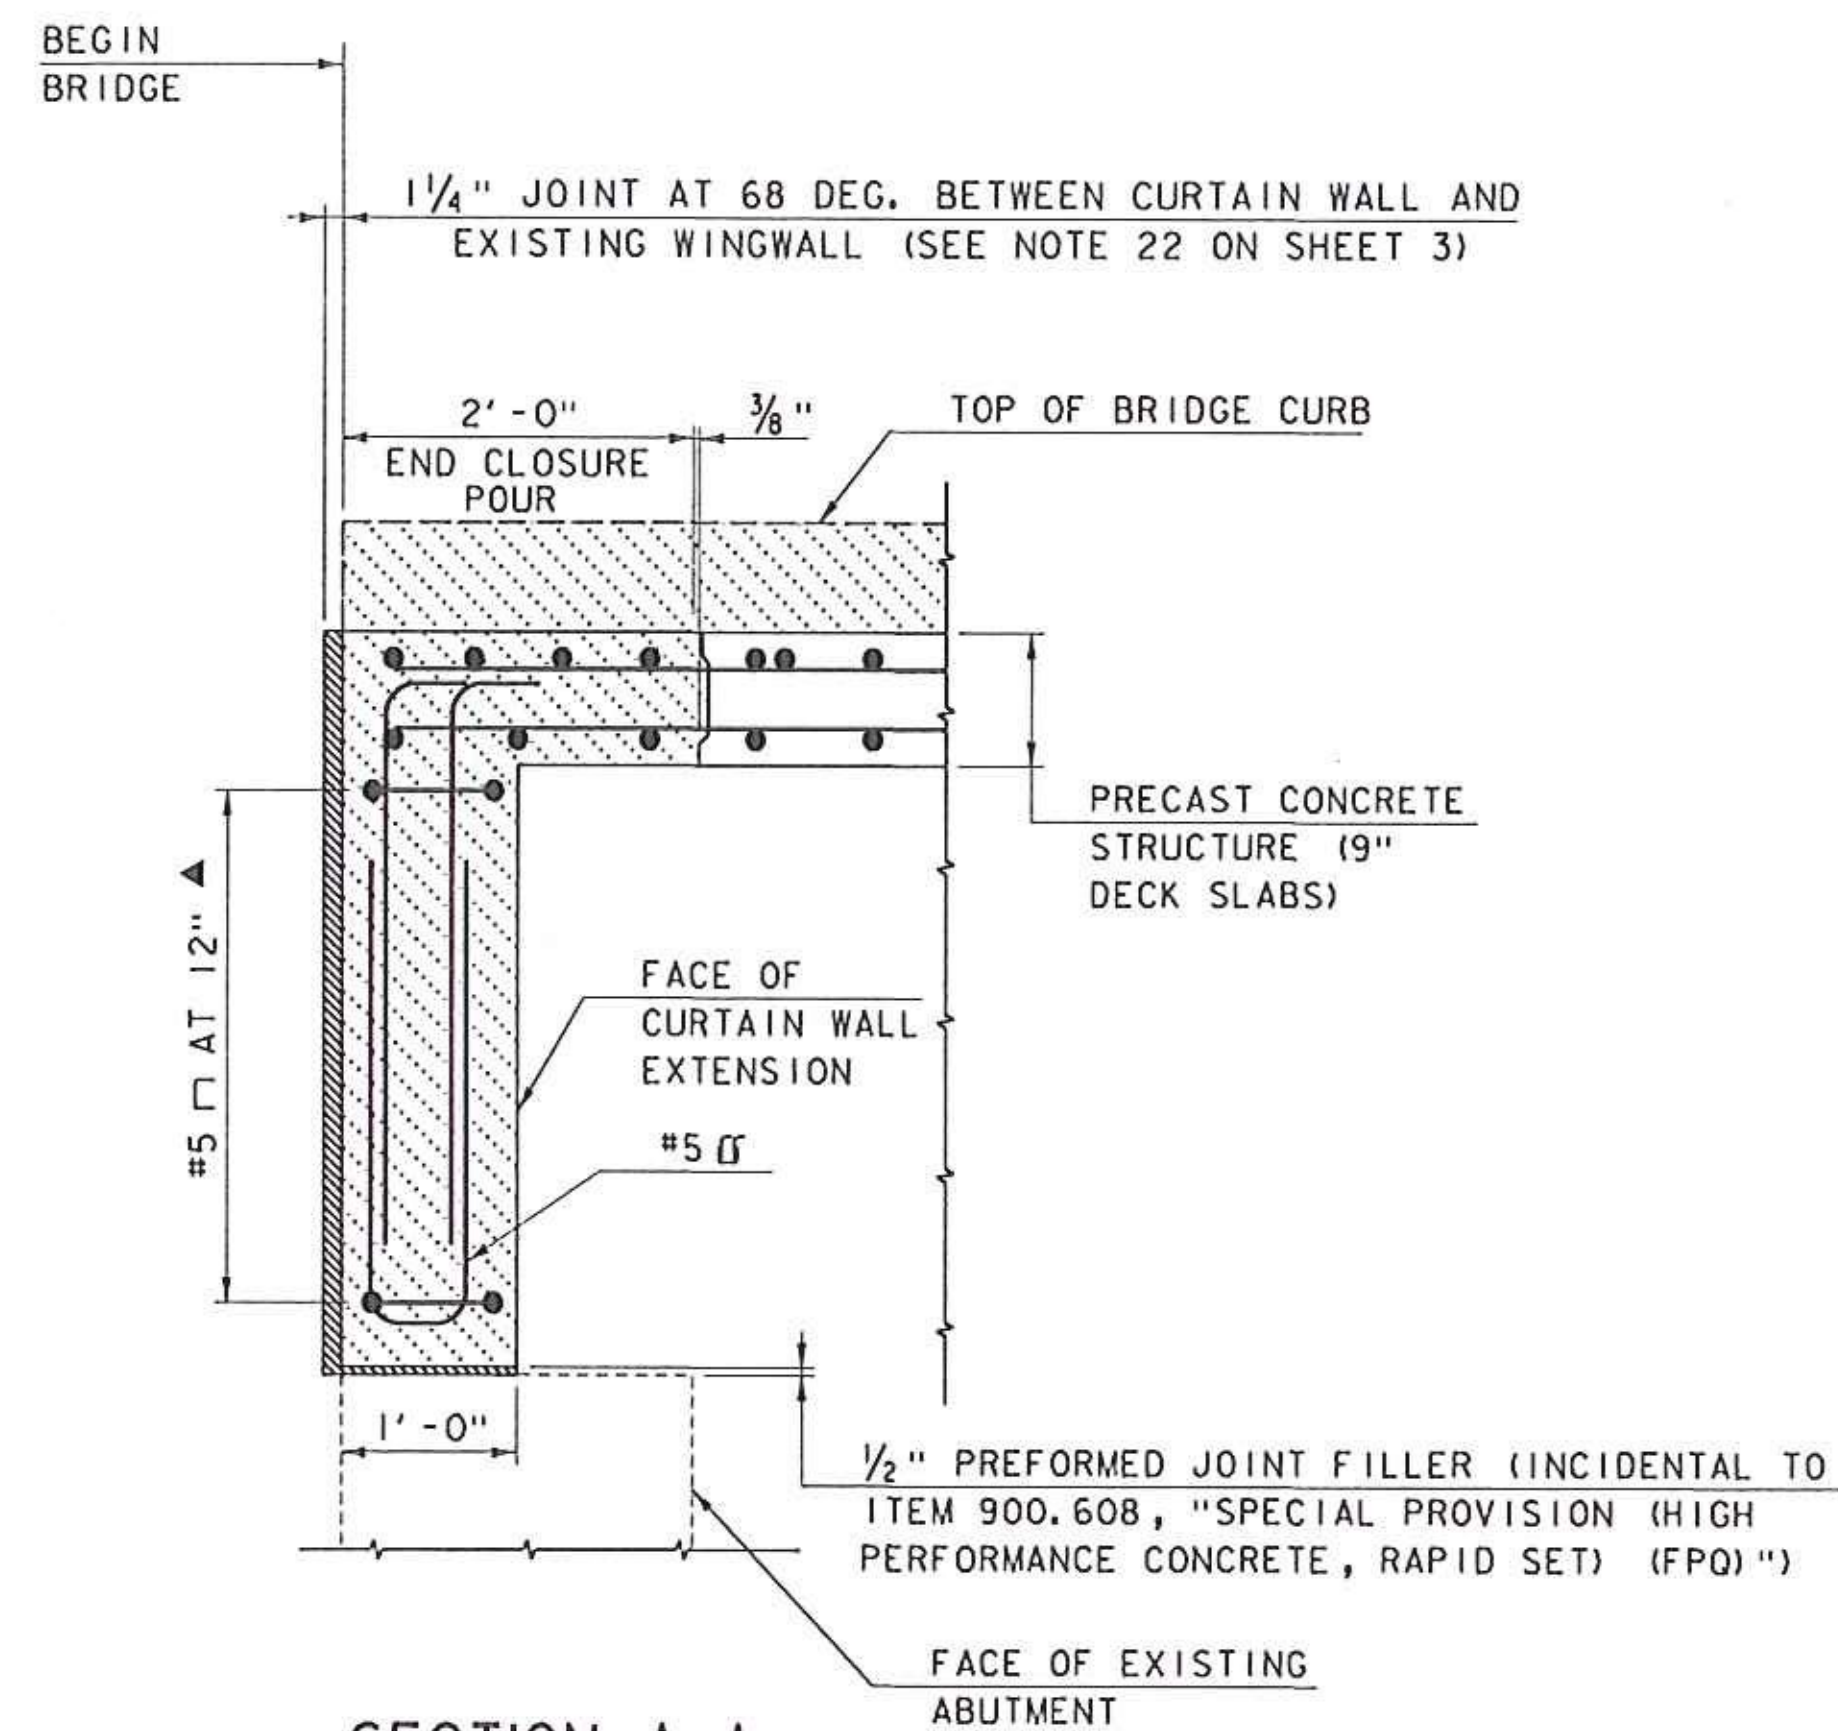

SECTION A-A
SCALE: 1" = 1'-0"

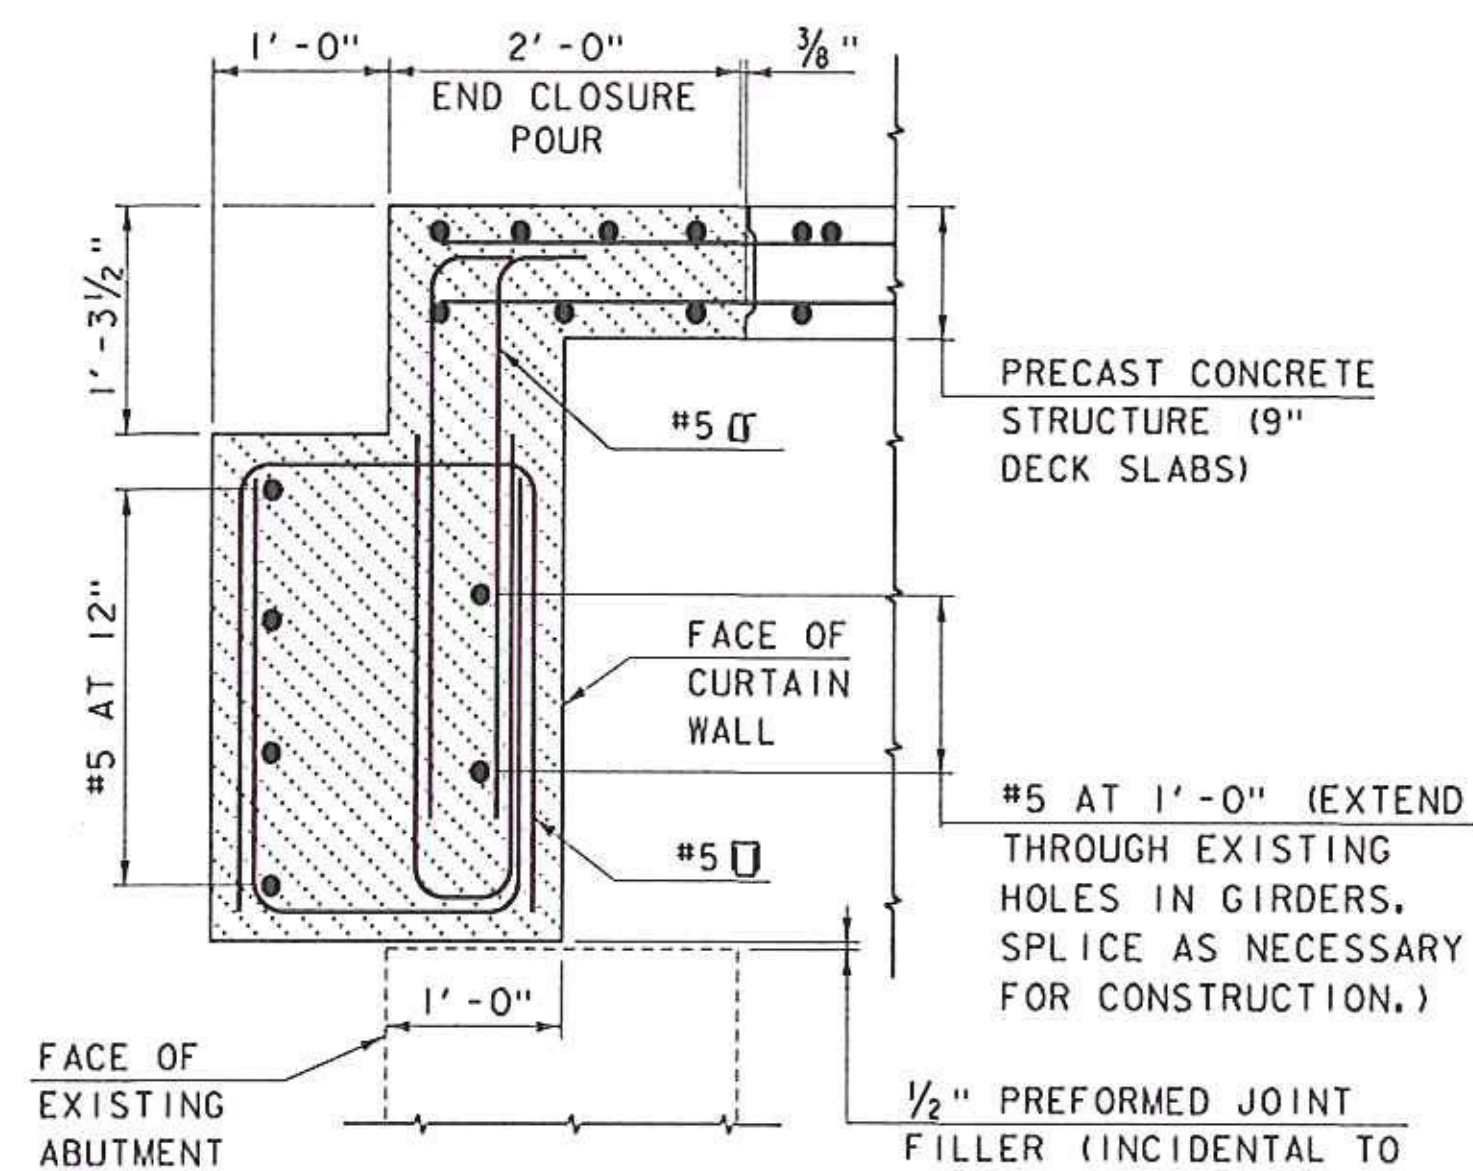


SECTION B-B
SCALE: 1" = 1'-0"

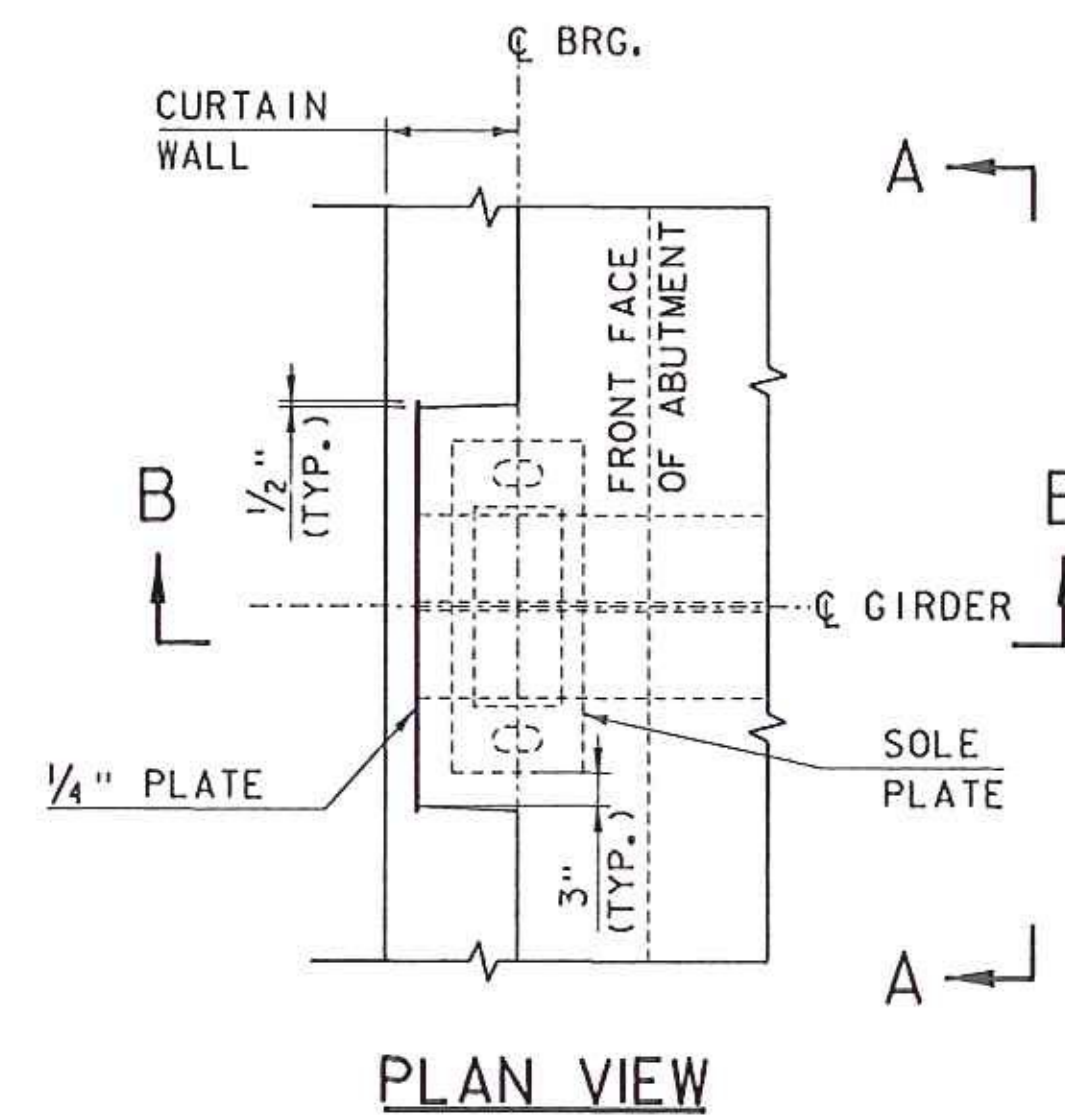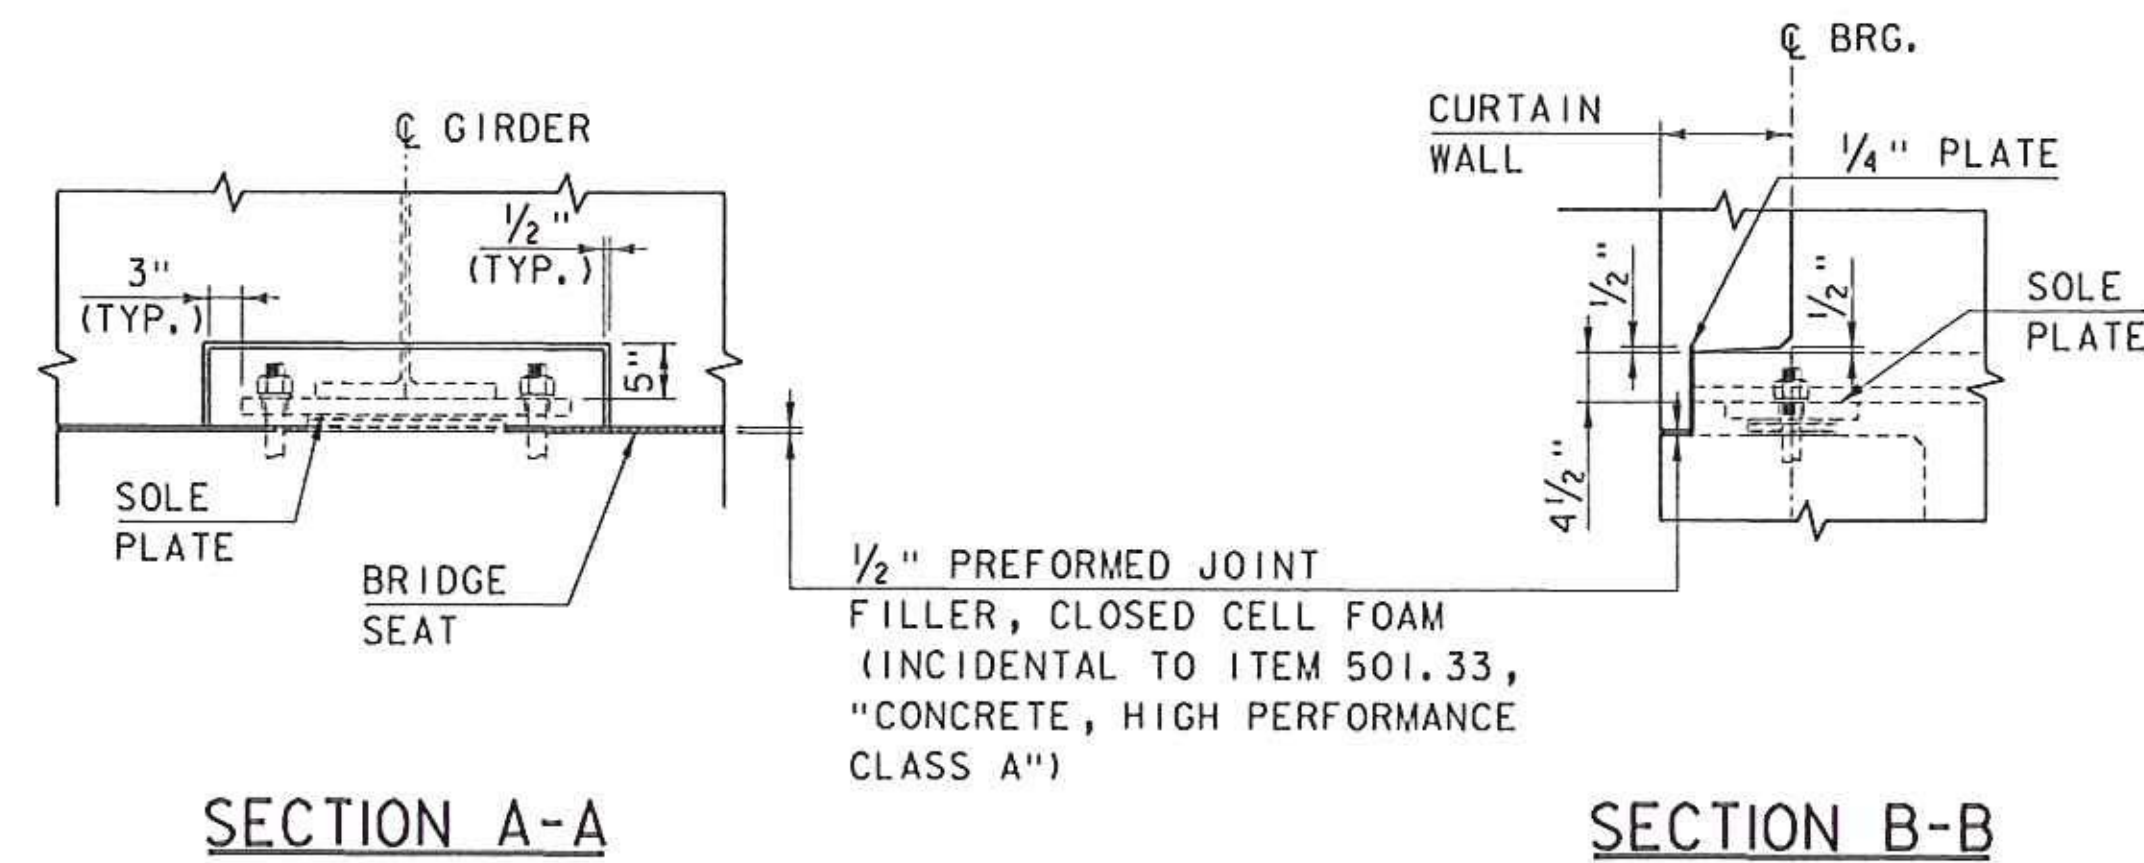

CONCRETE CURTAIN WALL
BLOCKOUTS AROUND BEARINGS
SCALE: 3/4" = 1'-0"

NOTES:

1. 3" CLEAR, UNLESS OTHERWISE SPECIFIED ON THE PLANS.
2. 10" HOOK UNLESS OTHERWISE SPECIFIED ON THE PLANS.

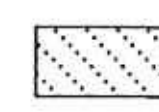 SPECIAL PROVISION (HIGH PERFORMANCE CONCRETE, RAPID SET) (FPO)



PROJECT NAME: LUDLOW
PROJECT NUMBER: STP DECK(39)

FILE NAME: z15b109typ-99.dgn
PROJECT LEADER: J. BYATT
DESIGNED BY: S. BEAUMONT
CURTAIN WALL DETAILS SHEET 2

PLOT DATE: 5/17/2017
DRAWN BY: M. SMITH
CHECKED BY: A. GIRALDI
SHEET 258 OF 1