
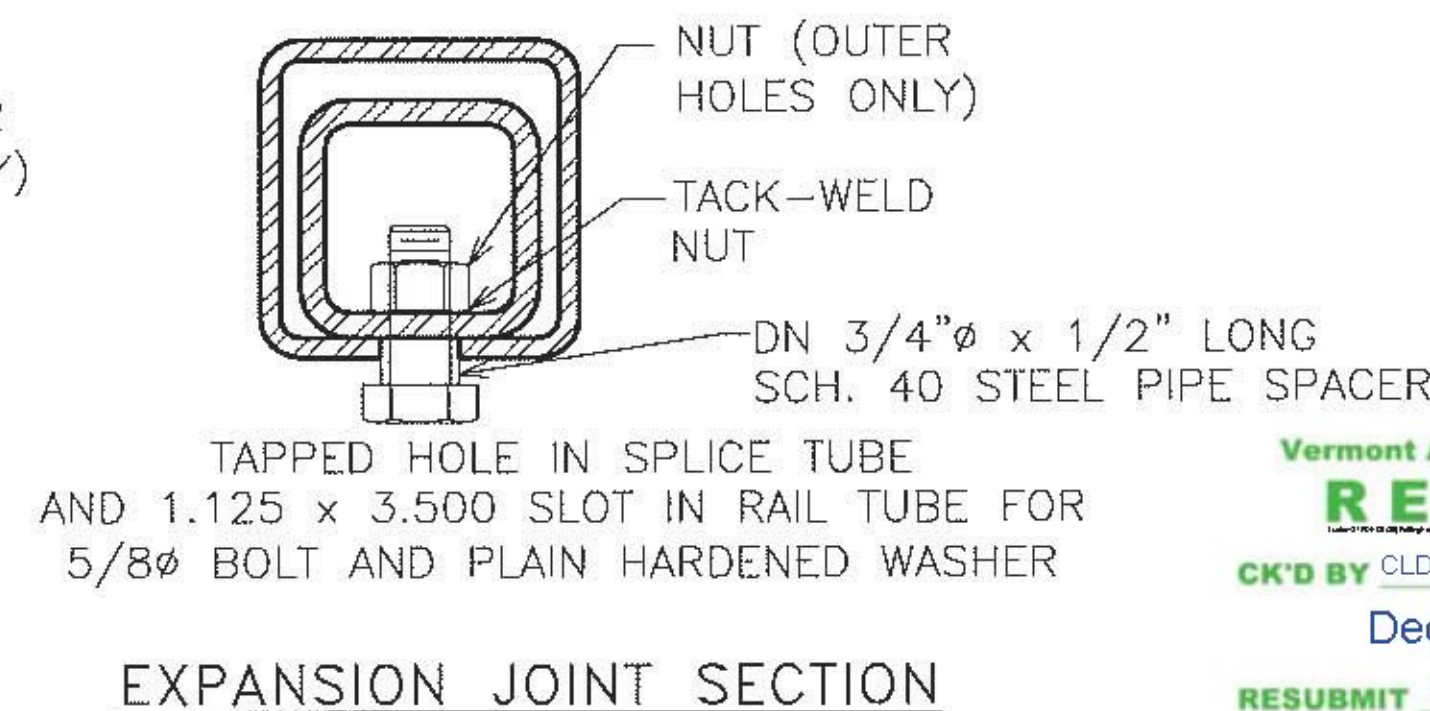
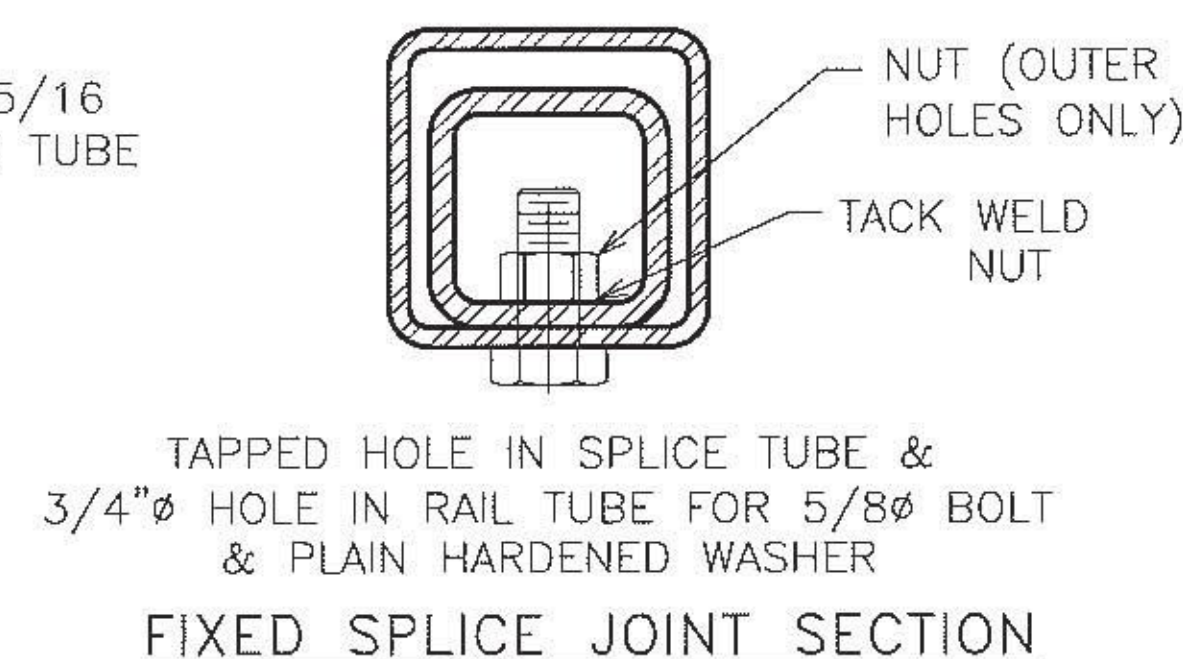
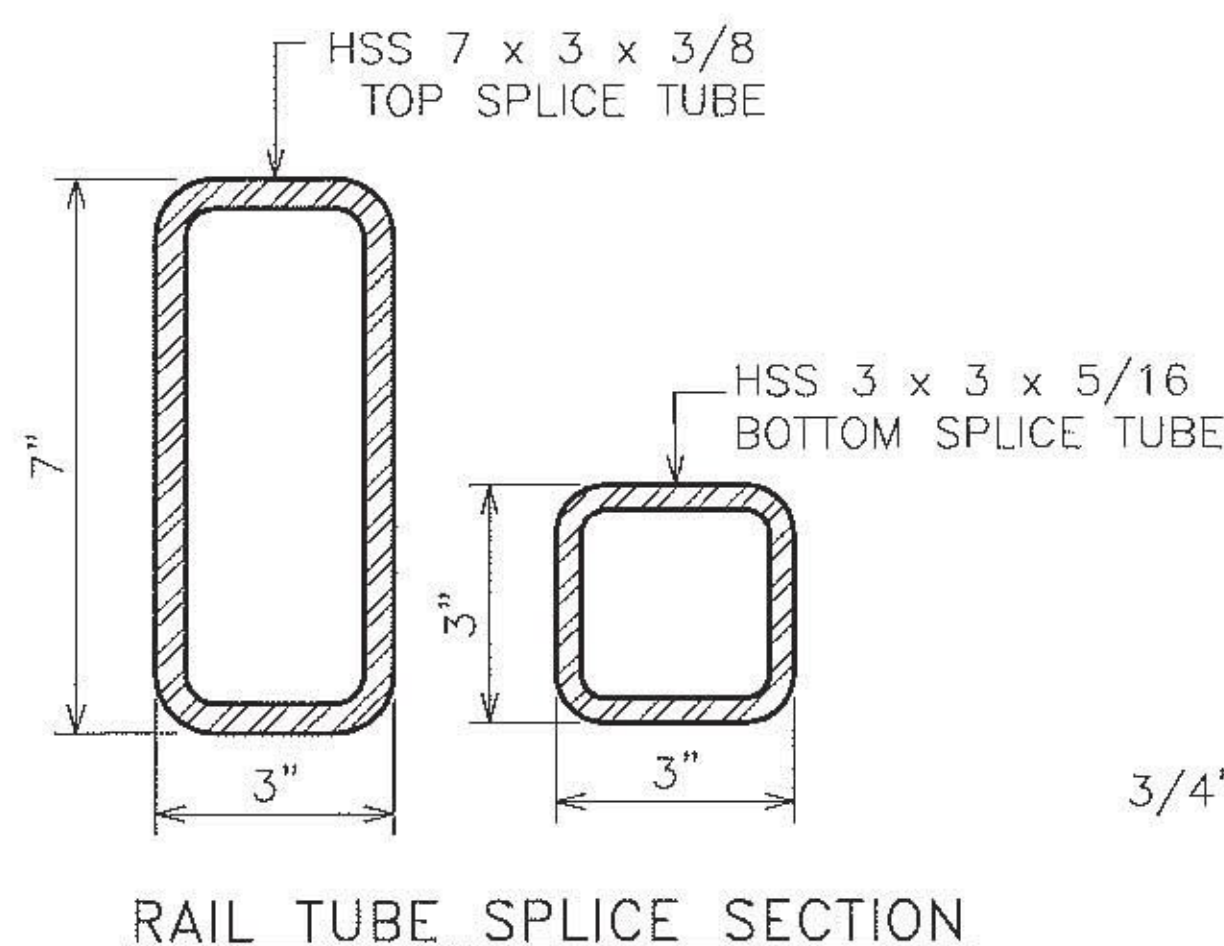
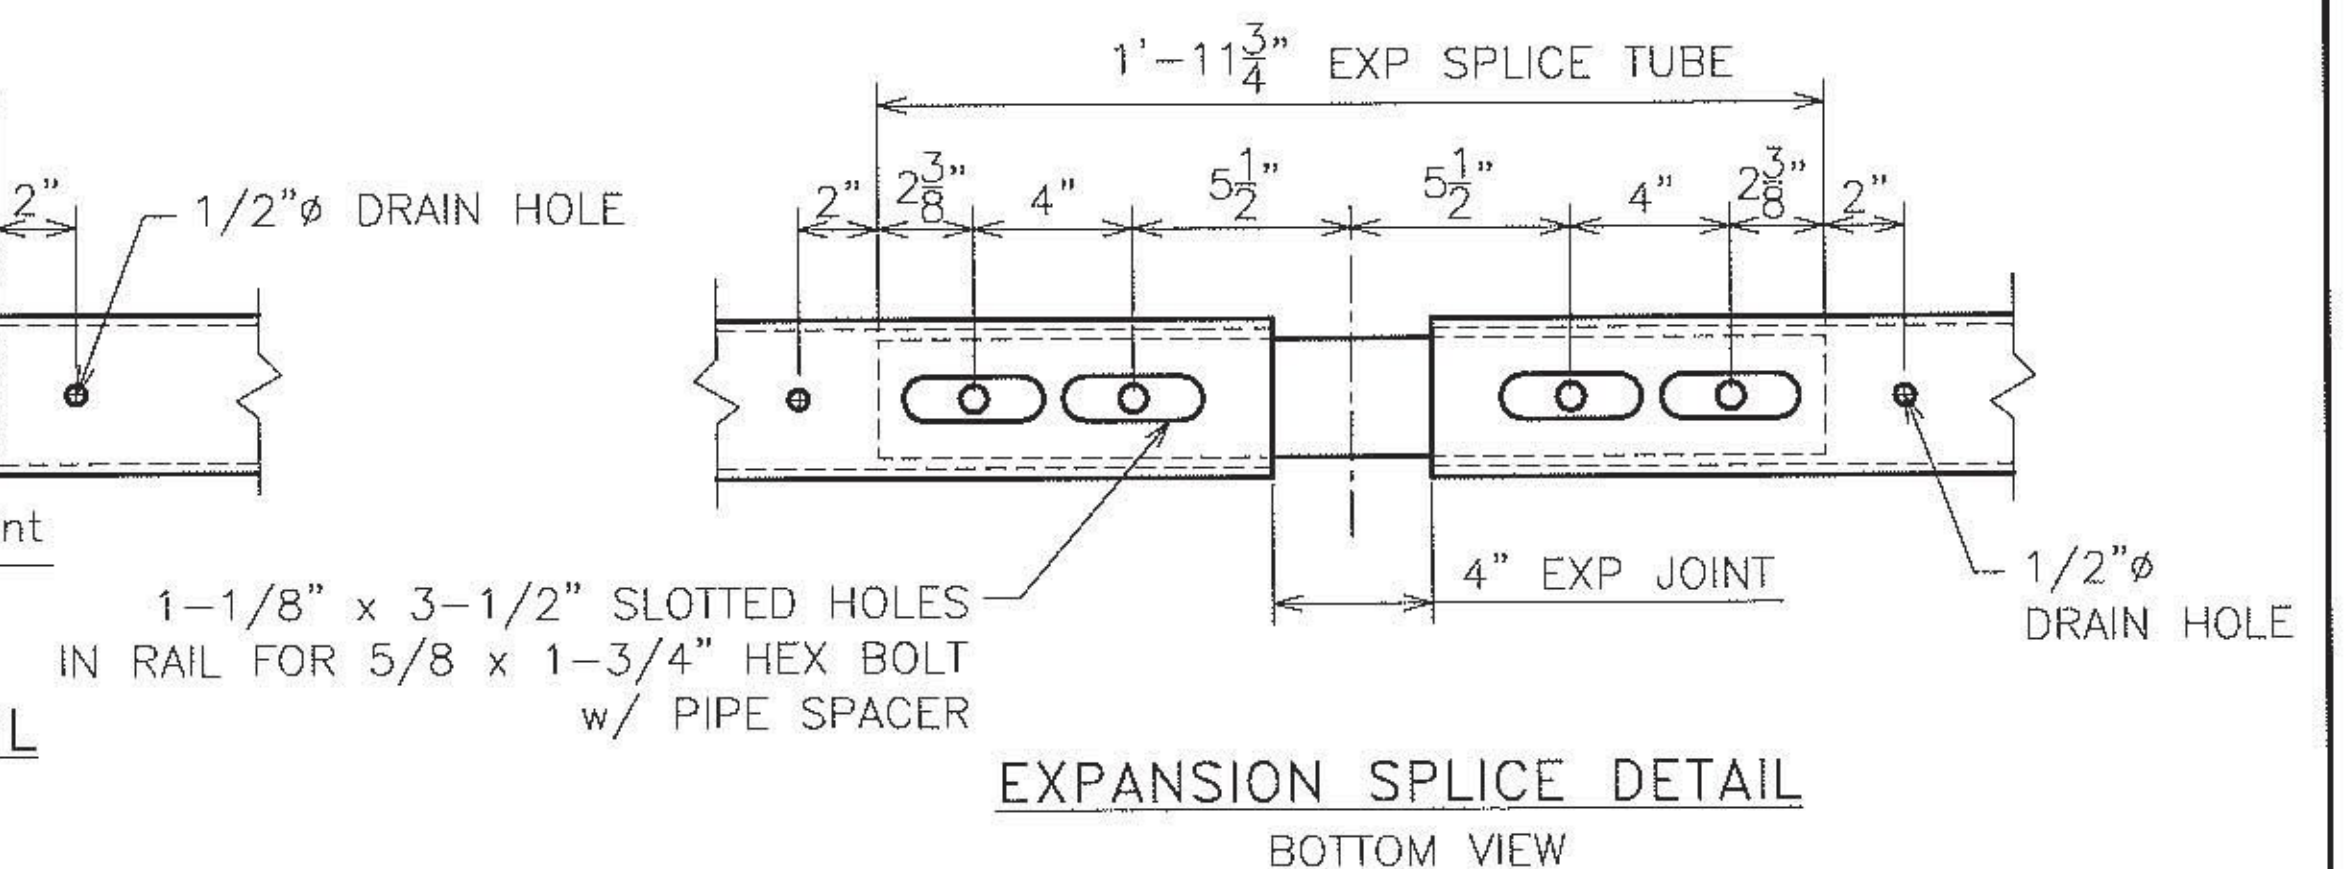
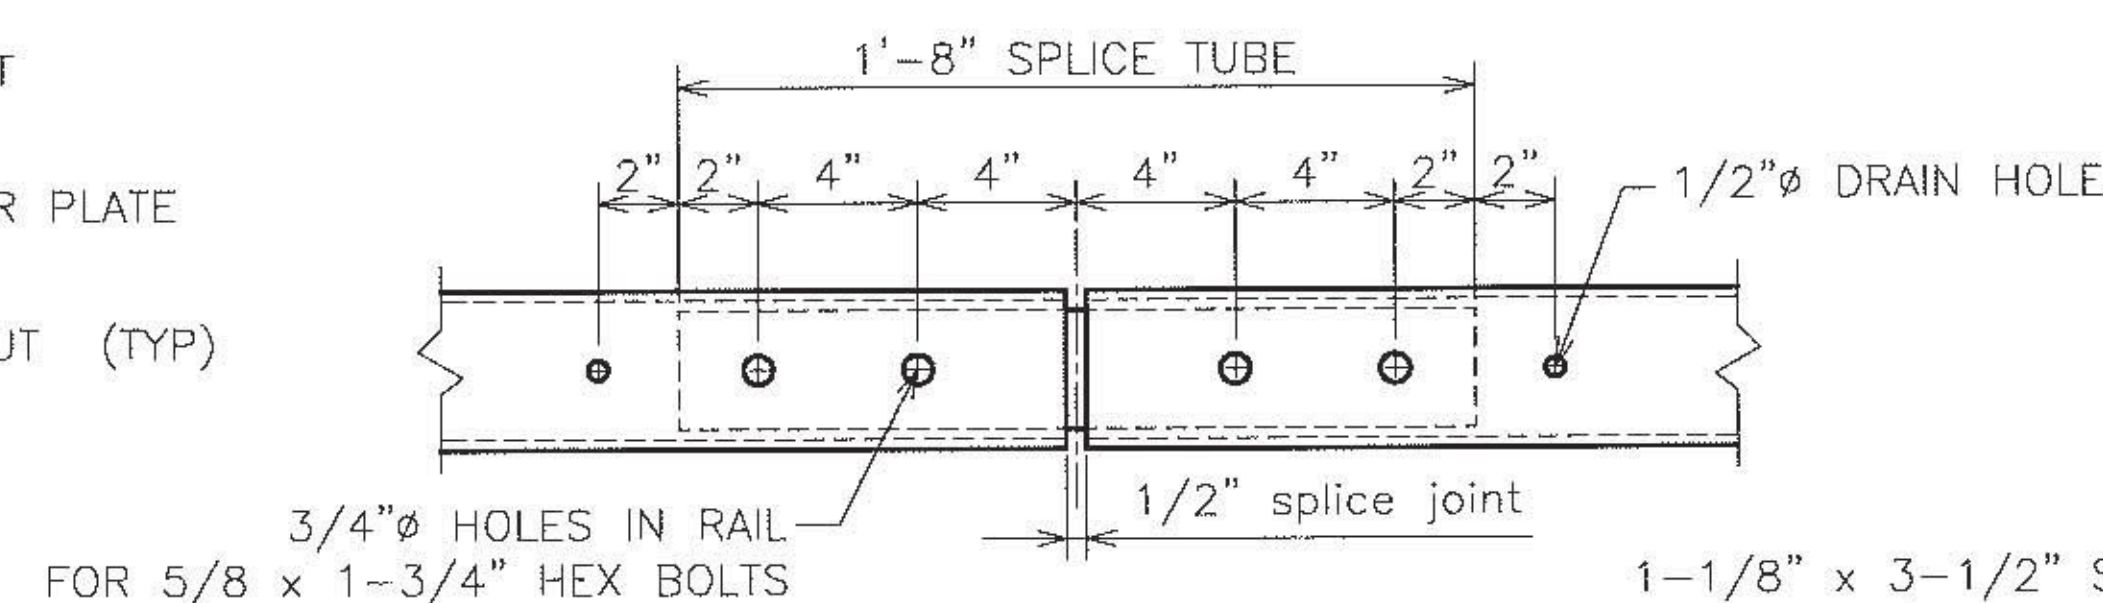
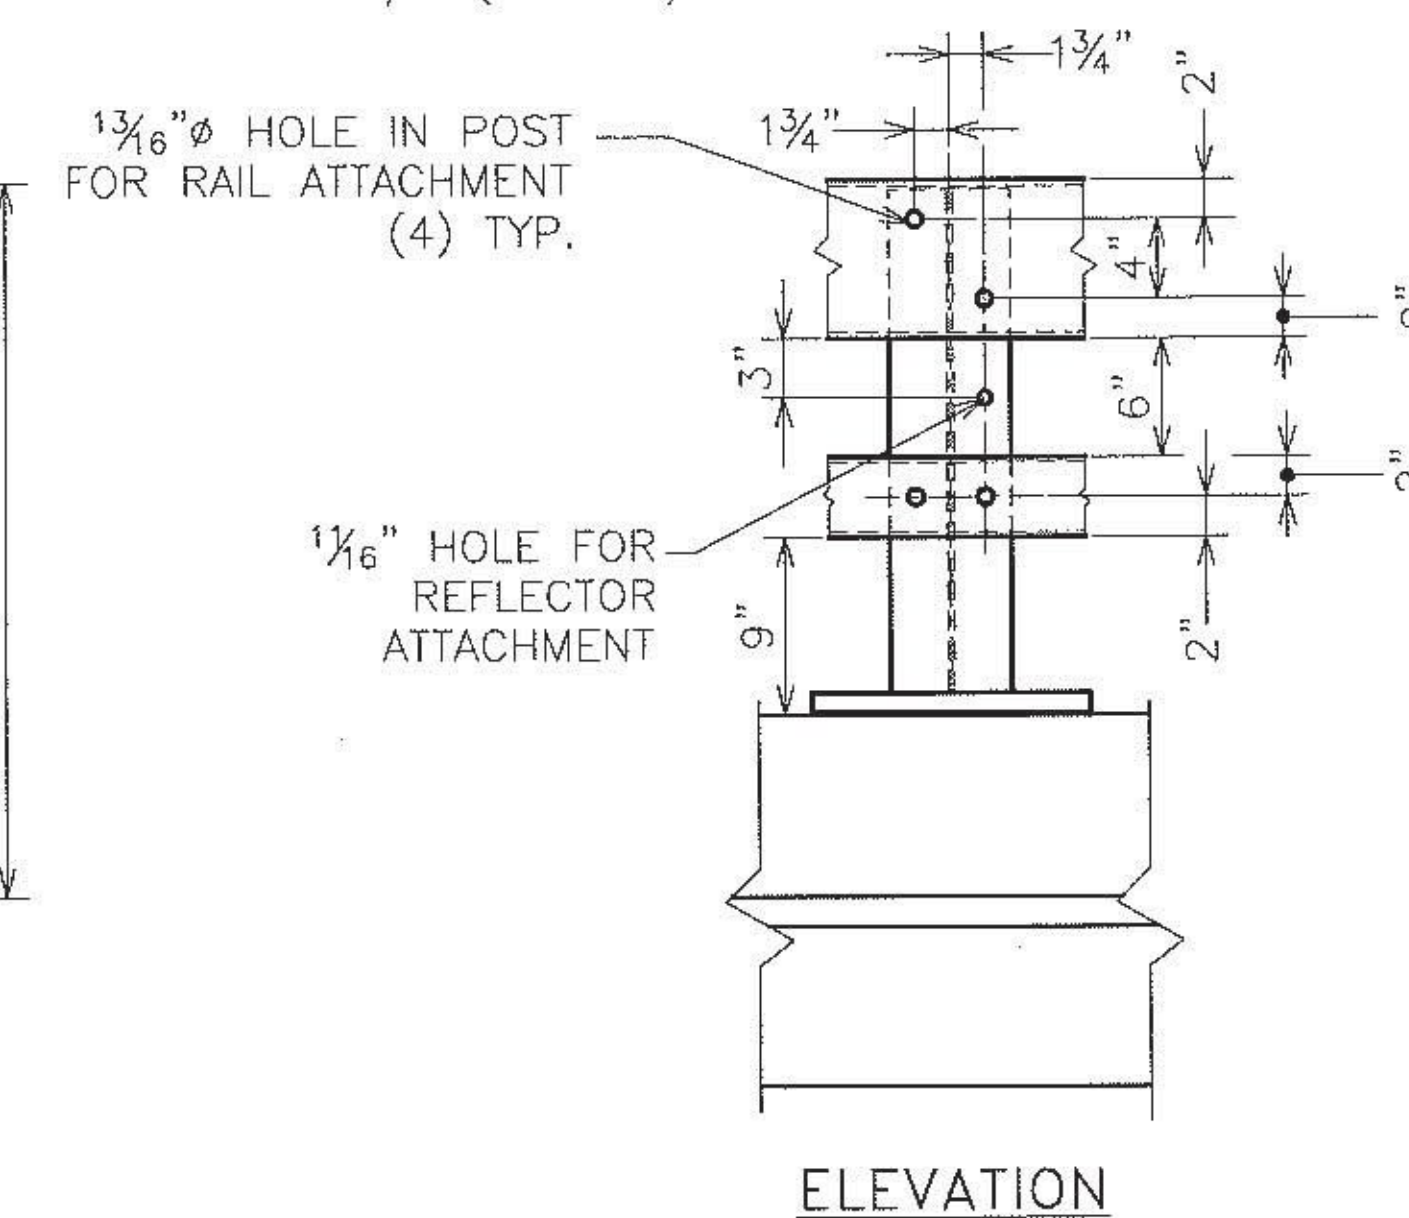
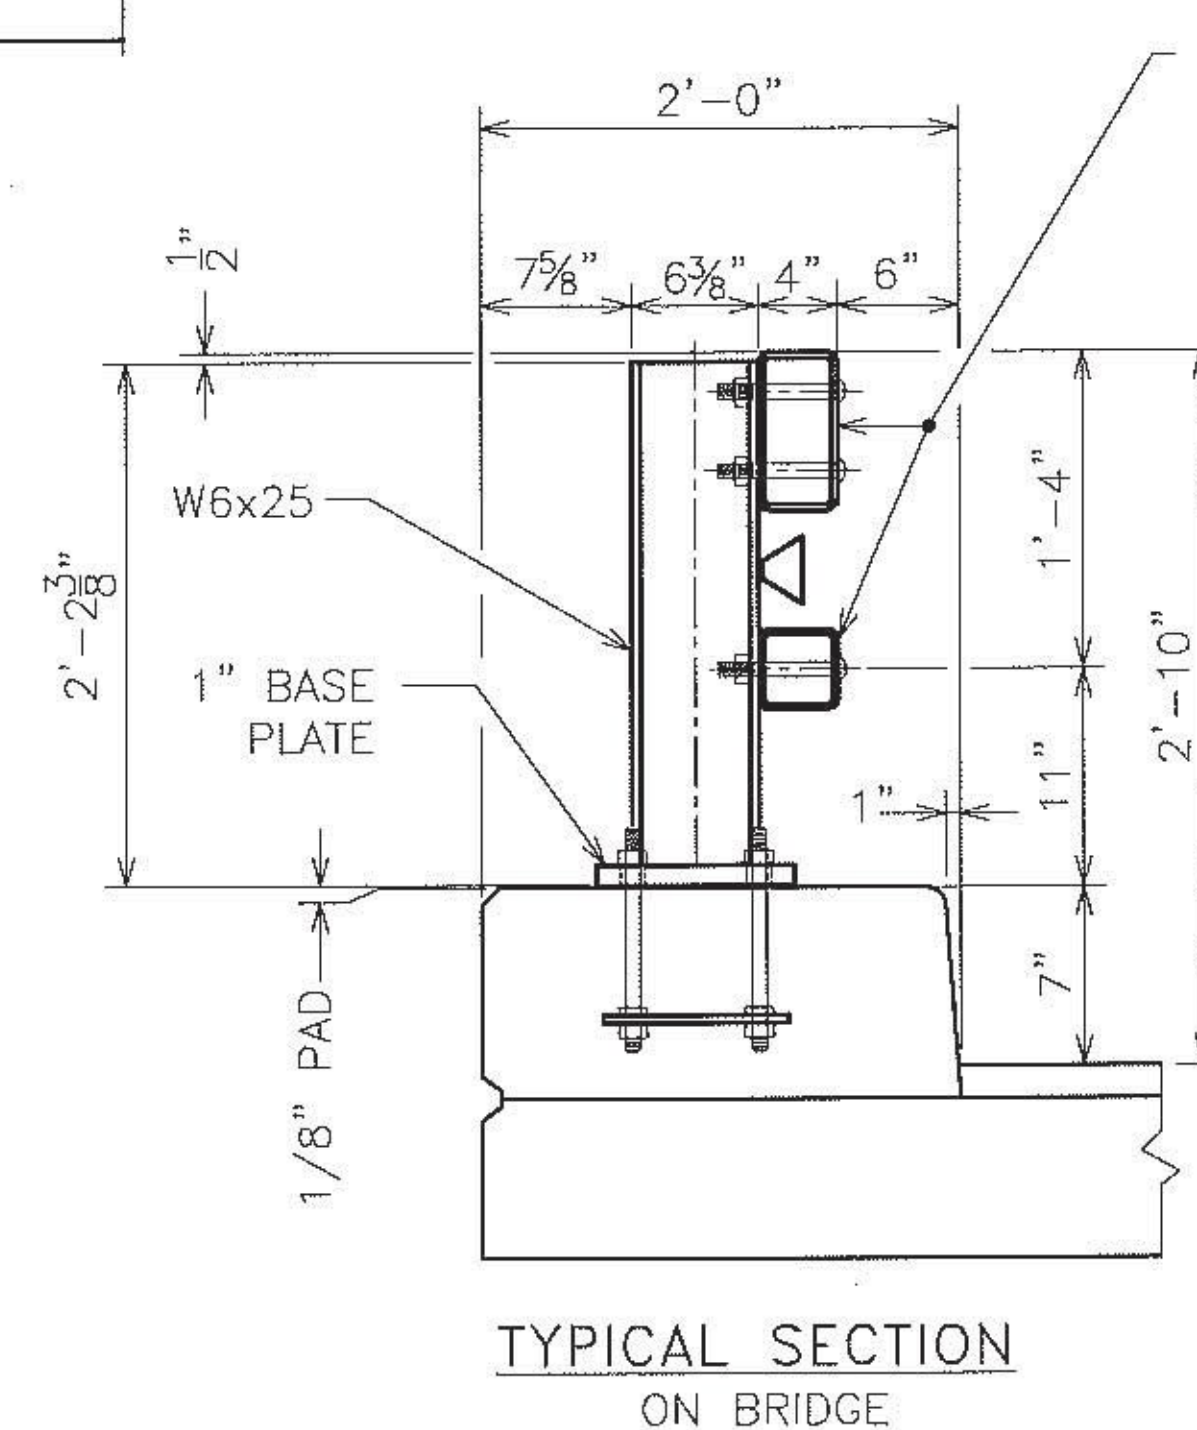
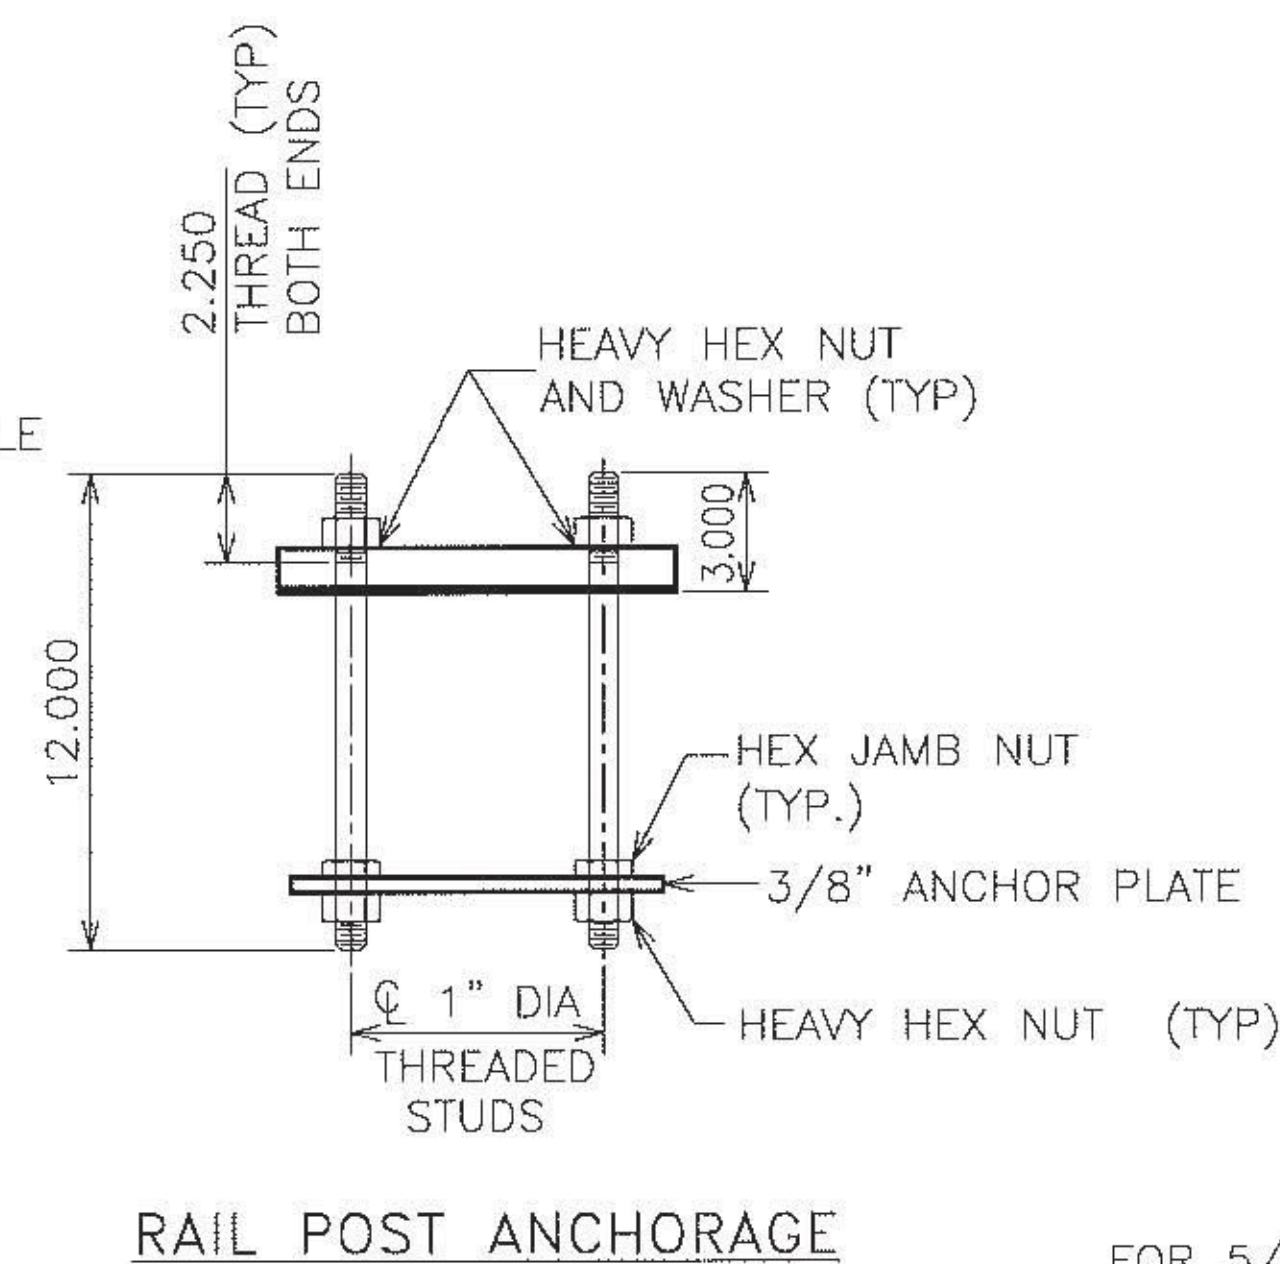
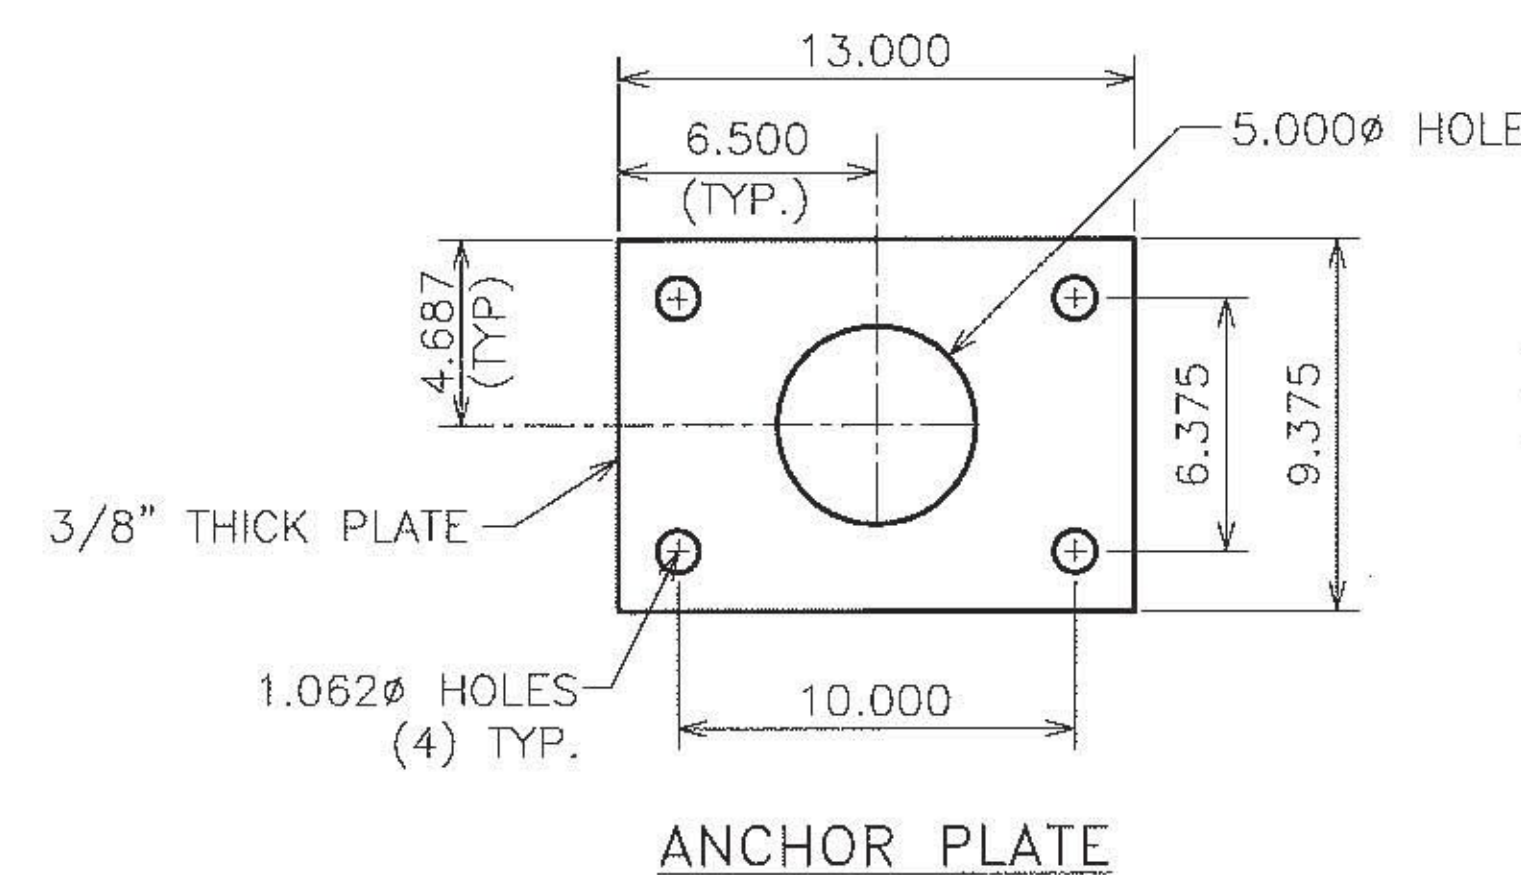
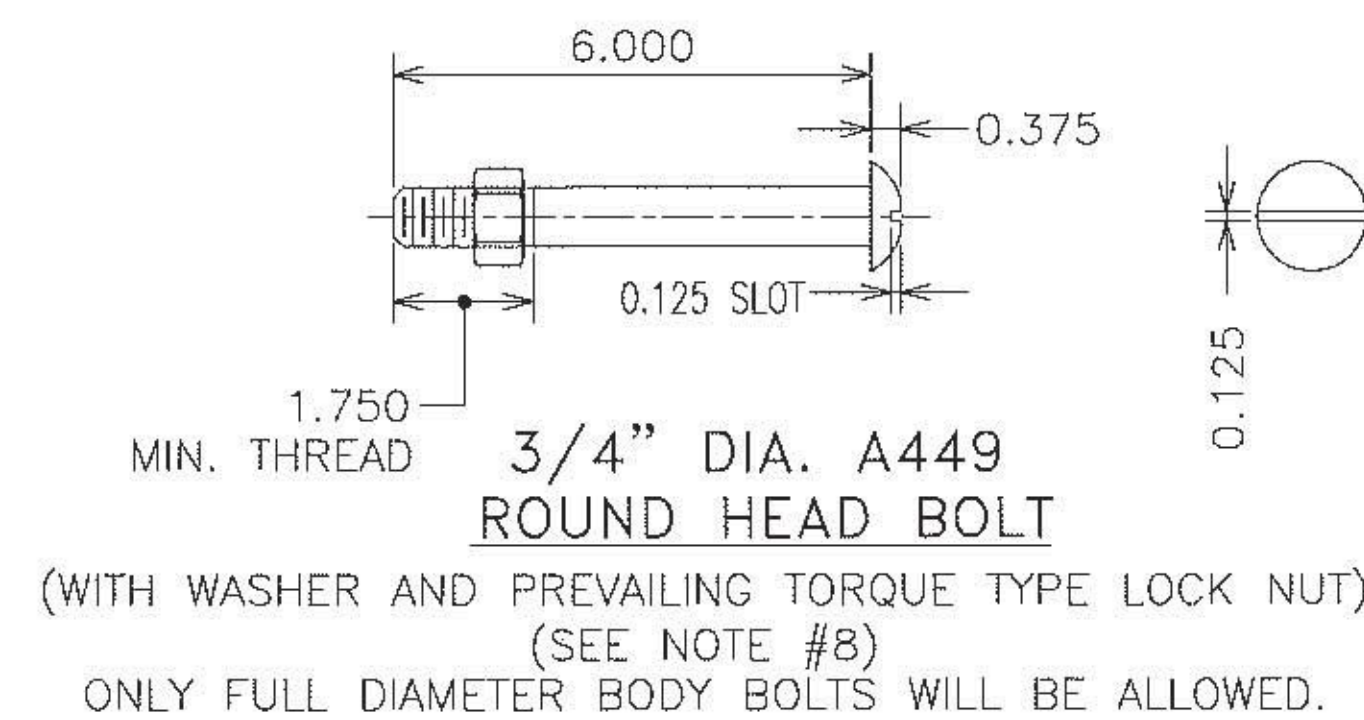
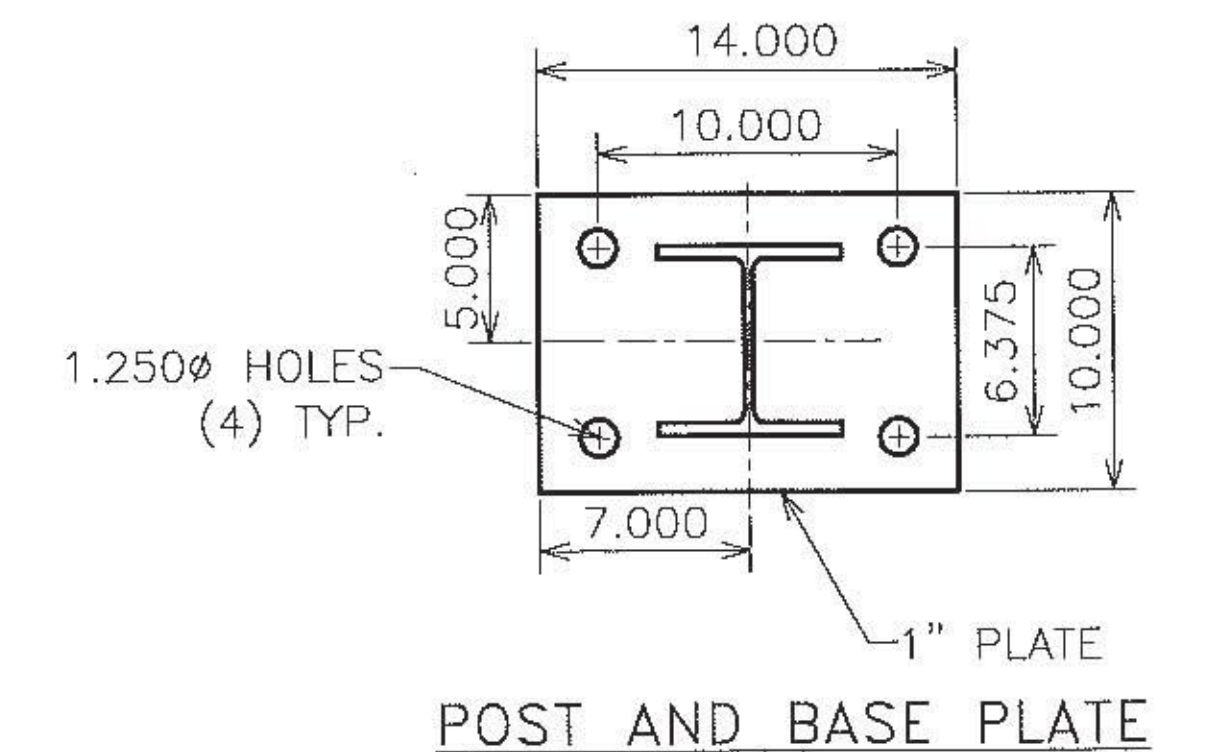
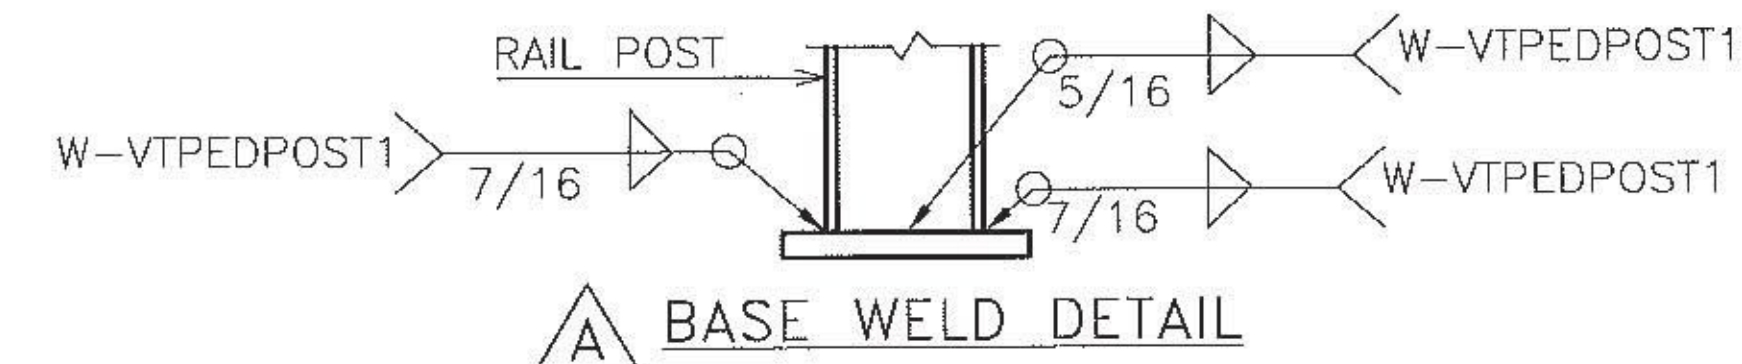


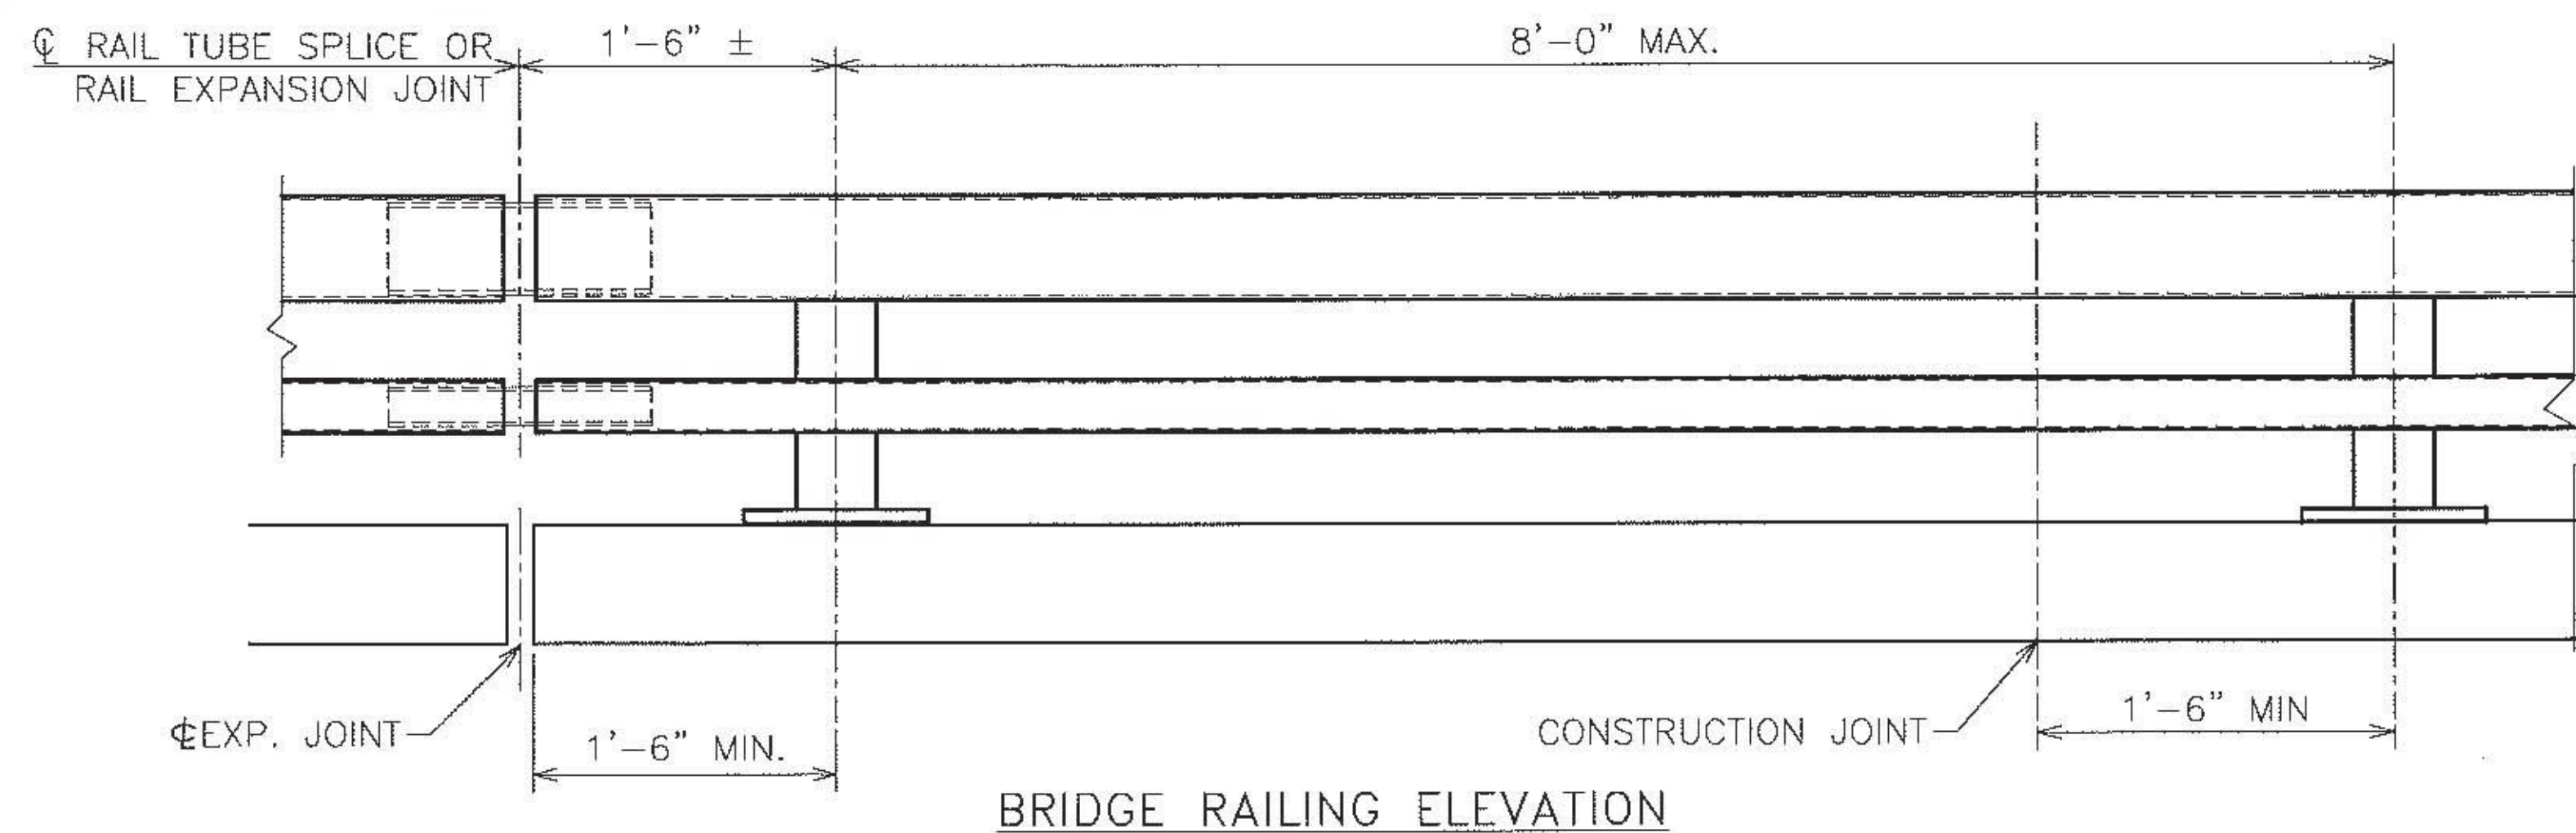

SHOP DRAWING REVIEW		
REVISIONS ARE REQUIRED BY THE ARCHITECT/CONSTRUCTION DOCUMENTS PREPARED BY:		
☐ APPROVED	AND APPROVED, BUT ONLY FOR CONFORMANCE TO THE DESIGN CONCEPT OF THE WORK, AND SUBJECT TO FURTHER LIMITATIONS AND REQUIREMENTS CONTAINED IN THE CONSTRUCTION CONTRACT DOCUMENTS.	
☐ REJECTED	☐ REVISE AND RESUBMIT	☒ APPROVED AS NOTED
CORRECTIONS OR COMMENTS MADE ON THE SHOP DRAWINGS DURING THIS REVIEW WILL NOT RELIEVE CONTRACTOR FROM COMPLIANCE WITH REQUIREMENTS OF THE DRAWINGS AND SPECIFICATIONS. THIS CHECK IS ONLY FOR REVIEW OF GENERAL CONFORMANCE WITH THE DESIGN CONCEPT OF THE PROJECT AND GENERAL COMPLIANCE WITH THE INFORMATION GIVEN IN THE CONTRACT DOCUMENTS. THE CONTRACTOR IS RESPONSIBLE FOR: CONFIRMING AND CORRELATING ALL QUANTITIES AND DIMENSIONS; SELECTING FABRICATION PROCESSES AND TECHNIQUES OF CONSTRUCTION; COORDINATING THEIR WORK WITH THAT OF ALL OTHER TRADES; AND PERFORMING THEIR WORK IN A SAFE AND SATISFACTORY MANNER.		
CLD Construction Engineers 540 Commercial Street Manchester, NH 03101 603-668-8223		Job Number: 55-0223 Reviewed by: NDC Date: 1/3/2017

		HIGHWAY SAFETY CORP	
GLASTONBURY, CT 860-633-9445			
ITEM 525.33 BRIDGE RAILING, GALVANIZED 2 RAIL BOX BEAM (S-360A) ITEM 621.72 GUARDRAIL APPROACH, GALV 2 RAIL BOX BEAM (S-360B)		 CERTIFIED FABRICATOR	
TOWN OF LUDLOW, VERMONT VT ROUTE 100 - (MINOR ARTERIAL) BRIDGE #99 WINDSOR COUNTY STP DECK (39)			
GENERAL CONTRACTOR		HSD JOB NO. 2141	
SUB CONTRACTOR		SHEET NO. 3 of 4	
DRAWN	PAR	CHECKED	DATE 10-20-16
SCALE		NONE	
SIZE		D	