
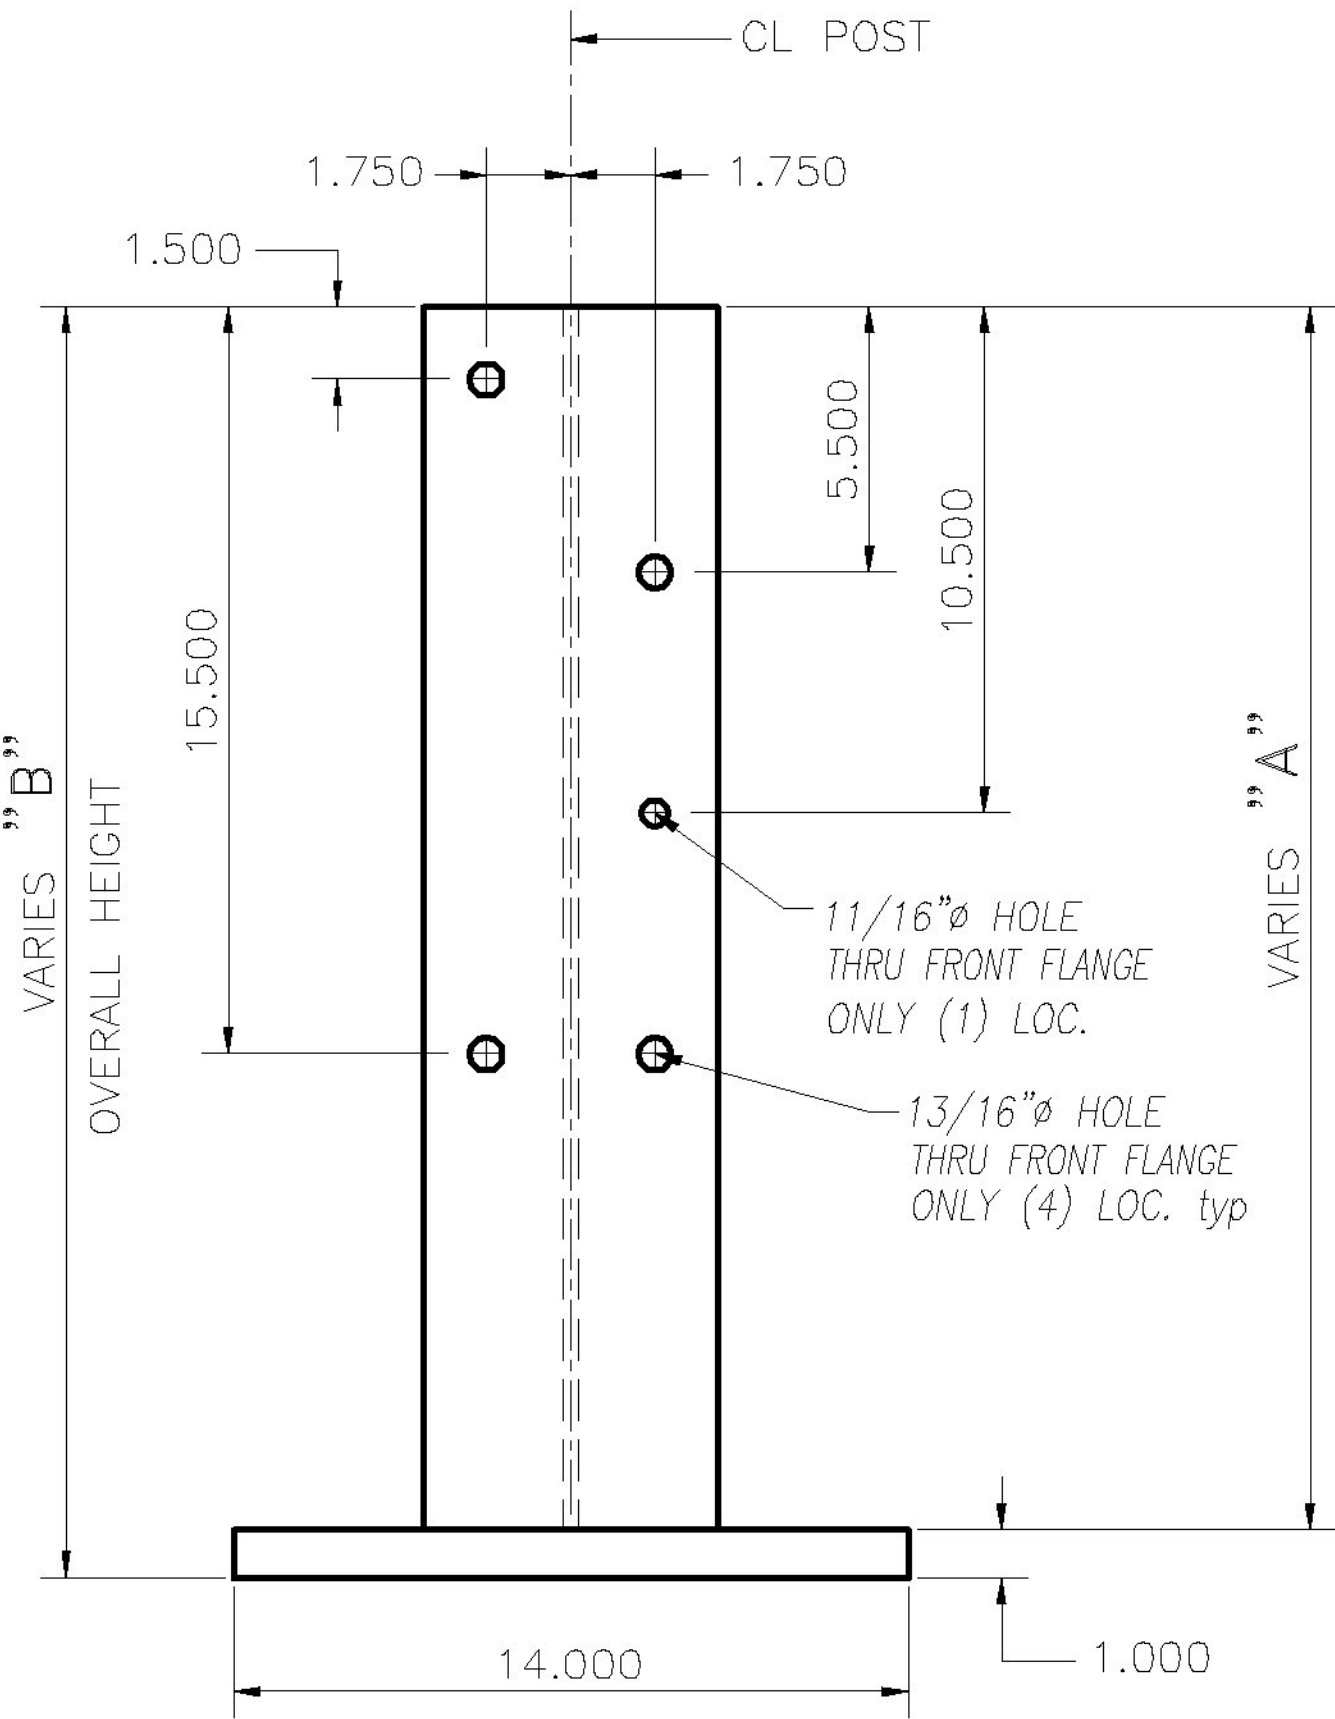


POST REPLACEMENT – refer to original approved shop drawing 2141 for additional notes & info

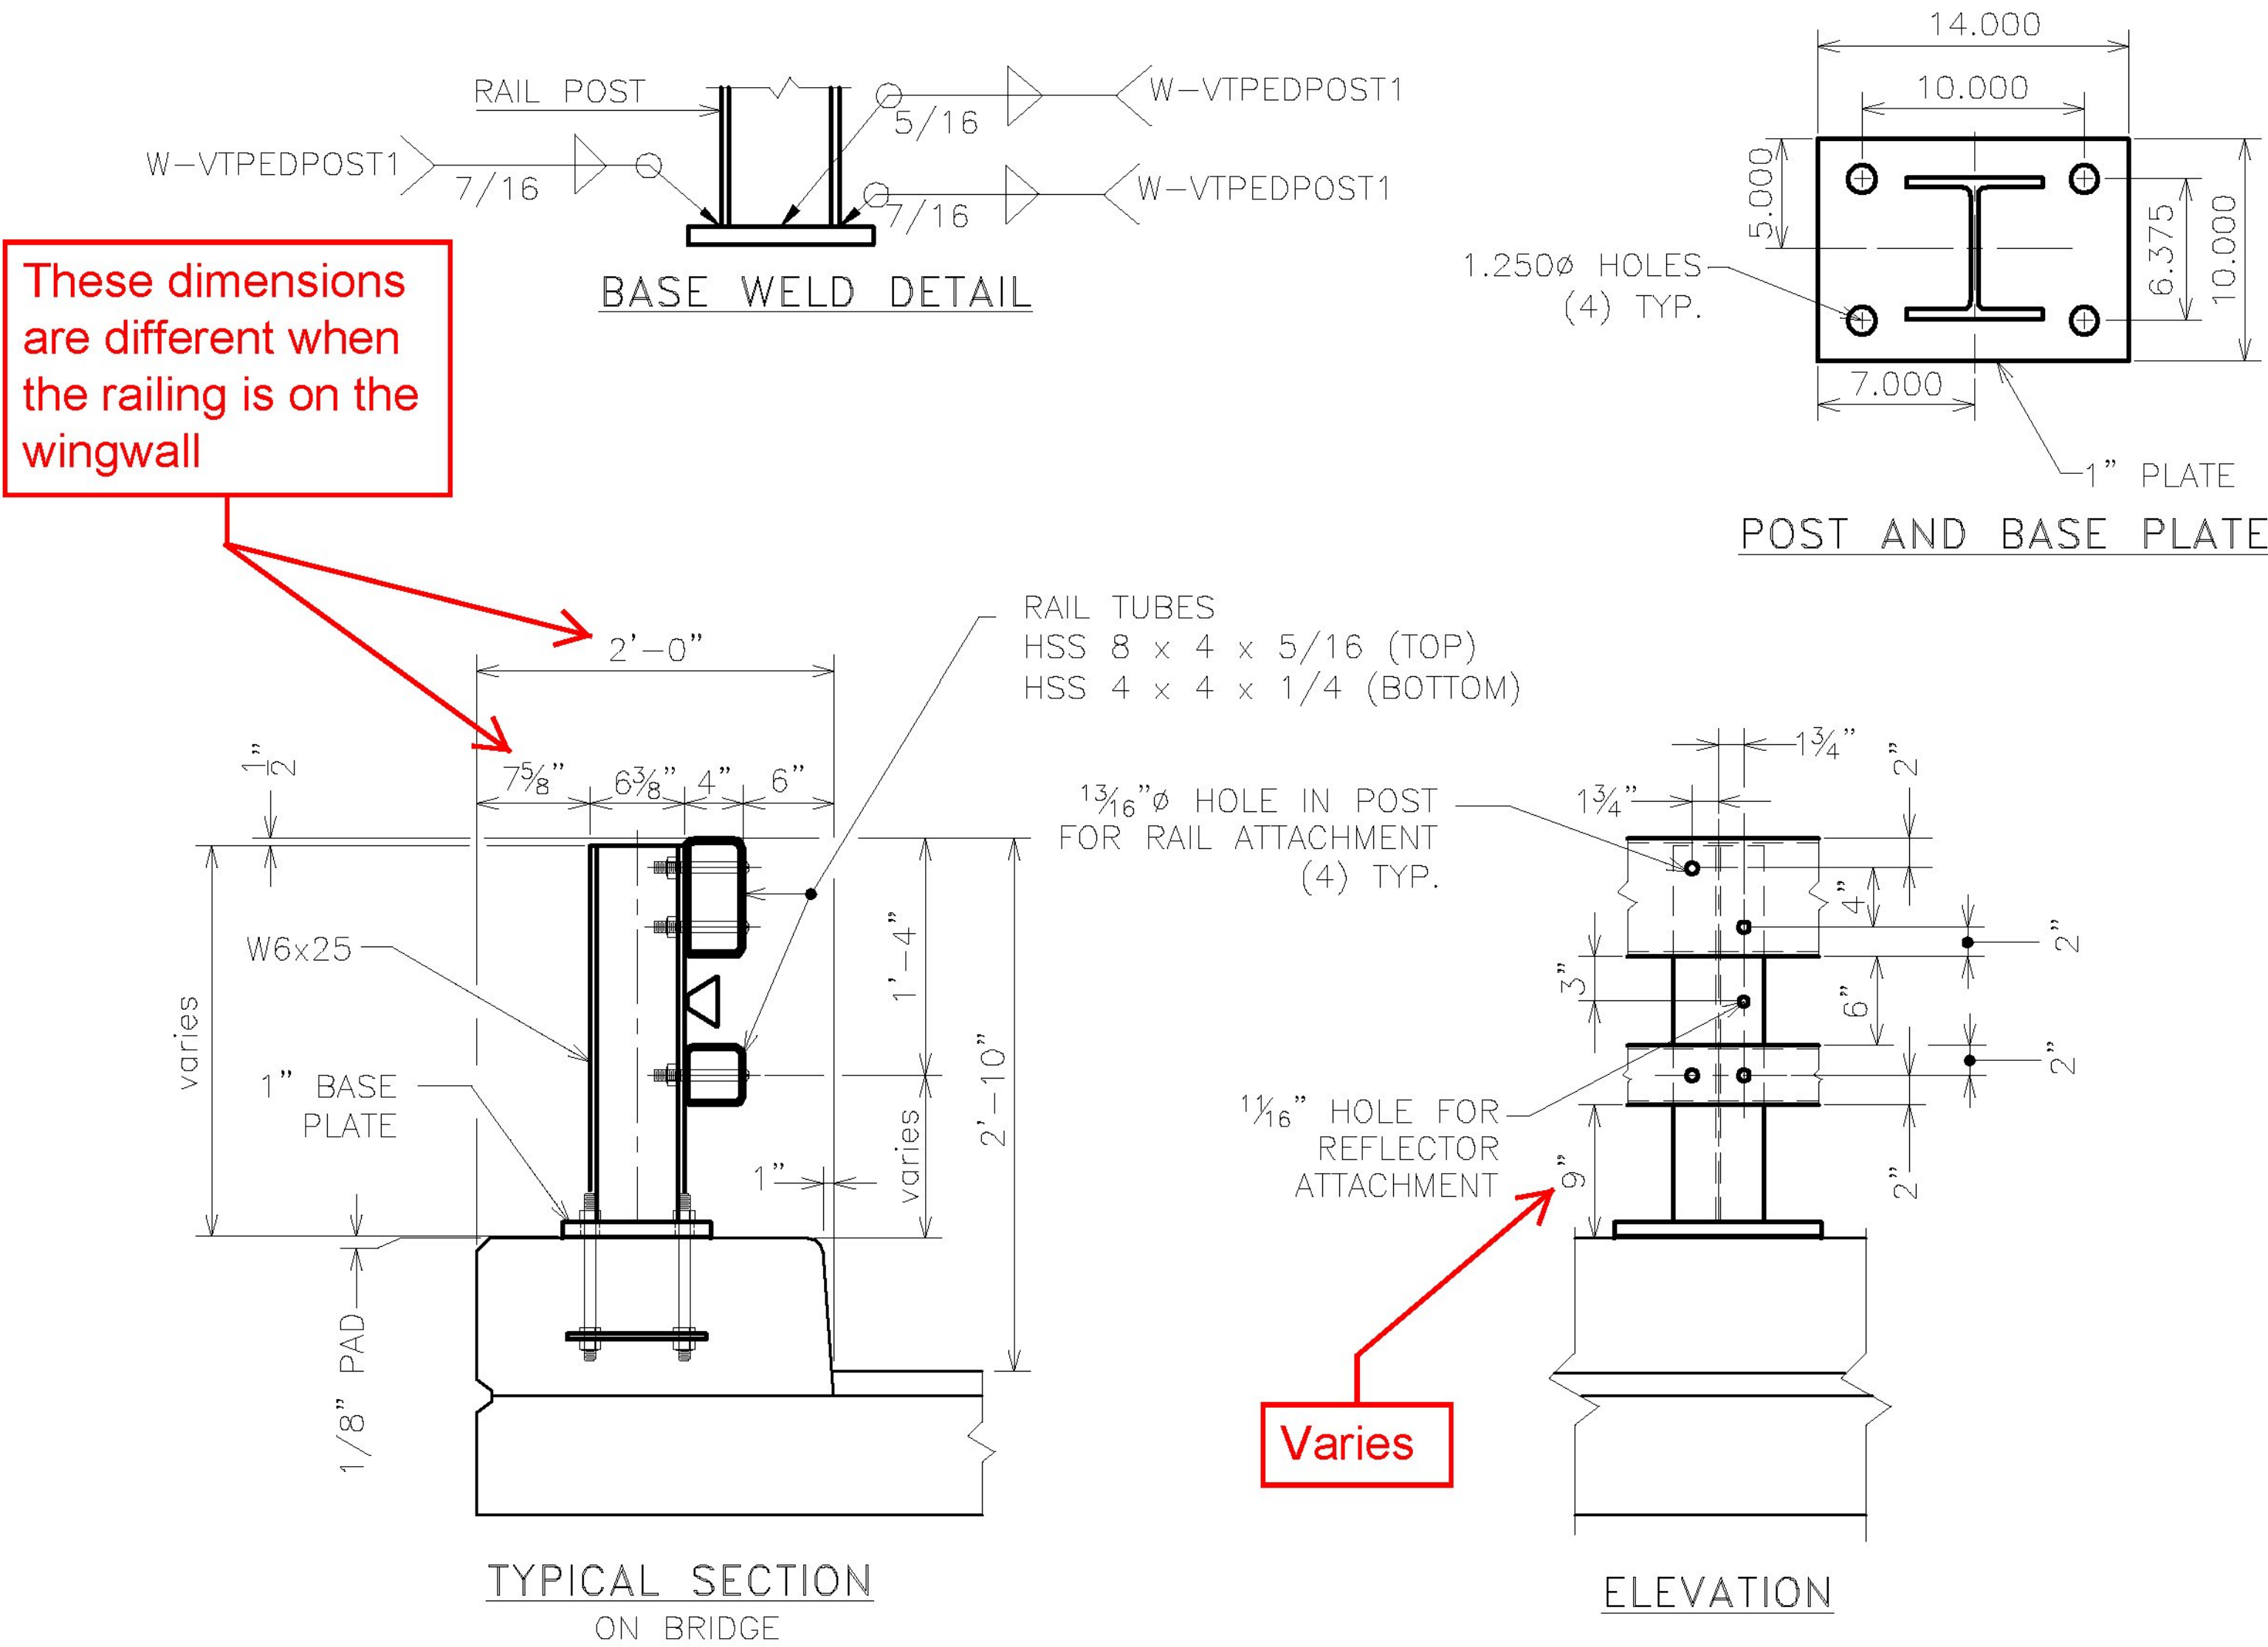

RAILING POST W6 x 25 x height varies w/ 1 x 10 x 14 BASE PLATE (GLV)

QTY	dim "A" post height	dim "B" OAH incl plate	MTL
1	21.750	22.750	A709 gr 50
3	22.875	23.875	A709 gr 50
1	23.000	24.000	A709 gr 50
1	23.500	24.500	A709 gr 50
1	23.625	24.625	A709 gr 50
1	24.000	25.000	A709 gr 50
1	24.125	25.125	A709 gr 50
1	24.375	25.375	A709 gr 50
2	24.625	25.625	A709 gr 50

Vermont Agency of Transportation
RECEIVED
CK'D BY CLD OK'D BY TAS
June 20, 2017
RESUBMIT no Approved AsNoted
BY Todd Sumner DATE 06/21/17

No.	Remarks	Date
0	Initial submittal	06-16-17
REVISIONS – APPLIES TO SET		

**HIGHWAY SAFETY CORP**
GLASTONBURY, CT
860-633-9445

ITEM 525.33 BRIDGE RAILING, GALVANIZED 2 RAIL BOX BEAM (S-360A)
ITEM 621.72 GUARDRAIL APPROACH, GALV 2 RAIL BOX BEAM (S-360B)
TOWN OF LUDLOW, VERMONT
VT ROUTE 100 – (MINOR ARTERIAL) BRIDGE #99
WINDSOR COUNTY STP DECK (39)

NSC CERTIFIED FABRICATOR
NSC JOB NO. 2141C
SHEET NO. 1 of 1

SUB CONTRACTOR LAFAYETTE
DRAWN PAR CHECKED rwl DATE 06-16-17 SCALE NONE SIZE D