


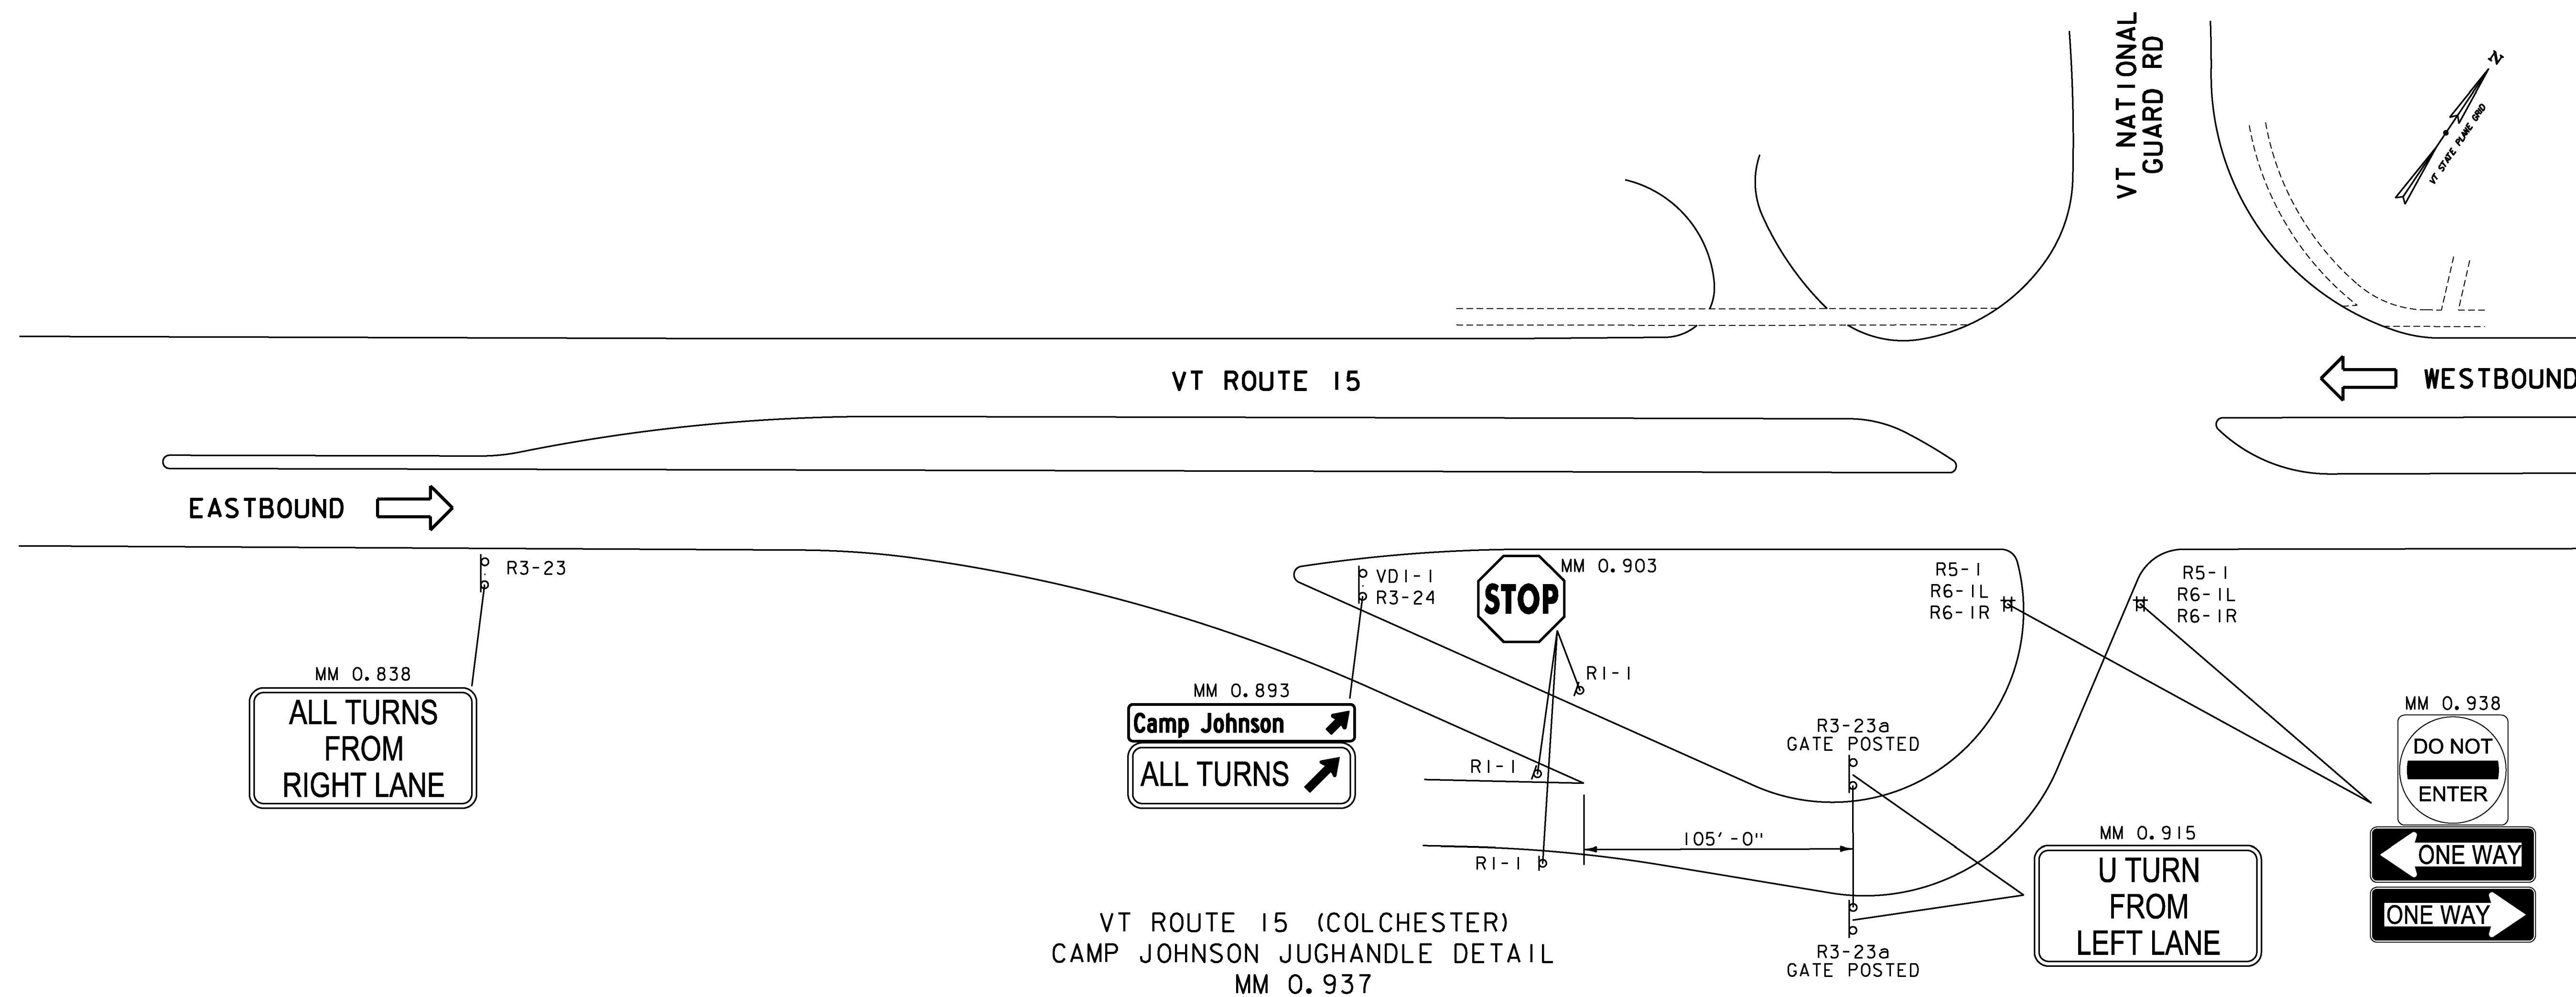

NOT TO SCALE

PROJECT NAME: WINOOSKI-CAMBRIDGE
PROJECT NUMBER: STPG SIGN(55)

FILE NAME: z15t006typ.dgn
PROJECT LEADER: M. FOISY
DESIGNED BY: G. BARRETT
TRAFFIC SIGN DETAILS SHEET 2

PLOT DATE: 6/14/2016
DRAWN BY: D. DRAPER
CHECKED BY: M. FOISY
SHEET 5 OF 192

