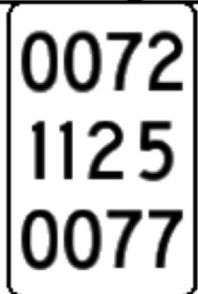


DIRECTION	MILEPOINT	LOCATION CODE (SHEET 4)	SIGN CODE	WIDTH (IN)	HEIGHT (IN)	SHEETING REMARKS	SIGN LEGEND	NEW SIGNS		EXISTING SIGNS				EXIST POST		NUMBER OF NEW POSTS	SQUARE STEEL (IN)			TUBULAR STEEL Ø (IN)				SIGN FRAME REQUIRED	REMARKS	SIGN DETAIL LOCATION							
								"A"	"B"	RETAIN	SALVAGE FROM	SALVAGE TO	REMOVE	RETAIN	REMOVE		1.75	2.00	2.50	FOUNDATION	3.00	3.50	4.00			5.00	SHSM	SIGN DETAILS SHEET #	STANDARD SHEET #				
																	(LB / FT)				(LB / FT)												
																	1.88	2.42	3.35		7.60	9.00	10.80			14.60							
NB CLARENDON VT ROUTE 7B							FY-FLUORESCENT YELLOW FYG-FLUORESCENT YELLOW GREEN															"SHSM"-STANDARD HIGHWAY SIGNS AND MARKINGS BOOK											
NB	0.000	C	VD-024	72	10			5.00								2		11'-3" 11'-0" X						INSTALL THIS ASSEMBLY CENTERED IN THE SAME POSITION AS THE EXISTING			T-94						
		C	VD-700	6	10			0.42																INSTALL CLARENDON MILE MARKER ON THE LEFT POST UNDER CLARENDON			T-44						
		C	VD-700	6	10			0.42																INSTALL WALLINGFORD MILE MARKER ON THE RIGHT POST UNDER WALLINGFORD			T-44						
NB	0.156	A					 HIDDEN TRUCK ENTRANCE LEFT						1		X																		
NB	0.194	A	VW-133L	30	30			6.25								1		10'-3" X						INSTALL 200' UPSTATION FROM EXISTING SIGN AT MP 0.156			T-81						
NB	0.211	A	W8-1				 BUMP			1				X										SEASONAL SIGN									
NB	0.696	A	W1-1L	30	30	FY		6.25								1		14'-9" X						INSTALL 160' UPSTATION FROM UTILITY POLE #42/8/58 AT MP 0.666 NB	X								
		A	W13-1P	18	18	FY		2.25																	X								
NB	0.821	A	W3-1										1	X																			
		A	W3-1	30	30			6.25																INSTALL ON RETAINED POST NOTE: PROJECT SUSPENDS HERE AT JUNCTION WITH U.S. 7	X								
NB	0.946	C					LOWER CLARENDON GORGE STATE PARK			1				X										NOTE: PROJECT RESUMES HERE AT JUNCTION WITH U.S. 7									
		C					 AREA CLOSED FROM DUSK UNTIL DAWN			1																							
NB	0.956	C	VR-017	24	30			5.00								1		12'-0" X						INSTALL SIGN ON THE EAST SOUTH SIDE OF TH PER T-56			T-70						
NB	0.961	D	R1-1				STOP						1	X	X																		
		C	VR-017				LLL 24,000 LBS						1																				
SIGN SUMMARY SHEET							SHEET TOTALS	31.83	0.00	3	0	0	4	0	0	5		75.0		0	0.0	0.0	0.0	0.0	PROJECT NAME: STATEWIDE-SOUTH REGION	PROJECT MANAGER: D. MUNRO							
								SF	SF	EA	EA	EA	EA	EA	EA	EA		FT		EA	LB	LB	LB	LB									
							VERMONT AGENCY OF TRANSPORTATION							TOWN DIRECTIONAL TOTALS	202.9	0.0	5	0	0	40	0	0	27		370.0		2		288.0	FILE NAME: z16t041Clarendon7B NB.xls	PLOT DATE: 2/27/2017		
																							CLARENDON VT-7B NB 1	CHECKED: W. GORDON	SHEET 20 OF 264								