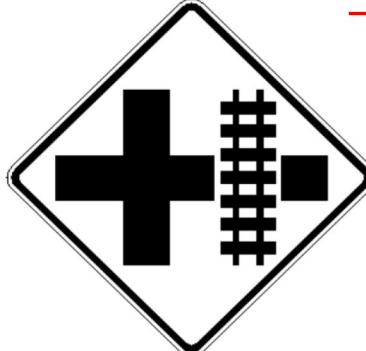


DIRECTION	MILEPOINT	LOCATION CODE (SHEET 4)	SIGN CODE	WIDTH (IN)	HEIGHT (IN)	SHEETING REMARKS	SIGN LEGEND	NEW SIGNS		EXISTING SIGNS				EXIST POST		NUMBER OF NEW POSTS	SQUARE STEEL (IN)			TUBULAR STEEL Ø (IN)				SIGN FRAME REQUIRED	REMARKS	SIGN DETAIL LOCATION			
								"A"	"B"	RETAIN	SALVAGE FROM	SALVAGE TO	REMOVE	RETAIN	REMOVE		1.75	2.00	2.50	FOUNDATION	3.00	3.50	4.00			5.00	SHSM	SIGN DETAILS SHEET #	STANDARD SHEET #
																	(LB / FT)				(LB / FT)								
																	1.88	2.42	3.35		7.60	9.00	10.80			14.60			
SB MOUNT HOLLY VT 103							FY-FLUORESCENT YELLOW FYG-FLUORESCENT YELLOW GREEN															"SHSM"-STANDARD HIGHWAY SIGNS AND MARKINGS BOOK							
		F	W11-8	30	30		 9/7/17	6.25															INSTALL ON RETAINED RIGHT POST	X					
		F	VD-700				MILE MARKER 1030 / 1112 / 0540					1														T-44			
SB	5.346	A	W10-2	36	36		 4/9/18	9.00							2		X						INSTALL 200 FT ± SOUTH OF EXISTING SIGN AT MP 5.384 SB	X					
		A	W16-8aP	51	15			5.31																	5				
SB	5.297	F	VD2-1S				MOUNT HOLLY --> SCHOOL						1		X														
		F	VD1-1A				BELMONT 2 -->						1																
		F	VD1-1A				<-- HORTONVILLE 2						1																
SB	5.289	F	VD2-1S	72	20		 2 9/7/17	10.00							2		16'-6" 14'-6" X						INSTALL SIGN BEHIND GUARDRAIL, 40' DOWNSTATION FROM EXISTING SIGN AT MP 5.297 SB				T-93		
		F	VD1-1A	72	12		 →	6.00																		T-93			
		F	VD1-1A	72	12		 2 →	6.00																		T-93			
SB	5.269	G	W10-1				 2 → 4/9/18 GRADE CROSSING ADVANCE WARNING						1		X														
SB	5.270	G	VR-017				 8/18/17						1		X								BELMONT RD (TH-1)						
		G	VR-017	24	30			5.00							1		13'-9" X						INSTALL NEW SIGN AT SAME LOCATION ON BELMONT RD				T-70		
SB	5.251	H	R1-1				STOP						1	X	✖														
		G	VD-700				MILE MARKER 1030 / 1112 / 0528					1																	
SIGN SUMMARY SHEET							SHEET TOTALS	47.56	0.00	1	0	1	6	0	0	5		75.0		0	0.0	0.0	0.0	0.0	PROJECT NAME: STATEWIDE-SOUTH REGION	PROJECT NUMBER: STPG SIGN(57)			
								SF	SF	EA	EA	EA	EA	EA	EA	EA		FT		EA	LB	LB	LB	LB					
							VERMONT AGENCY OF TRANSPORTATION							TOWN DIRECTIONAL TOTALS	367.7	0.0	11	4	5	82	0	0	41		585.0		0		0.0
																								PROJECT MANAGER: D. MUNRO	DRAWN BY: W. GORDON				
																									DESIGNED BY: P. MCKECHNIE	CHECKED: BRZEZOWSKI			
																								MOUNT HOLLY VT-103 SB 5	SHEET 101 OF 264				