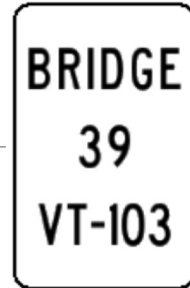
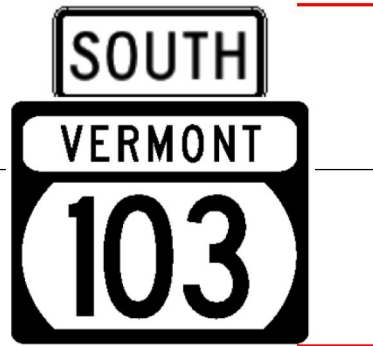
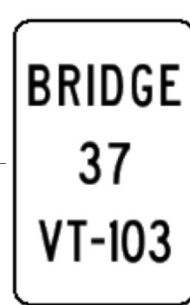


DIRECTION	MILEPOINT	LOCATION CODE (SHEET 4)	SIGN CODE	WIDTH (IN)	HEIGHT (IN)	SHEETING REMARKS	SIGN LEGEND	NEW SIGNS		EXISTING SIGNS				EXIST POST		NUMBER OF NEW POSTS	SQUARE STEEL (IN)			TUBULAR STEEL Ø (IN)				SIGN FRAME REQUIRED	REMARKS	SIGN DETAIL LOCATION					
								"A"	"B"	RETAIN	SALVAGE FROM	SALVAGE TO	REMOVE	RETAIN	REMOVE		1.75	2.00	2.50	FOUNDATION	3.00	3.50	4.00			5.00	SHSM	SIGN DETAILS SHEET #	STANDARD SHEET #		
																	(LB / FT)				(LB / FT)										
																	1.88	2.42	3.35		7.60	9.00	10.80			14.60					
SB MOUNT HOLLY VT 103							FY-FLUORESCENT YELLOW FYG-FLUORESCENT YELLOW GREEN															"SHSM"-STANDARD HIGHWAY SIGNS AND MARKINGS BOOK									
		H	R1-1	30	30			6.25															INSTALL ON RETAINED POST	X							
SB	5.244	EF	D3-1				Belmont Rd TH1			1				X																	
SB	5.243	G	W10-1				GRADE CROSSING ADVANCE WARNING						1		X																
SB	5.239	F	VD-701				 4/9/18						1	X																	
		F	VD-701	6	10			0.42																	T-42						
SB	5.229	F	M3-3										1	X																	
		F	VM1-5				 8/22/17						1																		
		F	M3-3	24	12			2.00																INSTALL ON RETAINED POST SOUTH, GREEN ON WHITE	X						
		F	VM1-5	30	24			5.00																	E-136						
SB	5.184	F	R2-1				 8/22/17						1	X																	
		F	R2-1	24	30			5.00																INSTALL ON RETAINED POST	X						
SB	5.109	F	VD-701				 8/22/17						1	X																	
		F	VD-701	6	10			0.42																	T-42						
SB	4.639	F	VD-701				 8/22/17						1	X																	
		F	VD-701	6	10			0.42																	T-42						
SIGN SUMMARY SHEET							SHEET TOTALS	19.50	0.00	1	0	0	7	0	0	1		15.0		0	0.0	0.0	0.0	0.0	PROJECT NAME: STATEWIDE-SOUTH REGION	PROJECT NUMBER: STPG SIGN(57)					
								SF	SF	EA	EA	EA	EA	EA	EA	EA		FT		EA	LB	LB	LB	LB							
							VERMONT AGENCY OF TRANSPORTATION																					FILE NAME: z16t041Mt Hollyv103 SB.xls	PLOT DATE: 2/27/2017		
							TOWN DIRECTIONAL TOTALS							367.7	0.0	11	4	5	82	0	0	41		585.0		0		0.0		PROJECT MANAGER: D. MUNRO	DRAWN BY: W. GORDON
																							DESIGNED BY: P. MCKECHNIE	CHECKED BRZEWOSKI							
																							MOUNT HOLLY VT-103 SB 6	SHEET 102 OF 264							