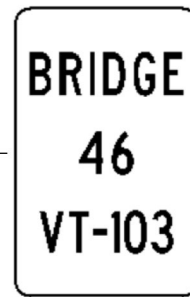


DIRECTION	MILEPOINT	LOCATION CODE (SHEET 4)	SIGN CODE	WIDTH (IN)	HEIGHT (IN)	SHEETING REMARKS	SIGN LEGEND	NEW SIGNS		EXISTING SIGNS				EXIST POST		NUMBER OF NEW POSTS	SQUARE STEEL (IN)			TUBULAR STEEL Ø (IN)				SIGN FRAME REQUIRED	REMARKS	SIGN DETAIL LOCATION					
								"A"	"B"	RETAIN	SALVAGE FROM	SALVAGE TO	REMOVE	RETAIN	REMOVE		1.75	2.00	2.50	FOUNDATION	3.00	3.50	4.00			5.00	SHSM	SIGN DETAILS SHEET #	STANDARD SHEET #		
																	(LB / FT)				(LB / FT)										
																	1.88	2.42	3.35		7.60	9.00	10.80			14.60					
NB WALLINGFORD VT RTE 103							FY-FLUORESCENT YELLOW FYG-FLUORESCENT YELLOW GREEN															"SHSM"-STANDARD HIGHWAY SIGNS AND MARKINGS BOOK									
NB	0.301	A	VD-701				 9/11/17					1	X																		
		A	VD-701	6	10			0.42																INSTALL ON RETAINED POST			T-42				
NB	0.317	A	R2-1	24	30		 9/11/17	5.00							1		12'-3" X							INSTALL ±85 FT UPSTATION OF EXISTING SIGN AT MP 0.301 NB	X						
NB	0.320																						REMOVE POST STUB. PAID FOR AS ITEM 675.12, REMOVING DELINEATORS.								
NB	0.340	A	VW-133R	30	30		 9/11/17	6.25							1		12'-6" X										T-81				
NB	0.366	A	VW-619				 9/11/17					1	X	X										REMOVE LEFT POST RETAIN RIGHT POST							
		A	VW-619	30	30			6.25																INSTALL ON RETAINED POST			T-82				
NB	0.391	A	D3-1							1				X																	
NB	0.481	A	VD2-1							1				X																	
NB	0.846	A	W8-1							1				X										SEASONAL SIGN							
NB	1.036																						REMOVE FLASHING BEACON AND ELECTRIC POWER METER AFTER DISCONNECTING FROM THE POWER SOURCE. PAYMENT WILL BE MADE UNDER CONTRACT ITEM 960.620 SPECIAL PROVISION (REMOVE ELECTRIC POWER METER AND FLASHING BEACON).								
		A	W1-1R																												
		A	W13-1P																												
NB	1.102	A	W1-2R	30	30	FY	 9/14/17	6.25							1		14'-0" X							INSTALL SIGN 350' NORTH OF EXISTING SIGN AT MP 1.036 NB	X						
		A	W13-1P	18	18	FY		2.25																	X						
SIGN SUMMARY SHEET							SHEET TOTALS	26.42	0.00	3	0	0	5	0	0	2		30.0		0	0.0	0.0	0.0	0.0	PROJECT NAME: STATEWIDE-SOUTH REGION	PROJECT NUMBER: STPG SIGN(57)					
								SF	SF	EA	EA	EA	EA	EA	EA	EA		FT		EA	LB	LB	LB	LB							
							VERMONT AGENCY OF TRANSPORTATION																					FILE NAME: z16t041Wallinaford103 NB.xls	PLOT DATE: 2/27/2017		
														TOWN DIRECTIONAL TOTALS	173.8	0.0	14	1	1	33	0	0	23		335.0		0		0.0		
																							DESIGNED BY: P. MCKECHNIE	CHECKED: BRZEZOWSKI							
																							WALLINGFORD VT-103 NB 3	SHEET 112 OF 264							