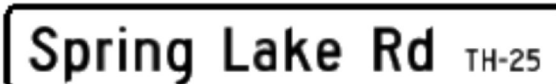


DIRECTION	MILEPOINT	LOCATION CODE (SHEET 4)	SIGN CODE	WIDTH (IN)	HEIGHT (IN)	SHEETING REMARKS	SIGN LEGEND	NEW SIGNS		EXISTING SIGNS				EXIST POST		NUMBER OF NEW POSTS	SQUARE STEEL (IN)			TUBULAR STEEL Ø (IN)				SIGN FRAME REQUIRED	REMARKS	SIGN DETAIL LOCATION			
								"A"	"B"	RETAIN	SALVAGE FROM	SALVAGE TO	REMOVE	RETAIN	REMOVE		1.75	2.00	2.50	FOUNDATION	3.00	3.50	4.00			5.00	SHSM	SIGN DETAILS SHEET #	STANDARD SHEET #
																	(LB / FT)				(LB / FT)								
																	1.88	2.42	3.35		7.60	9.00	10.80			14.60			
SB SHREWSBURY VT ROUTE 103							FY-FLUORESCENT YELLOW FYG-FLUORESCENT YELLOW GREEN															"SHSM"-STANDARD HIGHWAY SIGNS AND MARKINGS BOOK							
SB	1.512	G	VR-017				 9/15/17					1	X																
		G	VR-017	24	30			5.00																INSTALL ON RETAINED POST			T-70		
SB	1.502	FE	D3-1				SPRING LAKE RD TH-25					1		X															
		H	R1-1				STOP					1																	
		G	VD-700				MILE MARKER 1030 / 1122 / 0154			1		1																	
		H	R1-1	30	30		 9/15/17	6.25							1		12'-9" X								X				
		G	VD-700				MILE MARKER 1030 / 1122 / 0154				1													INSTALL BACK TO BACK ON STOP SIGN POST					
SB	1.502	FE	D3-1	68	12		 12/1/17	5.67							2		10'-9" 9'-3" X								INSTALL INDEPENDENTLY ON SEPARATE POSTS		7		
SB	1.148	F	R2-5A				 9/15/17					1		X															
		F	W3-5	36	36			9.00							2		12'-6" 12'-0" X								X				
SB	1.080	F	VD-018A	36	24	 10/12/17		6.00							1		12'-3" X								INSTALL SIGN 10' NORTH OF POLE #2 / 214A / 11-1			T-95	
SB	1.024	F	R2-1				 10/13/17					1		X															
		F	R2-1	30	36			7.50							1		13'-3" X									X			
SB	0.841	F	R2-1				 9/15/17					1	X																
		F	R2-1	30	36			7.50																	INSTALL ON RETAINED POST	X			
SIGN SUMMARY SHEET							SHEET TOTALS	46.92	0.00	0	1	1	7	0	0	7		105.0	0	0.0	0.0	0.0	0.0	PROJECT NAME: STATEWIDE-SOUTH REGION	PLOT DATE: 2/27/2017				
								SF	SF	EA	EA	EA	EA	EA	EA	EA		FT	EA	LB	LB	LB	LB	PROJECT NUMBER: STPG SIGN(57)					
							VERMONT AGENCY OF TRANSPORTATION							TOWN DIRECTIONAL TOTALS	220.6	0.0	7	1	1	37	0	1	26		380.0	0		0.0	
																						DESIGNED BY: P. MCKECHNIE	SHREWSBURY VT-103 SB 4			SHEET 131 OF 264			