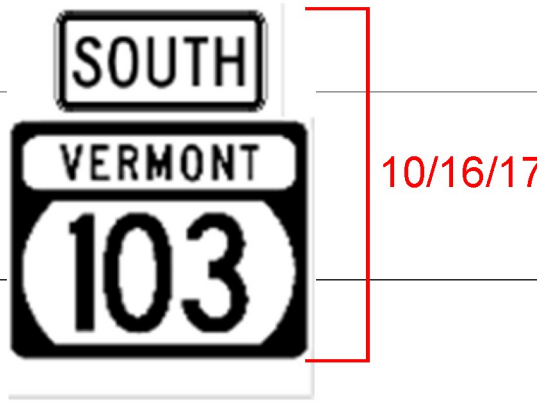
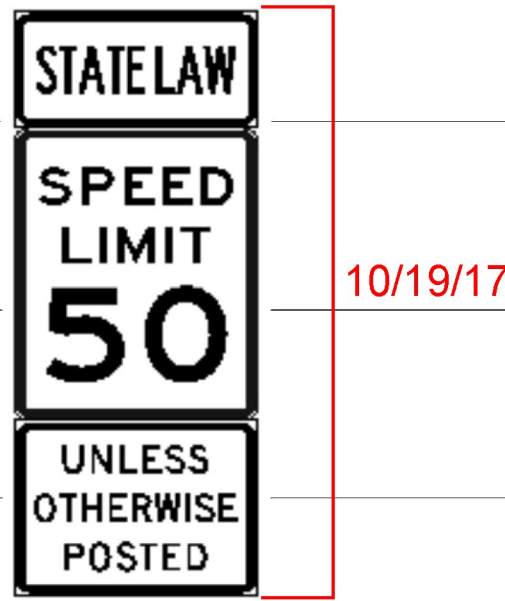


DIRECTION	MILEPOINT	LOCATION CODE (SHEET 4)	SIGN CODE	WIDTH (IN)	HEIGHT (IN)	SHEETING REMARKS	SIGN LEGEND	NEW SIGNS		EXISTING SIGNS				EXIST POST		NUMBER OF NEW POSTS	SQUARE STEEL (IN)			TUBULAR STEEL Ø (IN)				SIGN FRAME REQUIRED	REMARKS	SIGN DETAIL LOCATION				
								"A"	"B"	RETAIN	SALVAGE FROM	SALVAGE TO	REMOVE	RETAIN	REMOVE		1.75	2.00	2.50	FOUNDATION	3.00	3.50	4.00			5.00	SHSM	SIGN DETAILS SHEET #	STANDARD SHEET #	
																	(LB / FT)				(LB / FT)									
																	1.88	2.42	3.35		7.60	9.00	10.80			14.60				
SB CLARENDON VT ROUTE 103							FY-FLUORESCENT YELLOW FYG-FLUORESCENT YELLOW GREEN															"SHSM"-STANDARD HIGHWAY SIGNS AND MARKINGS BOOK								
		F	VM1-5	24	24			4.00																	E-136					
		F	M6-1R	21	15			2.19															ARROW, GREEN ON WHITE	X						
SB	1.767	F	M3-3									1		X																
		F	VM1-5									1																		
		F	M3-3	24	12			2.00						1	14'-0" X								SOUTH, GREEN ON WHITE	X						
		F	VM1-5	30	24			5.00																	E-136					
SB	1.735	F	R2-1									1		X																
		F	R2-5P									1																		
		F	VW-322P	24	12	FY		2.00						1	16'-0" X								SLIP BASE REQUIRED SEE SHEET 4. STATE LAW SIGN, BLACK ON YELLOW			T-82				
		F	R2-1	24	30			5.00															X							
		F	R2-5P	24	18			3.00															X							
SB	1.617	F	M3-3				SOUTH					1		X																
		F	VM1-5				VERMONT 103					1																		
		F	VD-700				MILE MARKER 1030 / 1105 / 0165				1	1																		
		F	VD-700				10/19/17 MILE MARKER 1030 / 1105 / 0165				1				1	7'-3" X							SALVAGE AND INSTALL BRIDGE PLAQUE ON NEW POST AT THE SAME STATION							
SIGN SUMMARY SHEET							SHEET TOTALS			23.19	0.00	0	1	1	7	0	0	3	40.0			0	0.0	0.0	0.0	PROJECT NAME: STATEWIDE-SOUTH REGION				
										SF	SF	EA	EA	EA	EA	EA	EA	EA	FT				EA	LB	LB	LB	LB	PROJECT NUMBER: STPG SIGN(57)		
																									FILE NAME: z16t041Clarendon103 SB.xls			PLOT DATE: 2/27/2017		
							VERMONT AGENCY OF TRANSPORTATION			TOWN DIRECTIONAL TOTALS			142.7	0.0	4	1	1	34	0	0	13	185.0			0	0.0			DESIGNED BY: P. MCKECHNIE CLARENDON VT-103 SB 3	