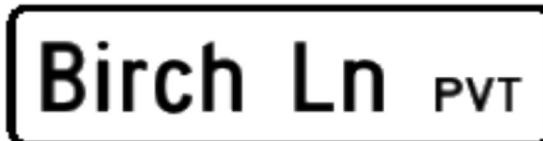


DIRECTION	MILEPOINT	LOCATION CODE (SHEET 4)	SIGN CODE	WIDTH (IN)	HEIGHT (IN)	SHEETING REMARKS	SIGN LEGEND	NEW SIGNS		EXISTING SIGNS				EXIST POST		NUMBER OF NEW POSTS	SQUARE STEEL (IN)			TUBULAR STEEL Ø (IN)				SIGN FRAME REQUIRED	REMARKS	SIGN DETAIL LOCATION			
								"A"	"B"	RETAIN	SALVAGE FROM	SALVAGE TO	REMOVE	RETAIN	REMOVE		1.75	2.00	2.50	FOUNDATION	3.00	3.50	4.00			5.00	SHSM	SIGN DETAILS SHEET #	STANDARD SHEET #
																	(LB / FT)				(LB / FT)								
																	1.88	2.42	3.35		7.60	9.00	10.80			14.60			
SB CLARENDON VT ROUTE 103							FY-FLUORESCENT YELLOW FYG-FLUORESCENT YELLOW GREEN															"SHSM"-STANDARD HIGHWAY SIGNS AND MARKINGS BOOK							
SB	1.124	G	VR-023b				 10/16/17						1	X															
		G	VR-023b	24	30			5.00																INSTALL ON RETAINED POST			T-70		
SB	0.774	F	VW-205				 10/16/17						1	X															
		F	VW-205	36	36			9.00																INSTALL ON RETAINED POST			T-82		
SB	0.678	FE	D3-1				 10/17/17						2		X														
		FE	D3-1	42	12			3.50								1	11'-9" X									8			
SB	0.620	FE	D3-1				 10/17/17						1		X														
		FE	D3-1	42	12			3.50								1	12'-3" X									8			
SB	0.308	F	W2-7L				 10/17/17						1	X															
		F		30	30			6.25																	INSTALL ON RETAINED POST		2		
SB	0.138	G	VR-017				 10/16/17						1	X															
		G	R2-1										1																
		G	VR-079	24	30			5.00																	INSTALL ON RETAINED POST			T-71	
SIGN SUMMARY SHEET							SHEET TOTALS	32.25	0.00	0	0	0	5	0	0	2	30.0		0	0.0	0.0	0.0	0.0	PROJECT NAME: STATEWIDE-SOUTH REGION PROJECT NUMBER: STPG SIGN(57)	PLOT DATE: 2/27/2017 DRAWN BY: W. GORDON CHECKED: BRZEWOSKI SHEET 147 OF 264				
								SF	SF	EA	EA	EA	EA	EA	EA	EA	FT		EA	LB	LB	LB	LB						
VERMONT AGENCY OF TRANSPORTATION							TOWN DIRECTIONAL TOTALS	142.7	0.0	4	1	1	34	0	0	13	185.0		0	0.0				FILE NAME: z16t041Clarendon103 SB.xls PROJECT MANAGER: D. MUNRO DESIGNED BY: P. MCKECHNIE CLARENDON VT-103 SB 5					