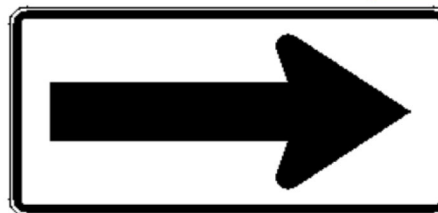
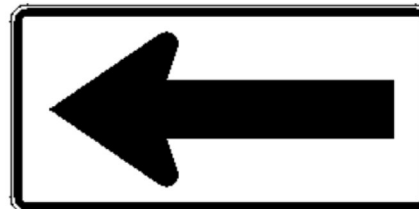


DIRECTION	MILEPOINT	LOCATION CODE (SHEET 4)	SIGN CODE	WIDTH (IN)	HEIGHT (IN)	SHEETING REMARKS	SIGN LEGEND	NEW SIGNS		EXISTING SIGNS				EXIST POST		NUMBER OF NEW POSTS	SQUARE STEEL (IN)			TUBULAR STEEL Ø (IN)				SIGN FRAME REQUIRED	REMARKS	SIGN DETAIL LOCATION				
								"A"	"B"	RETAIN	SALVAGE FROM	SALVAGE TO	REMOVE	RETAIN	REMOVE		1.75	2.00	2.50	FOUNDATION	3.00	3.50	4.00			5.00	SHSM	SIGN DETAILS SHEET #	STANDARD SHEET #	
																	(LB / FT)				(LB / FT)									
																	1.88	2.42	3.35		7.60	9.00	10.80			14.60				
NB VERNON VT ROUTE 142							FY-FLUORESCENT YELLOW FYG-FLUORESCENT YELLOW GREEN															"SHSM"-STANDARD HIGHWAY SIGNS AND MARKINGS BOOK								
		A	W1-10L	36	36	FY												14'-9" 14'-9" X						INSTALL IN SAME LOCATION AS EXISTING BICYCLE TRAFFIC SIGN	X					
		A	W16-8P	30	8	FY																		SIGN IS ON APPROACH TO LEFT CURVE		4				
NB	4.258	B	W1-6									1		X																
		B	W1-6	48	24	FY												14'-6" 14'-0" X								X				
NB	4.260-4.273	A	N/A				INSTALL (4) NEW DELINEATOR POSTS 11/21/17 REMOVE (4) DELINEATOR POSTS																	INSTALL (8) TYPE 1 WHITE DELINEATORS BACK TO BACK ON 4 NEW POSTS. INSTALL NEW POSTS IN THE SAME LOCATION AS EXISTING			T-40			
NB	4.280	C	VR-017				LLL 24,000 LBS			1				X										GOVERNOR HUNT RD (TH-4)						
NB	4.281	D	R1-1				STOP			1				X																
NB	4.275	AB	D3-1	72	12		 11/20/17	6.00							2			11'-3" 11'-0" X						INSTALL SIGN ON SOUTHEAST SIDE OF INTERSECTION, ±40' DOWNSTATION FROM EXISTING SIGN AT MP 4.283 NB		8				
NB	4.283	AB					GOVERNOR HUNT RD					1		X																
NB	4.284	A	W1-6				ONE DIRECTION LARGE ARROW					1		X																
		A	VD-700				MILE MARKER 1420 / 1318 / 0431					1																		
		A	W1-6	48	24	FY	 11/21/17	8.00							2			13'-0" 12'-9" X								X				
NB	4.289-4.313	A	N/A				INSTALL (3) NEW DELINEATOR POSTS 11/20/17 REMOVE (3) DELINEATOR POSTS																	INSTALL (6) TYPE 1 WHITE DELINEATORS BACK TO BACK ON 3 NEW POSTS. INSTALL NEW POSTS IN THE SAME LOCATION AS EXISTING			T-40			
NB	4.290	A	W11-1				BICYCLE TRAFFIC					1		X																
		A	W16-1P				SHARE THE ROAD					1																		
SIGN SUMMARY SHEET							SHEET TOTALS			32.67	0.00	2	0	0	6	0	0	8	120.0			0	0.0	0.0	0.0	0.0	PROJECT NAME: STATEWIDE-SOUTH REGION			
										SF	SF	EA	EA	EA	EA	EA	EA	EA	FT			EA	LB	LB	LB	LB	PROJECT NUMBER: STPG SIGN(57)			
																									FILE NAME: z16t041Vernon142 NB.xls			PLOT DATE: 2/27/2017		
							VERMONT AGENCY OF TRANSPORTATION			TOWN DIRECTIONAL TOTALS			615.1	0.0	21	16	16	132	0	0	110	1630.0			0	0.0			DESIGNED BY: P. MCKECHNIE VERNON VT-142 NB 12	