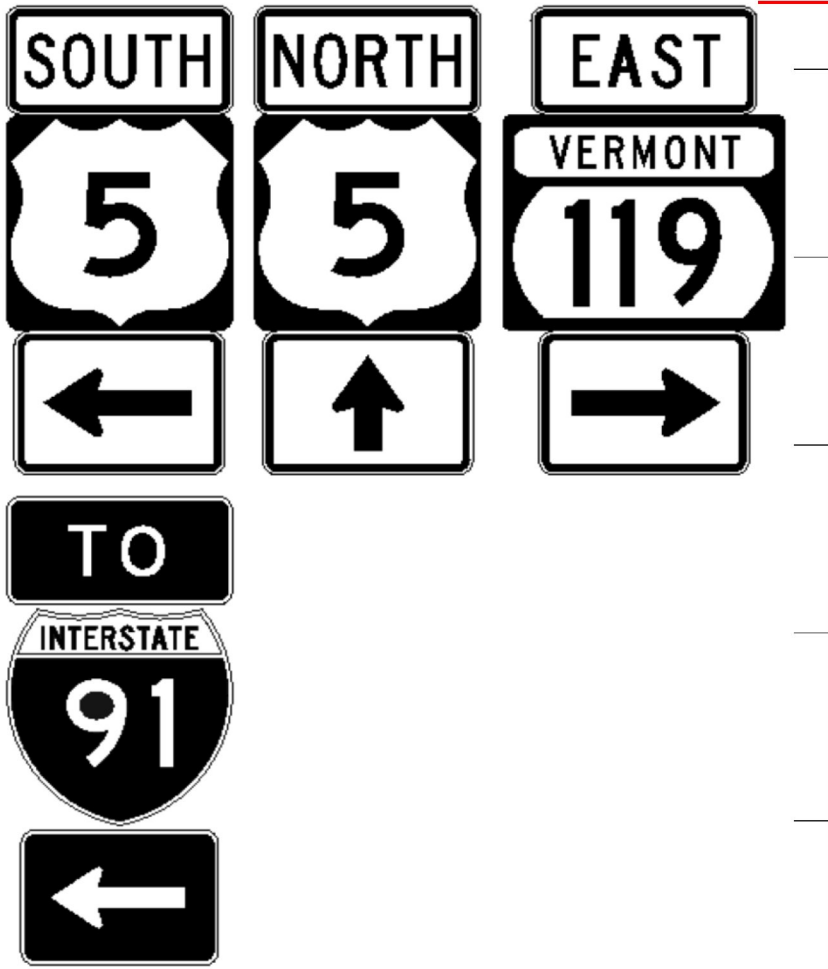


DIRECTION	MILEPOINT	LOCATION CODE (SHEET 4)	SIGN CODE	WIDTH (IN)	HEIGHT (IN)	SHEETING REMARKS	SIGN LEGEND	NEW SIGNS		EXISTING SIGNS				EXIST POST		NUMBER OF NEW POSTS	SQUARE STEEL (IN)			TUBULAR STEEL Ø (IN)				SIGN FRAME REQUIRED	REMARKS	SIGN DETAIL LOCATION			
								"A"	"B"	RETAIN	SALVAGE FROM	SALVAGE TO	REMOVE	RETAIN	REMOVE		1.75	2.00	2.50	FOUNDATION	3.00	3.50	4.00			5.00	SHSM	SIGN DETAILS SHEET #	STANDARD SHEET #
																	(LB / FT)				(LB / FT)								
																	1.88	2.42	3.35		7.60	9.00	10.80			14.60			
NB BRATTLEBORO VT ROUTE 142							FY-FLUORESCENT YELLOW FYG-FLUORESCENT YELLOW GREEN															"SHSM"-STANDARD HIGHWAY SIGNS AND MARKINGS BOOK							
		A	M3-1	24	12			2.00															NORTH, BLACK ON WHITE	X					
		A	M1-4	24	24			4.00																X					
		A	M6-3	21	15			2.19															ARROW, BLACK ON WHITE	X					
		A	M3-2	24	12			2.00															EAST, GREEN ON WHITE INSTALL ON RIGHT POST	X					
		A	VM5-1	24	24			4.00																		E-136			
		A	M6-1	21	15			2.19															ARROW, GREEN ON WHITE	X					
NB	2.109	A	M4-5				TO						1		X														
		A	M1-4				US ROUTE 5						1																
		A	M6-1				LEFT ARROW						1																
		A	M1-1				INTERSTATE 91						1																
		A	M6-1				LEFT ARROW						1																
		A	M3-2				EAST						1																
		A	VM5-1				VERMONT 119						1																
		A	M6-1R				RIGHT ARROW						1																
SIGN SUMMARY SHEET							SHEET TOTALS	16.38	0.00	0	0	0	8	0	0	0	0.0			0	0.0	0.0	0.0	0.0	PROJECT NAME: STATEWIDE-SOUTH REGION				
								SF	SF	EA	EA	EA	EA	EA	EA	EA		FT		EA	LB	LB	LB	LB	PROJECT NUMBER: STPG SIGN(57)				
																									FILE NAME: z16t041Brattleboro142 NB.xls				
							VERMONT AGENCY OF TRANSPORTATION	TOWN DIRECTIONAL TOTALS	209.8	0.0	7	4	4	50	0	0	30	420.0			2	236.0				PLOT DATE: 2/27/2017			
																									DRAWN BY: W. GORDON				
																									CHECKED: BRZEZOWSKI				
																									SHEET 190 OF 264				