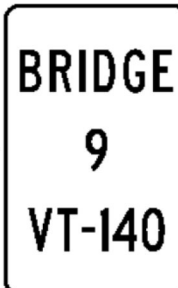


DIRECTION	MILEPOINT	LOCATION CODE (SHEET 4)	SIGN CODE	WIDTH (IN)	HEIGHT (IN)	SHEETING REMARKS	SIGN LEGEND	NEW SIGNS		EXISTING SIGNS				EXIST POST		NUMBER OF NEW POSTS	SQUARE STEEL (IN)			TUBULAR STEEL Ø (IN)				SIGN FRAME REQUIRED	REMARKS	SIGN DETAIL LOCATION					
								"A"	"B"	RETAIN	SALVAGE FROM	SALVAGE TO	REMOVE	RETAIN	REMOVE		1.75	2.00	2.50	FOUNDATION	3.00	3.50	4.00			5.00	SHSM	SIGN DETAILS SHEET #	STANDARD SHEET #		
																	(LB / FT)				(LB / FT)										
																	1.88	2.42	3.35		7.60	9.00	10.80			14.60					
WB WALLINGFORD VT RTE 140								FY-FLUORESCENT YELLOW FYG-FLUORESCENT YELLOW GREEN															"SHSM"-STANDARD HIGHWAY SIGNS AND MARKINGS BOOK								
		F	W2-3R	30	30			 10/31/17	6.25																	INSTALL ON RETAINED POST	X				
		F	W16-8aP	24	8		 10/31/17	1.33																5							
WB	5.595	FE					 10/31/17					1		X								PARKER RD (TH-24)									
		FE	D3-1	42	12			3.50							1	10'-6" X								9							
WB	5.595	G	VR-017				 10/31/17					1	X																		
		G	VR-017	24	30			5.00														INSTALL ON RETAINED POST			T-70						
WB	5.590	H	R1-1				 10/31/17 STOP					1	X																		
		H	R1-1	30	30			6.25														THINNING AND TRIMMING INSTALL ON RETAINED POST	X								
WB	5.280	F	W2-2R				 11/20/17 SIDE ROAD					1		X																	
		F	W1-10L	36	36			9.00							2	14'-0" 13'-6" X							X								
		F	W16-8aP	33	8		 11/20/17	1.83																5							
WB	5.200	F	VD-701				 10/31/17					1		X																	
		F	VD-701	6	10			0.42							1	7'-3" X									T-42						
WB	5.171	FE										1		X																	
		G	VR-017									1																			
SIGN SUMMARY SHEET							SHEET TOTALS				33.17	0.00	0	0	0	7	0	0	4	55.0			0	0.0	0.0	0.0	0.0	PROJECT NAME: STATEWIDE-SOUTH REGION			
											SF	SF	EA	EA	EA	EA	EA	EA	EA	FT			EA	LB	LB	LB	LB	PROJECT NUMBER: STPG SIGN(57)			
																											FILE NAME: z16t041Wallinoford140WB.xls				
							VERMONT AGENCY OF TRANSPORTATION				TOWN DIRECTIONAL TOTALS				572.0	0.0	35	2	2	128	0	0	93	1325.0			2	183.0			PLOT DATE: 2/27/2017
																											DRAWN BY: W. GORDON				
																											CHECKED: BRZEZOWSKI				
																											SHEET 219 OF 264				