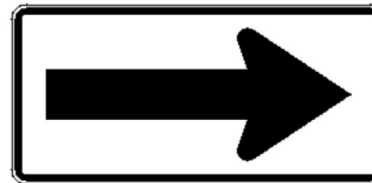
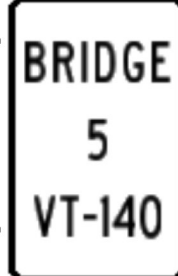


DIRECTION	MILEPOINT	LOCATION CODE (SHEET 4)	SIGN CODE	WIDTH (IN)	HEIGHT (IN)	SHEETING REMARKS	SIGN LEGEND	NEW SIGNS		EXISTING SIGNS				EXIST POST		NUMBER OF NEW POSTS	SQUARE STEEL (IN)			TUBULAR STEEL Ø (IN)				SIGN FRAME REQUIRED	REMARKS	SIGN DETAIL LOCATION			
								"A"	"B"	RETAIN	SALVAGE FROM	SALVAGE TO	REMOVE	RETAIN	REMOVE		1.75	2.00	2.50	FOUNDATION	3.00	3.50	4.00			5.00	SHSM	SIGN DETAILS SHEET #	STANDARD SHEET #
																	(LB / FT)				(LB / FT)								
																	1.88	2.42	3.35		7.60	9.00	10.80			14.60			
WB WALLINGFORD VT RTE 140							FY-FLUORESCENT YELLOW FYG-FLUORESCENT YELLOW GREEN															"SHSM"-STANDARD HIGHWAY SIGNS AND MARKINGS BOOK							
WB	3.860	F	W1-1R	30	30	FY		11/6/17	6.25							1	14'-9" X							INSTALL ±50' DOWNSTATION FROM EXISTING CURVE WARNING SIGN AT MP 3.870 WB	X				
		F	W13-1P	18	18	FY			2.25															THINNING AND TRIMMING	X				
WB	3.665	F	W11-2					11/4/17					1		X														
		F	VW-258P											1															
		F	W11-2	30	30	FYG				6.25								1	12'-0" X							X			
		F	VW-258P	24	18	FYG				3.00																	5		
WB	3.590	E	W1-6	48	24	FY		11/7/17	8.00							2	12'-3" 11'-3" X							INSTALL SIGN ±400' DOWNSTATION FROM EXISTING SIGN AT MP 3.665 WB	X				
WB	3.570	F	W1-6	48	24	FY		11/6/17	8.00							2	12'-3" 11'-9" X							INSTALL SIGN ±500' DOWNSTATION FROM EXISTING SIGN AT MP 3.665 WB	X				
WB	3.512	F	VD-701	6	10			11/4/17	0.42							1	4'-9" X										T-42		
WB	3.511	F	OM3-R										1		X														
		F	VD-701					11/27/17																					
		F	OM3-R	12	36	FY				3.00							1	9'-9" X								X			
WB	3.508	E	OM3-L					4/9/18																					
		E	OM3-L	12	36	FY				3.00							1	X								X			
SIGN SUMMARY SHEET							SHEET TOTALS		24.17	0.00	0	0	0	5	0	0	9	130.0	0	0.0	0.0	0.0	0.0	PROJECT NAME: STATEWIDE-SOUTH REGION	DRAWN BY: W. GORDON CHECKED: BRZEZOWSKI SHEET 222 OF 264				
									SF	SF	EA	EA	EA	EA	EA	EA	EA	FT	EA	LB	LB	LB	LB	PROJECT NUMBER: STPG SIGN(57)					
																							FILE NAME: z16t041Wallinaford140WB.xls						
									TOWN DIRECTIONAL TOTALS										572.0	0.0	35	2	2	128				0	0
VERMONT AGENCY OF TRANSPORTATION																			DESIGNED BY: P. MCKECHNIE WALLINGFORD VT-140 WB 8										