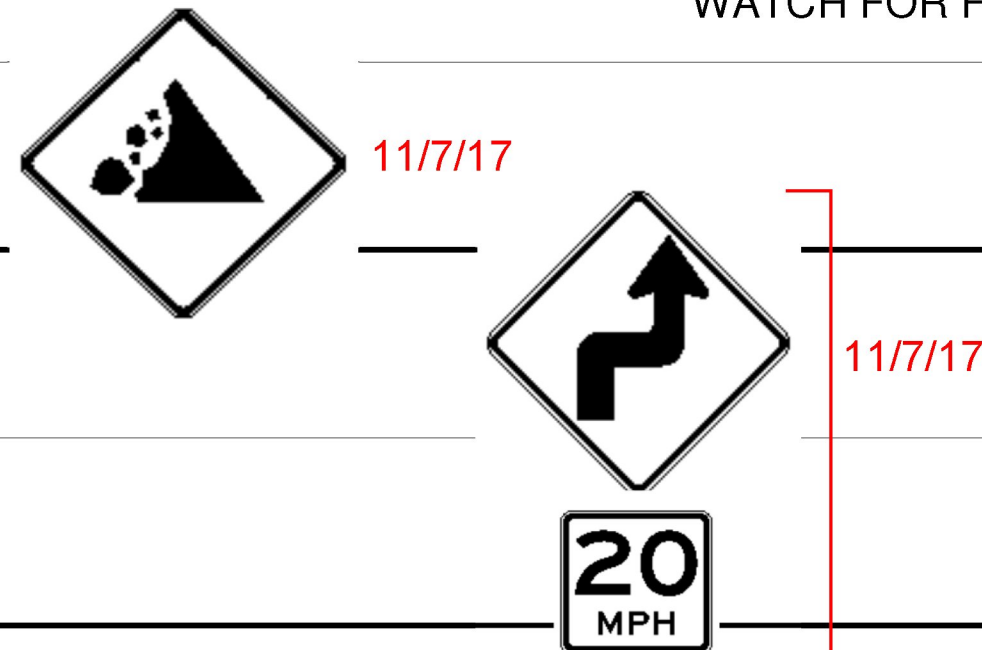
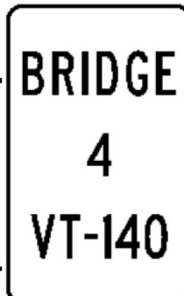
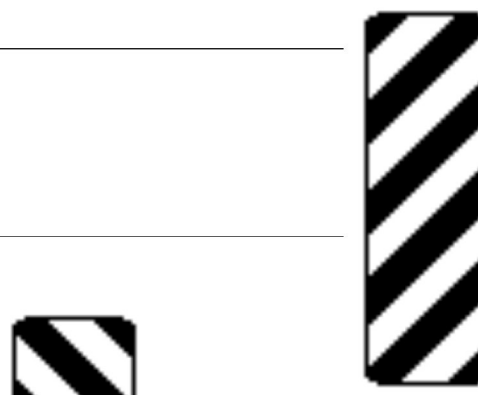
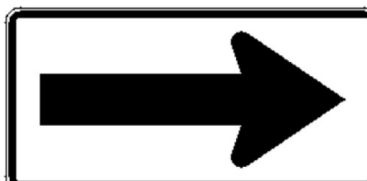


DIRECTION	MILEPOINT	LOCATION CODE (SHEET 4)	SIGN CODE	WIDTH (IN)	HEIGHT (IN)	SHEETING REMARKS	SIGN LEGEND	NEW SIGNS		EXISTING SIGNS				EXIST POST		NUMBER OF NEW POSTS	SQUARE STEEL (IN)			TUBULAR STEEL Ø (IN)				SIGN FRAME REQUIRED	REMARKS	SIGN DETAIL LOCATION			
								"A"	"B"	RETAIN	SALVAGE FROM	SALVAGE TO	REMOVE	RETAIN	REMOVE		1.75	2.00	2.50	FOUNDATION	3.00	3.50	4.00			5.00	SHSM	SIGN DETAILS SHEET #	STANDARD SHEET #
																	(LB / FT)				(LB / FT)								
																	1.88	2.42	3.35		7.60	9.00	10.80			14.60			
WB WALLINGFORD VT RTE 140							FY-FLUORESCENT YELLOW FYG-FLUORESCENT YELLOW GREEN															"SHSM"-STANDARD HIGHWAY SIGNS AND MARKINGS BOOK							
		G					HIKING TRAIL (PLAQUE)			1																			
WB	2.622	F					WATCH FOR FALLEN ROCK					1		X															
		F	VW-285	30	30	FY		6.25							1	12'-3" X										1			
WB	2.580	F	W1-3R	30	30	FY		6.25							1	12'-3" X								INSTALL ±220' DOWNSTATION FROM EXISTING SIGN AT MP 2.622 WB	X				
		F	W13-1P	18	18	FY		2.25																	X				
WB	2.538	F	W1-6L				ONE DIRECTION LARGE ARROW LEFT						1		X														
		E	W1-6R				ONE DIRECTION LARGE ARROW RIGHT						1																
		F	W1-6	48	24	FY		8.00							2	12'-3" 12'-3" X									X				
WB	2.536	E	W1-6	48	24	FY		8.00							2	12'-3" 12'-3" X								INSTALL ±10' DOWNSTATION FROM EXISTING SIGN AT MP 2.538 WB	X				
WB	2.491	F	VD-701	6	10			0.42							1	7'-9" X												T-42	
WB	2.490	F	OM3-R				RIGHT OBJECT MARKER						1		X														
		F	VD-701				BRIDGE 4 PLAQUE						1																
		F	OM3-R	12	36	FY		3.00							1	10'-9" X										X			
WB	2.480	E	OM3-L	12	36	FY		3.00							1	10'-6" X										X			
WB	2.446	E	W1-6	48	24	FY		8.00							2	12'-3" 12'-3" X								INSTALL SIGN ±235' DOWNSTATION FROM EXISTING SIGN AT MP 2.490 WB	X				
SIGN SUMMARY SHEET							SHEET TOTALS	45.17	0.00	1	0	0	5	0	0	11	160.0		0	0.0	0.0	0.0	0.0	PROJECT NAME: STATEWIDE-SOUTH REGION PROJECT NUMBER: STPG SIGN(57)					
								SF	SF	EA	EA	EA	EA	EA	EA	EA		FT		EA	LB	LB	LB	LB	FILE NAME: z16t041Wallinaford140WB.xls PROJECT MANAGER: D. MUNRO DESIGNED BY: P. MCKECHNIE WALLINGFORD VT-140 WB 11	PLOT DATE: 2/27/2017 DRAWN BY: W. GORDON CHECKED: BRZEWOSKI SHEET 225 OF 264			
							TOWN DIRECTIONAL TOTALS	572.0	0.0	35	2	2	128	0	0	93	1325.0	2	183.0										
VERMONT AGENCY OF TRANSPORTATION																													