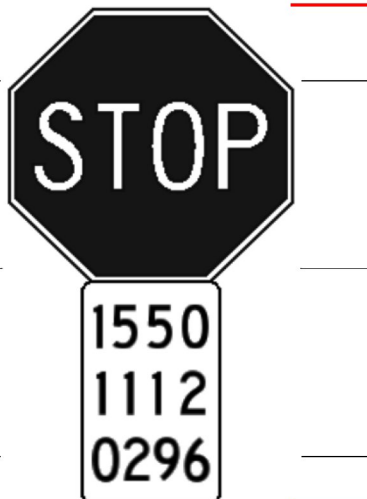


DIRECTION	MILEPOINT	LOCATION CODE (SHEET 4)	SIGN CODE	WIDTH (IN)	HEIGHT (IN)	SHEETING REMARKS	SIGN LEGEND	NEW SIGNS		EXISTING SIGNS				EXIST POST		NUMBER OF NEW POSTS	SQUARE STEEL (IN)			TUBULAR STEEL Ø (IN)				SIGN FRAME REQUIRED	REMARKS	SIGN DETAIL LOCATION				
								"A"	"B"	RETAIN	SALVAGE FROM	SALVAGE TO	REMOVE	RETAIN	REMOVE		1.75	2.00	2.50	FOUNDATION	3.00	3.50	4.00			5.00	SHSM	SIGN DETAILS SHEET #	STANDARD SHEET #	
																	(LB / FT)				(LB / FT)									
																	1.88	2.42	3.35		7.60	9.00	10.80			14.60				
NB MT HOLLY VT 155							FY-FLUORESCENT YELLOW FYG-FLUORESCENT YELLOW GREEN															"SHSM"-STANDARD HIGHWAY SIGNS AND MARKINGS BOOK								
NB	2.975	C	VR-017				 11/2/17					1	X										MAPLE HILL RD (TH-22)							
		C	VR-017	24	30			5.00															INSTALL SIGN ON RETAINED POST AT SAME STATION			T-70				
NB	2.981	AB	D3-1				 11/2/17					1		X																
		AB	D3-1	72	12			6.00							2		12'-3" 11'-9" X						INSTALL INDEPENDENTLY ON TWO POSTS 10' FROM EDGE OF PAVEMENT		10					
NB	2.981	D	R1-1				 11/2/17					1		X																
		C	VD-700										1																	
		D	R1-1	30	30				6.25							1		11'-3" X							X					
		C	VD-700	6	10				0.42															INSTALL BACK TO BACK ON STOP SIGN POST			T-44			
NB	3.210	A	W11-7				 11/6/17					1		X																
		A	W11-7	30	30			6.25							1		16'-6" X							X						
NB	3.400	AB	D3-1				SPRUCE LN PVT			1				X																
NB	3.410	A	VD-701				 11/6/17					1		X																
		A	VD-700										1																	
		A	VD-701	6	10				0.42							1		8'-6" X								T-42				
		A	VD-700	6	10				0.42																	T-44				
SIGN SUMMARY SHEET							SHEET TOTALS	24.75	0.00	1	0	0	7	0	0	5		70.0		0	0.0	0.0	0.0	0.0	PROJECT NAME: STATEWIDE-SOUTH REGION					
								SF	SF	EA	EA	EA	EA	EA	EA	EA		FT		EA	LB	LB	LB	LB	PROJECT NUMBER: STPG SIGN(57)					
							VERMONT AGENCY OF TRANSPORTATION																				FILE NAME: z16t041Mt HollyVT155 NB.xls	PLOT DATE: 2/27/2017		
														TOWN DIRECTIONAL TOTALS																
																										DESIGNED BY: P. MCKECHNIE	CHECKED BRZEZOWSKI			
																										MOUNT HOLLY VT-155 NB 4	SHEET 245 OF 264			