


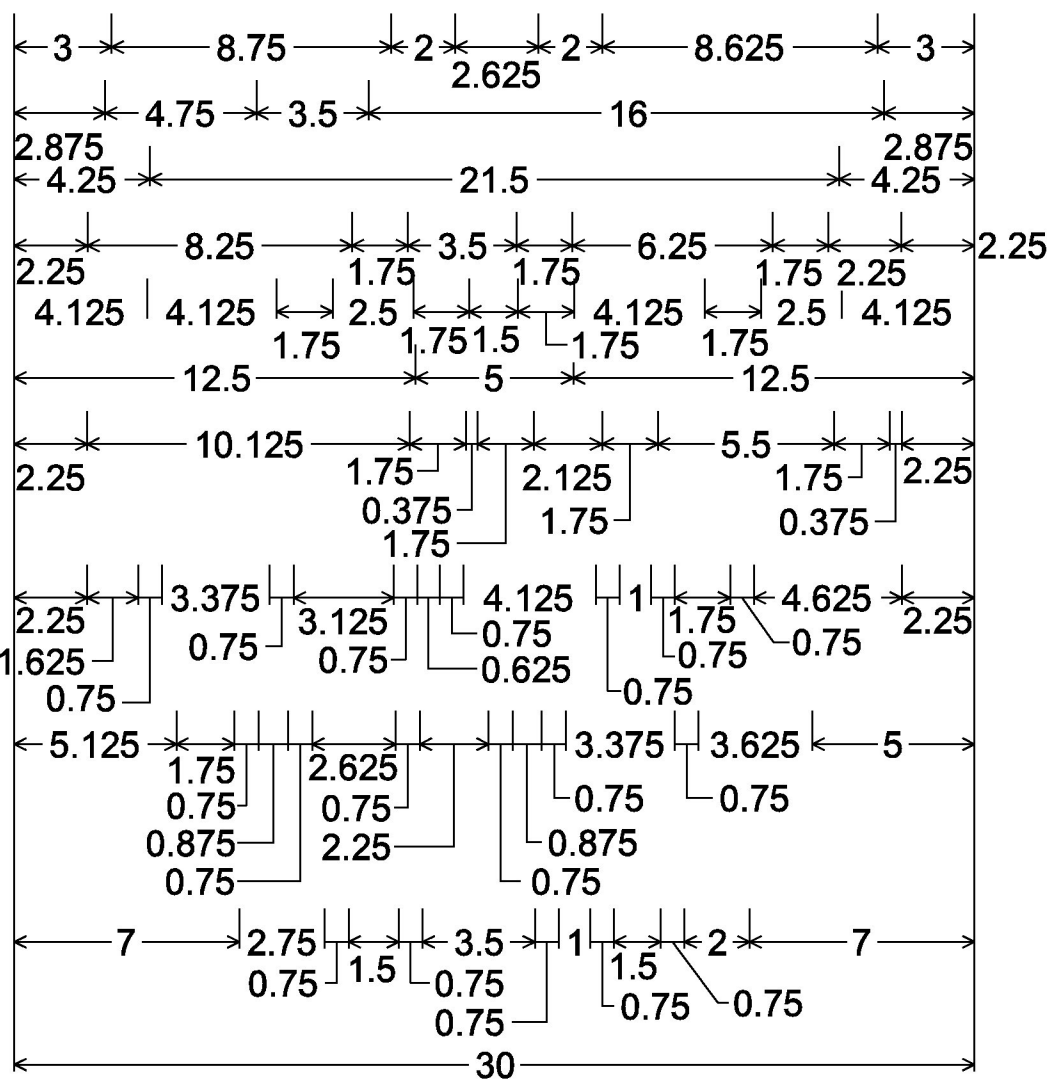


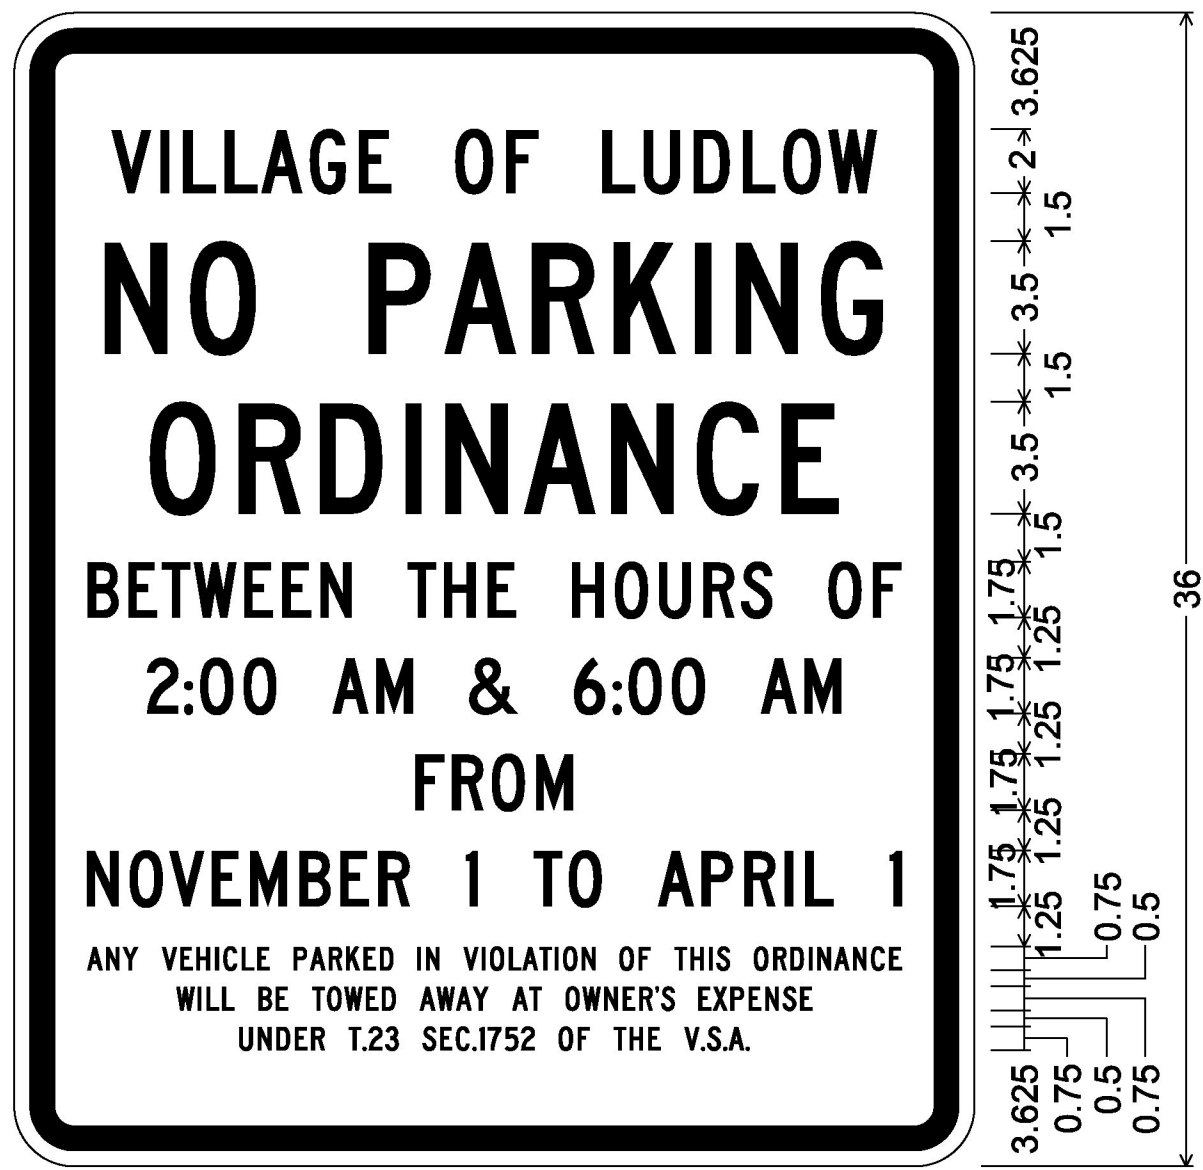


1.875" Radius, 0.750" Border, 0.500" Indent, Red on White;
[VILLAGE OF LUDLOW] C 2K;
[NO PARKING] C 2K; [ORDINANCE] C 2K;
[BETWEEN THE HOURS OF] C 2K;
[2:00 AM & 6:00 AM] C 2K; [FROM] C 2K;
[NOVEMBER 1 TO APRIL 1] C 2K;
[ANY VEHICLE PARKED IN VIOLATION OF THIS ORDINANCE] C 2K;
[WILL BE TOWED AWAY AT OWNER'S EXPENSE] C 2K;
[UNDER T.23 SEC.1752 OF THE V.S.A.] C 2K;

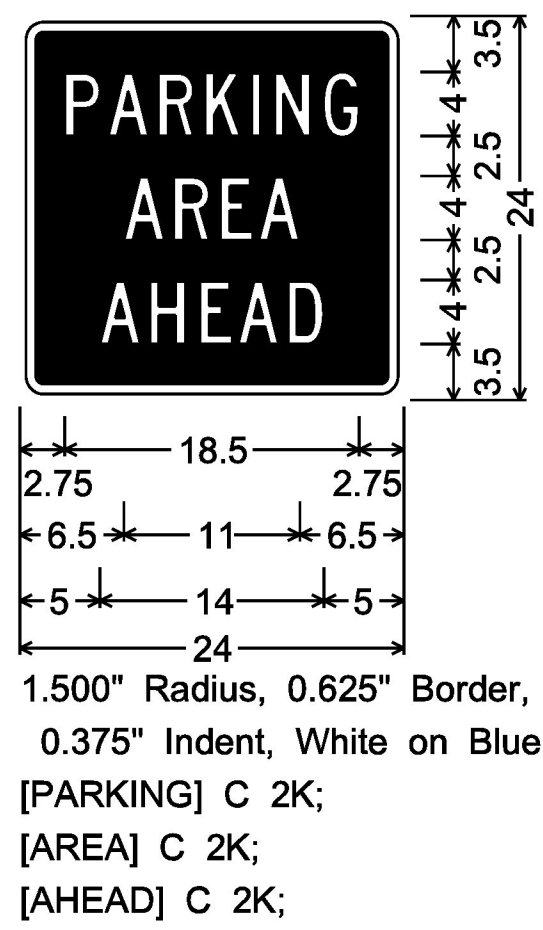

1.500" Radius, 0.625" Border,
0.375" Indent, White on Blue;
[PARKING] C 2K;
[AREA] C 2K;
[AHEAD] C 2K;

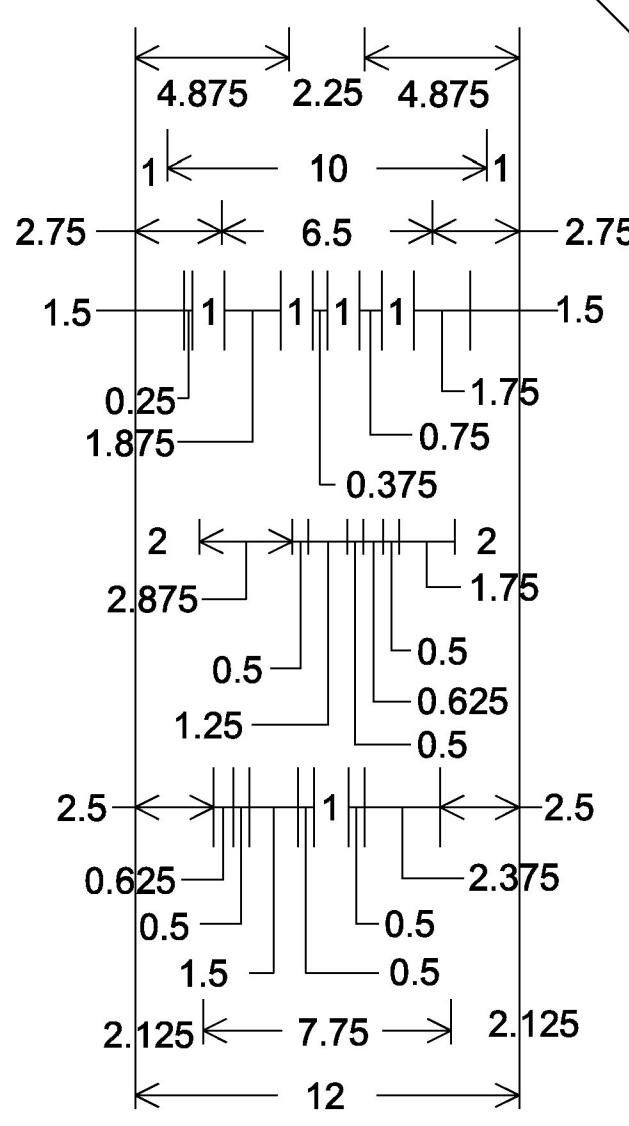

1.500" Radius, 0.375" Border, 0.375" Indent, Red on White;
[NO] C 2K;
[OVERNIGHT] C 2K 80% spacing;
[PARKING] B 2K;
[1 AM - 5 AM] C 2K 80% spacing;
[VIOLATORS WILL BE TOWED] C 2K;
[AT THEIR OWN EXPENSE] C 2K;
Double Headed Arrow Custom - 7.750" 0°;

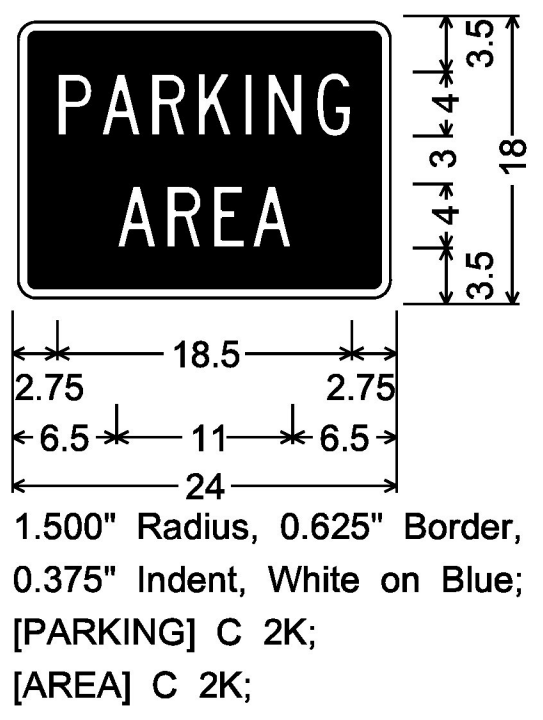

1.500" Radius, 0.625" Border,
0.375" Indent, White on Blue;
[PARKING] C 2K;
[AREA] C 2K;



** "SKI AREA" TEXT IS 2.5" HIGH WITH 1" BETWEEN LINES
DIMENSIONS NOT SHOWN FOR THIS DETAIL SHALL CONFORM
TO VAOT STANDARD T-93, VD1-1A FOR GENERAL DESTINATION SIGN DESIGN

VD1-1aSa



** "SKI AREA" TEXT IS 2.5" HIGH WITH 1" BETWEEN LINES
DIMENSIONS NOT SHOWN FOR THIS DETAIL SHALL CONFORM
TO VAOT STANDARD T-93, VD2-1 FOR GENERAL DESTINATION SIGN DESIGN

VD1-1Sa



** "SKI AREA" TEXT IS 2.5" HIGH WITH 1" BETWEEN LINES
REFER TO STD T-93, VD2-1 FOR GENERAL DESTINATION SIGN DESIGN

VD1-1Sa



** "SKI AREA" TEXT IS 2.5" HIGH WITH 1" BETWEEN LINES
REFER TO STD T-93, VD2-1S FOR GENERAL DESTINATION SIGN DESIGN

VD2-1Sa

NOTE:
OKEMO MOUNTAIN DESTINATION SIGNS ARE EXAMPLES ONLY

ALL DIMENSIONS SHOWN IN INCHES,
UNLESS OTHERWISE NOTED.

PROJECT NAME: STATEWIDE-SOUTH REGION	
PROJECT NUMBER: STPG SIGN(57)	
FILE NAME: z161041frm.dgn	PLOT DATE: 2/27/2017
PROJECT LEADER: D. MUNRO	DRAWN BY: P. MCKECHN
DESIGNED BY: S. GOODWIN	CHECKED BY: J. BRZEWOS
SIGN DETAILS SHEET 3	SHEET 8 OF 264

NOT TO SCALE