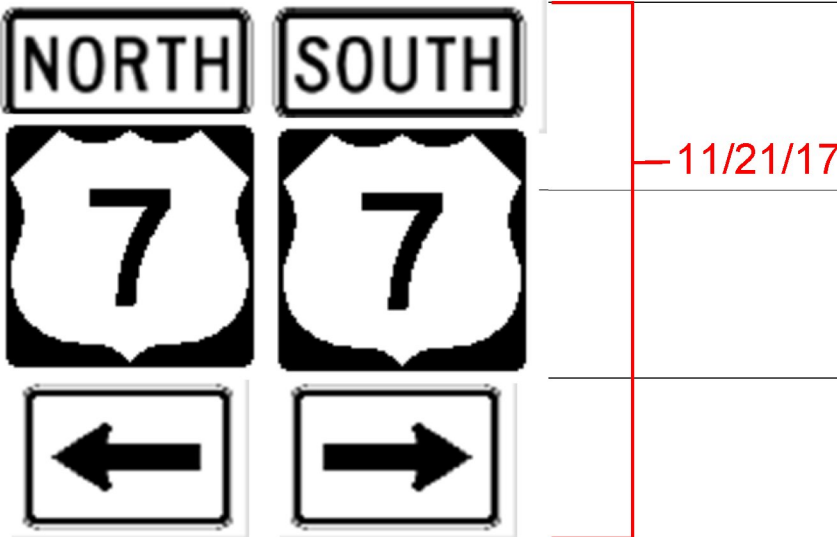


DIRECTION	MILEPOINT	LOCATION CODE (SHEET 4)	SIGN CODE	WIDTH (IN)	HEIGHT (IN)	SHEETING REMARKS	SIGN LEGEND	NEW SIGNS		EXISTING SIGNS				EXIST POST		NUMBER OF NEW POSTS	SQUARE STEEL (IN)			TUBULAR STEEL Ø (IN)				SIGN FRAME REQUIRED	REMARKS	SIGN DETAIL LOCATION			
								"A"	"B"	RETAIN	SALVAGE FROM	SALVAGE TO	REMOVE	RETAIN	REMOVE		1.75	2.00	2.50	FOUNDATION	3.00	3.50	4.00			5.00	SHSM	SIGN DETAILS SHEET #	STANDARD SHEET #
																	(LB / FT)				(LB / FT)								
																	1.88	2.42	3.35		7.60	9.00	10.80			14.60			
SB WALLINGFORD VT ROUTE 7B							FY-FLUORESCENT YELLOW FYG-FLUORESCENT YELLOW GREEN															"SHSM"-STANDARD HIGHWAY SIGNS AND MARKINGS BOOK							
		F	M6-1R									1																	
SB	0.050	F	M3-1	24	12			2.00							2	17'-3" 16'-6" X						2A	~~INSTALL ON RETAINED POSTS~~ REPLACE SIGN FRAME NORTH, BLACK ON WHITE	X					
		F	M1-4	24	24			4.00																X					
		F	M6-1L	21	15			2.19																X					
		F	M3-3	24	12			2.00																X					
		F	M1-4	24	24			4.00																X					
		F	M6-1R	21	15			2.19																X					
SB	0.010	FE					CLARENDON RD						1		X														
		F	R1-1				STOP				1		1																
		E	VD-700				MILE MARKER 0140 / 1125 / 0633				1		1																
		F	R1-1				STOP					1			1	12'-6" X													
		E	VD-700				~~MILE MARKER 0140 / 1125 / 0633~~					+												~~INSTALL BACK TO BACK WITH~~ ~~STOP SIGN~~ INACCURATE MM REMOVED					
SB	0.010	FE	D3-1	56	12		Clarendon Rd 7/18/17	4.67							2	10'-0" 8'-9" X								INSTALL INDEPENDENTLY ON TWO POSTS		6			
SIGN SUMMARY SHEET							SHEET TOTALS	21.04	0.00	0	2	2	4	0	0	3	45.0			0	0.0	0.0	0.0	0.0	PROJECT NAME: STATEWIDE-SOUTH REGION				
								SF	SF	EA	EA	EA	EA	EA	EA	EA		FT		EA	LB	LB	LB	LB	PROJECT NUMBER: STPG SIGN(57)				
																											FILE NAME: z16t041Wallinaford7B SB.xls	PLOT DATE: 2/27/2017	
VERMONT AGENCY OF TRANSPORTATION							TOWN DIRECTIONAL TOTALS	63.2	0.0	5	2	2	20	0	0	5	75.0			0	0.0				PROJECT MANAGER: D. MUNRO		DRAWN BY: W. GORDON		
																										DESIGNED BY: P. MCKECHNIE	CHECKED: BRZEWOWSKI		
																								WALLINGFORD VT-7B SB 3			SHEET 19 OF 264		