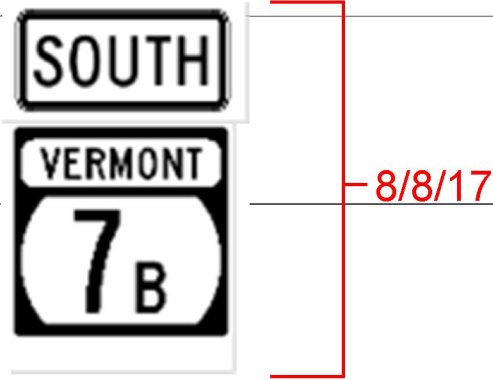
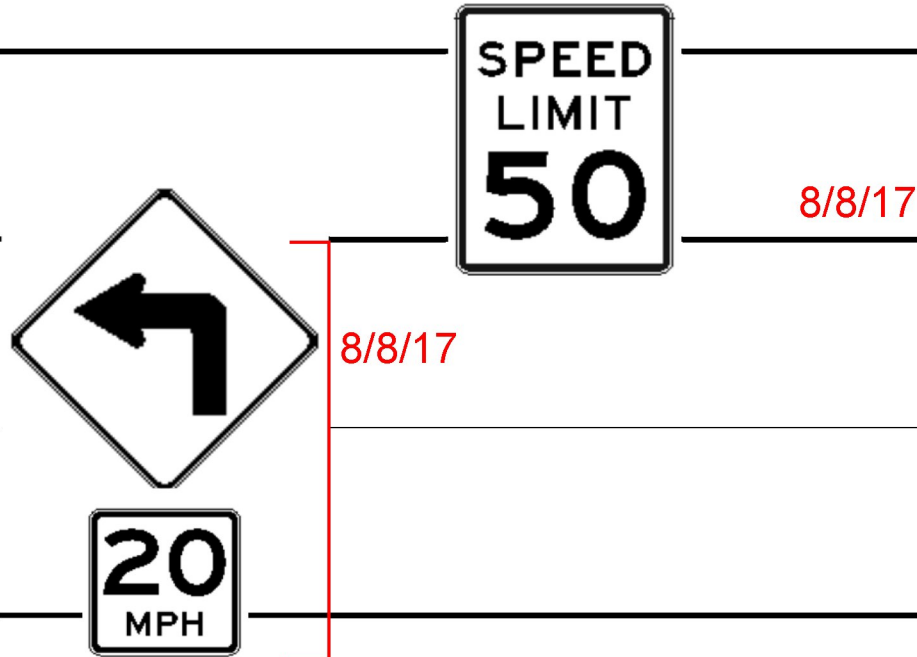


DIRECTION	MILEPOINT	LOCATION CODE (SHEET 4)	SIGN CODE	WIDTH (IN)	HEIGHT (IN)	SHEETING REMARKS	SIGN LEGEND	NEW SIGNS		EXISTING SIGNS				EXIST POST		NUMBER OF NEW POSTS	SQUARE STEEL (IN)			TUBULAR STEEL Ø (IN)				SIGN FRAME REQUIRED	REMARKS	SIGN DETAIL LOCATION					
								"A"	"B"	RETAIN	SALVAGE FROM	SALVAGE TO	REMOVE	RETAIN	REMOVE		1.75	2.00	2.50	FOUNDATION	3.00	3.50	4.00			5.00	SHSM	SIGN DETAILS SHEET #	STANDARD SHEET #		
																	(LB / FT)				(LB / FT)										
																	1.88	2.42	3.35		7.60	9.00	10.80			14.60					
SB CLARENDON VT ROUTE 7B							FY-FLUORESCENT YELLOW FYG-FLUORESCENT YELLOW GREEN															"SHSM"-STANDARD HIGHWAY SIGNS AND MARKINGS BOOK									
SB	1.011	F	W3-1				STOP AHEAD			1				X									NOTE: PROJECT SUSPENDS HERE AT JUNCTION WITH U.S. 7								
SB	0.880	F	M3-3									1	X										NOTE: PROJECT RESUMES HERE AT JUNCTION WITH U.S. 7								
		F	M1-5										1																		
		F	M3-3	24	12			2.00															INSTALL ON RETAINED POST SOUTH, GREEN ON WHITE	X							
		F	M1-5	24	24			4.00																		E-136					
SB	0.880	F	R2-1	24	30			5.00							1	14'-9" X							INSTALL TO THE RIGHT OF THE SOUTH VT-7B ASSEMBLY ON SEPARATE POST	X							
SB	0.821	F	W1-1L	30	30	FY		6.25							1	14'-0" X							INSTALL ACROSS FROM NB STOP AHEAD SIGN AT MP 0.821 NB	X							
		F	W13-1P	18	18	FY		2.25																	X						
SB	0.767	F	W1-6L									1		X																	
		F	W1-6L	48	24	FY		8.00								2	11'-9" 11'-3" X								X						
SB	0.765	E	W1-6R									1		X																	
		E	W1-6R	48	24	FY		8.00								2	11'-9" 11'-3" X								X						
SB	0.721	F	VW-133L				HIDDEN DRIVE LEFT					1		X																	
SB	0.481	F					EMPTY SIGN POST							X									REMOVE EMPTY POST. PAYMENT SHALL BE PAID UNDER ITEM 676.12 REMOVAL OF EXISTING DELINEATOR								
SIGN SUMMARY SHEET							SHEET TOTALS	35.50	0.00	1	0	0	5	0	0	6		90.0	0	0.0	0.0	0.0	0.0	PROJECT NAME: STATEWIDE-SOUTH REGION	PROJECT NUMBER: STPG SIGN(57)			VERMONT AGENCY OF TRANSPORTATION			
								SF	SF	EA	EA	EA	EA	EA	EA	EA		FT		EA	LB	LB	LB	LB							
																														FILE NAME: z16t041Clarendon7B SB.xls	PLOT DATE: 2/27/2017
							TOWN DIRECTIONAL TOTALS							154.3	0.0	1	0	0	37	0	0	17		220.0	2		279.0		PROJECT MANAGER: D. MUNRO	DRAWN BY: W. GORDON	
																						DESIGNED BY: P. MCKECHNIE	CHECKED: BRZEZOWSKI								
																							CLARENDON VT-7B SB 5	SHEET 31 OF 264							