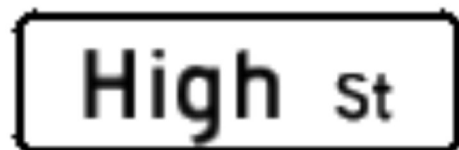


DIRECTION	MILEPOINT	LOCATION CODE (SHEET 4)	SIGN CODE	WIDTH (IN)	HEIGHT (IN)	SHEETING REMARKS	SIGN LEGEND	NEW SIGNS		EXISTING SIGNS				EXIST POST		NUMBER OF NEW POSTS	SQUARE STEEL (IN)			TUBULAR STEEL Ø (IN)				SIGN FRAME REQUIRED	REMARKS	SIGN DETAIL LOCATION			
								"A"	"B"	RETAIN	SALVAGE FROM	SALVAGE TO	REMOVE	RETAIN	REMOVE		1.75	2.00	2.50	FOUNDATION	3.00	3.50	4.00			5.00	SHSM	SIGN DETAILS SHEET #	STANDARD SHEET #
																	(LB / FT)				(LB / FT)								
																	1.88	2.42	3.35		7.60	9.00	10.80			14.60			
NB LUDLOW VT ROUTE 103							FY-FLUORESCENT YELLOW FYG-FLUORESCENT YELLOW GREEN															"SHSM"-STANDARD HIGHWAY SIGNS AND MARKINGS BOOK							
NB	1.811	D	R1-1	30	30		 8/11/17	6.25								1		11'-6" X						INSTALL AT SAME LOCATION AS EXISTING STOP SIGN	X				
		C	VD-700				MILE MARKER 1030/1410/0180					1												INSTALL SALVAGED MILE MARKER BACK TO BACK ON NEW STOP SIGN POST					
NB	1.846	D	R1-1				STOP						1	X	X									HIGH STREET (TH-4)					
		C	VD-700				MILE MARKER 1030/1410/0182			+	1	1	1																
		AB	D3-1	36	12		 8/11/17	3.00								1		12'-6" X						INSTALL ON TOP OF STOP SIGN		6			
		D	R1-1	30	30			6.25																INSTALL ON RETAINED POST	X				
NB	1.876	A	W11-2				PEDESTRIAN TRAFFIC						1		X														
		A	W16-7pL				LEFT DIAGONAL ARROW PLAQUE						1																
		A	W11-2	30	30	FYG	 8/29/17	6.25								1		13'-6" X						INSTALL SIGN 3.5' BEHIND CURB THINNING AND TRIMMING	X				
		A	W16-7pL	24	12	FYG		2.00																PROVIDE 7' MINIMUM CLEAR HEIGHT	X				
NB	1.911	D	R1-1				STOP						1	X	X														
		C	VD-700				 8/18/17	6.25			1	1	1	1				12'-3" X						INSTALL ON RETAINED POST PROVIDE 7' MINIMUM CLEAR HEIGHT	X				
		D	R1-1	30	30											1								NEW POST AND STREET NAME SIGN INSTALLED AS PART OF LUDLOW BR# 025-1(42) PROJECT					
SIGN SUMMARY SHEET						SHEET TOTALS		30.00	0.00	2	0	1	4	0	0	2		30.0	0	0.0	0.0	0.0	0.0	PROJECT NAME: STATEWIDE-SOUTH REGION					
								SF	SF	EA	EA	EA	EA	EA	EA	EA		FT		EA	LB	LB	LB	LB	PROJECT NUMBER: STPG SIGN(57)				
																										FILE NAME: z16t041Ludlow 103 NB.xls			
VERMONT AGENCY OF TRANSPORTATION						TOWN DIRECTIONAL TOTALS		754.3	0.0	42	13	13	190	0	0	65		945.0	0	0.0				PROJECT MANAGER: D. MUNRO	PLOT DATE: 2/27/2017				
																									DRAWN BY: W. GORDON				
																									CHECKED: BRZEZOWSKI				