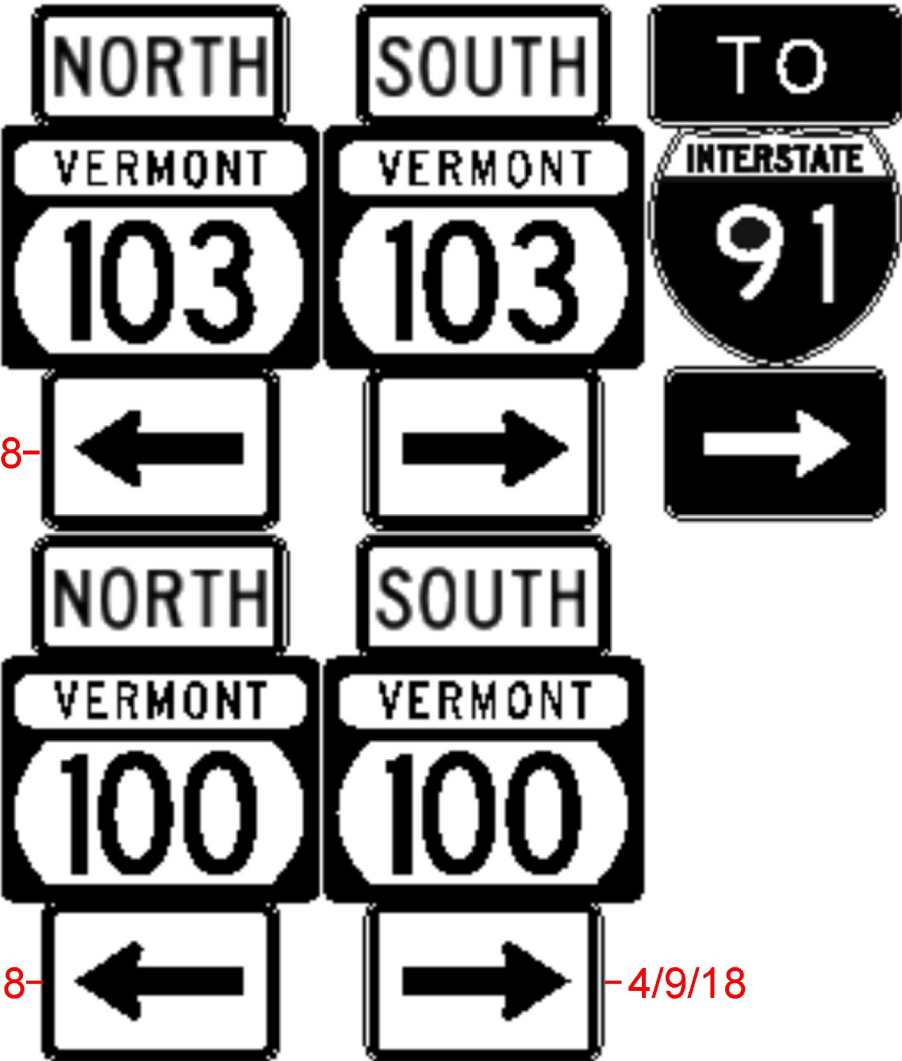


DIRECTION	MILEPOINT	LOCATION CODE (SHEET 4)	SIGN CODE	WIDTH (IN)	HEIGHT (IN)	SHEETING REMARKS	SIGN LEGEND	NEW SIGNS		EXISTING SIGNS				EXIST POST		NUMBER OF NEW POSTS	SQUARE STEEL (IN)			TUBULAR STEEL Ø (IN)				SIGN FRAME REQUIRED	REMARKS	SIGN DETAIL LOCATION					
								"A"	"B"	RETAIN	SALVAGE FROM	SALVAGE TO	REMOVE	RETAIN	REMOVE		1.75	2.00	2.50	FOUNDATION	3.00	3.50	4.00			5.00	SHSM	SIGN DETAILS SHEET #	STANDARD SHEET #		
																	(LB / FT)				(LB / FT)										
																	1.88	2.42	3.35		7.60	9.00	10.80			14.60					
NB LUDLOW VT ROUTE 103							FY-FLUORESCENT YELLOW FYG-FLUORESCENT YELLOW GREEN															"SHSM"-STANDARD HIGHWAY SIGNS AND MARKINGS BOOK									
		C	M6-1				RIGHT ARROW						1																		
		C	M4-5				TO						1																		
		C	M1-1				I-91						1																		
		C	M6-1				RIGHT ARROW						1																		
NB	2.629	C	M3-1	24	12			2.00														3D	INSTALL ON RETAINED POSTS; NORTH, GREEN ON WHITE;	X							
		C	VM1-5	30	24			5.00															SIGN FRAME WILL NEED TO BE MODIFIED TO ACCOMMODATE ASSEMBLY SHOWN				E-136				
		C	M6-1	21	15			2.19																ARROW, GREEN ON WHITE	X						
		C	M3-1	24	12			2.00																NORTH, GREEN ON WHITE	X						
		C	VM1-5	30	24			5.00																				E-136			
		C	M6-1	21	15			2.19																	ARROW, GREN ON WHITE	X					
		C	M3-3	24	12			2.00																	SOUTH, GREEN ON WHITE	X					
		C	VM1-5	30	24			5.00																				E-136			
		C	M6-1	21	15			2.19																	ARROW, GREEN ON WHITE	X					
		C	M3-3	24	12			2.00																	SOUTH, GREEN ON WHITE	X					
		C	VM1-5	30	24				5.00																				E-136		
		C	M6-1	21	15			2.19																							
		C	M3-3	24	12			2.00																							
		C	VM1-5	30	24			5.00																				E-136			
SIGN SUMMARY SHEET						SHEET TOTALS		34.56	0.00	0	0	0	4	0	0	0	0.0			0	0.0	0.0	0.0	0.0	PROJECT NAME: STATEWIDE-SOUTH REGION			PROJECT NUMBER: STPG SIGN(57)			
								SF	SF	EA	EA	EA	EA	EA	EA	EA		FT			EA	LB	LB	LB	LB	FILE NAME: z16t041Ludlow 103 NB.xls			PLOT DATE: 2/27/2017		
						TOWN DIRECTIONAL TOTALS		754.3	0.0	42	13	13	190	0	0	65	945.0			0	0.0				PROJECT MANAGER: D. MUNRO			DRAWN BY: W. GORDON			
						VERMONT AGENCY OF TRANSPORTATION																					DESIGNED BY: P. MCKECHNIE			CHECKED: BRZEZOWSKI	
																							LUDLOW VT-103 NB 20			SHEET 52 OF 264					