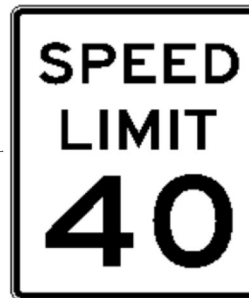
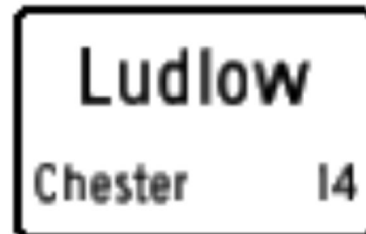


DIRECTION	MILEPOINT	LOCATION CODE (SHEET 4)	SIGN CODE	WIDTH (IN)	HEIGHT (IN)	SHEETING REMARKS	SIGN LEGEND	NEW SIGNS		EXISTING SIGNS				EXIST POST		NUMBER OF NEW POSTS	SQUARE STEEL (IN)			TUBULAR STEEL Ø (IN)				SIGN FRAME REQUIRED	REMARKS	SIGN DETAIL LOCATION			
								"A"	"B"	RETAIN	SALVAGE FROM	SALVAGE TO	REMOVE	RETAIN	REMOVE		1.75	2.00	2.50	FOUNDATION	3.00	3.50	4.00			5.00	SHSM	SIGN DETAILS SHEET #	STANDARD SHEET #
																	(LB / FT)				(LB / FT)								
																	1.88	2.42	3.35		7.60	9.00	10.80			14.60			
SB LUDLOW VT ROUTE 103							FY-FLUORESCENT YELLOW FYG-FLUORESCENT YELLOW GREEN															"SHSM"-STANDARD HIGHWAY SIGNS AND MARKINGS BOOK							
		F	VD-062B				OFFICIAL BUSINESS DIRECTIONAL SIGN			1													Tina's Fun Stuff to Wear right at light						
SB	3.225	F	VD-062B				OFFICIAL BUSINESS DIRECTIONAL SIGN			1				X									Business Symbols						
		F	VD-062B				OFFICIAL BUSINESS DIRECTIONAL SIGN			1													Travel Information ahead on left						
SB	3.196	F	W3-5				 8/22/17						1	X															
		F	W3-5	36	36			9.00															INSTALL SIGN ON RETAINED POSTS	X					
SB	3.121	F	R2-1				 8/22/17						1	X															
		F	R2-1	30	36			7.50															INSTALL SIGN ON RETAINED POST	X					
SB	3.031	F	VD-062B				OFFICIAL BUSINESS DIRECTIONAL SIGN			1				X									Academy Museum left at lt. then 2nd rt.						
		F	VD-062B				OFFICIAL BUSINESS DIRECTIONAL SIGN			1													Catholic Church left at light						
		F	VD-062B				OFFICIAL BUSINESS DIRECTIONAL SIGN			1													Ludlow Police on west hill road						
SB	2.995	F	W3-5				 8/22/17						1	X															
		F	W3-5	36	36			9.00															INSTALL SIGN ON RETAINED POSTS	X					
SB	2.948	F	VD-018A	36	24		 8/22/17	6.00							1		13'-6" X						INSTALL SIGN 250' SOUTH OF EXISTING SIGN AT MP 2.995 SB.			T-95			
SB	2.916	F	W11-2	30	30		 8/24/17	6.25							1		11'-0" X						INSTALL SIGN 315' UPSTATION FROM EXISTING SIGN AT MP 2.856 SB	X					
		F	W16-1P	18	24		 8/24/17	3.00																X					
SIGN SUMMARY SHEET						SHEET TOTALS		40.75	0.00	6	0	0	3	0	0	2	30.0			0	0.0	0.0	0.0	0.0	PROJECT NAME: STATEWIDE-SOUTH REGION				
								SF	SF	EA	EA	EA	EA	EA	EA	EA	FT			EA	LB	LB	LB	LB	PROJECT NUMBER: STPG SIGN(57)				
																								FILE NAME: z16t041Ludlow 103 SB.xls					
VERMONT AGENCY OF TRANSPORTATION						TOWN DIRECTIONAL TOTALS		502.1	0.0	48	5	5	120	0	0	62	870.0			2	217.0				PLOT DATE: 2/27/2017				
																								DRAWN BY: W. GORDON					
																								CHECKED: BRZEZOWSKI					
																								SHEET 65 OF 264					