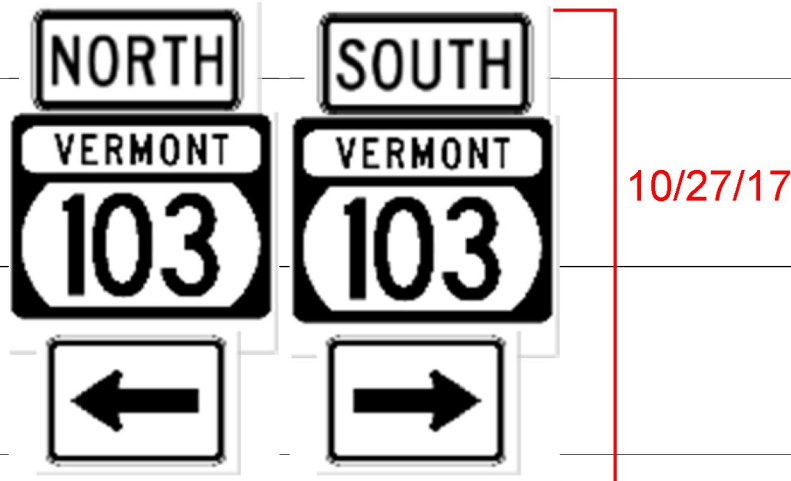


DIRECTION	MILEPOINT	LOCATION CODE (SHEET 4)	SIGN CODE	WIDTH (IN)	HEIGHT (IN)	SHEETING REMARKS	SIGN LEGEND	NEW SIGNS		EXISTING SIGNS				EXIST POST		NUMBER OF NEW POSTS	SQUARE STEEL (IN)			TUBULAR STEEL Ø (IN)				SIGN FRAME REQUIRED	REMARKS	SIGN DETAIL LOCATION				
								"A"	"B"	RETAIN	SALVAGE FROM	SALVAGE TO	REMOVE	RETAIN	REMOVE		1.75	2.00	2.50	FOUNDATION	3.00	3.50	4.00			5.00	SHSM	SIGN DETAILS SHEET #	STANDARD SHEET #	
																	(LB / FT)				(LB / FT)									
																	1.88	2.42	3.35		7.60	9.00	10.80			14.60				
NB WALLINGFORD VT RTE 103							FY-FLUORESCENT YELLOW FYG-FLUORESCENT YELLOW GREEN															"SHSM"-STANDARD HIGHWAY SIGNS AND MARKINGS BOOK								
		C	M6-1				LEFT ARROW						1																	
		C	M3-3				SOUTH						1																	
		C	VM1-5				VERMONT 103						1																	
		C	M6-1				RIGHT ARROW						1																	
		C	M3-1	24	12			2.00														2C	INSTALL ASSEMBLY ON RETAINED POSTS NORTH, GREEN ON WHITE	X						
		C	VM1-5	30	24			5.00																					E-136	
		C	M6-1	21	15			2.19															ARROW, GREEN ON WHITE	X						
		C	M3-3	24	12			2.00															SOUTH, GREEN ON WHITE	X						
		C	VM1-5	30	24			5.00																				E-136		
		C	M6-1	21	15			2.19															ARROW, GREEN ON WHITE	X						
NB	0.262	A	VW-133R				HIDDEN DRIVE RIGHT						1		X															
		A	S3-1				SCHOOL BUS STOP AHEAD						1																	
		A	S3-1	36	36	FYG		9.00								2	14'-0" 13'-9" X							SCHOOL BUS STOP AT MP 0.352	X					
NB	0.286	A	M3-1				NORTH			1				X																
		A	VM1-5				VERMONT 103			1																				
SIGN SUMMARY SHEET							SHEET TOTALS	27.38	0.00	2	0	0	6	0	0	2	30.0			0	0.0	0.0	0.0	0.0	PROJECT NAME: STATEWIDE-SOUTH REGION			PROJECT NUMBER: STPG SIGN(57)		
								SF	SF	EA	EA	EA	EA	EA	EA	EA		FT		EA	LB	LB	LB	LB	FILE NAME: z16t041Wallinaford103 NB.xls			PLOT DATE: 2/27/2017		
																									PROJECT MANAGER: D. MUNRO			DRAWN BY: W. GORDON		
							VERMONT AGENCY OF TRANSPORTATION							TOWN DIRECTIONAL TOTALS	173.8	0.0	14	1	1	33	0	0	23	335.0			0	0.0		
																								WALLINGFORD VT-103 NB 2			SHEET 111 OF 264			