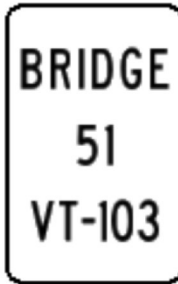
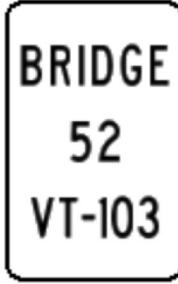


DIRECTION	MILEPOINT	LOCATION CODE (SHEET 4)	SIGN CODE	WIDTH (IN)	HEIGHT (IN)	SHEETING REMARKS	SIGN LEGEND	NEW SIGNS		EXISTING SIGNS				EXIST POST		NUMBER OF NEW POSTS	SQUARE STEEL (IN)			TUBULAR STEEL Ø (IN)				SIGN FRAME REQUIRED	REMARKS	SIGN DETAIL LOCATION					
								"A"	"B"	RETAIN	SALVAGE FROM	SALVAGE TO	REMOVE	RETAIN	REMOVE		1.75	2.00	2.50	FOUNDATION	3.00	3.50	4.00			5.00	SHSM	SIGN DETAILS SHEET #	STANDARD SHEET #		
																	(LB / FT)				(LB / FT)										
																	1.88	2.42	3.35		7.60	9.00	10.80			14.60					
NB SHREWSBURY VT ROUTE 103							FY-FLUORESCENT YELLOW FYG-FLUORESCENT YELLOW GREEN															"SHSM"-STANDARD HIGHWAY SIGNS AND MARKINGS BOOK									
NB	0.622	AB	D3-1				Shrewsbury Library -->			1				X																	
NB	0.714	A	R2-1				SPEED LIMIT 35						1	X																	
		A	R2-1	24	30		 9/14/17	5.00																	INSTALL ON RETAINED POST	X					
NB	0.840	A	R2-1				 9/15/17	5.00					1	X																	
		A	R2-1	24	30																				INSTALL ON RETAINED POST	X					
NB	1.031	A	R2-1				 9/14/17	5.00					1	X																	
		A	R2-1	24	30																				INSTALL ON RETAINED POST	X					
NB	1.087	A	VW-060				HIDDEN DRIVES						1		X																
NB	1.134	A	VD-062B				OFFICIAL BUSINESS DIRECTIONAL SIGN			1				X												SPRING LAKE RANCH					
NB	1.440	A	W1-4	30	30		 9/15/17	6.25								1		14'-0" X								INSTALL ±430' DOWNSTATION OF EXISTING SIGN AT MP 1.522 NB	X				
NB	1.522	A	VD-701				 9/14/17						1		X																
		A	VD-701	6	10			0.42								1		7'-0" X										T-42			
NB	2.055	A	VD-701				 9/14/17						1		X																
		A	VD-701	6	10			0.42								1		7'-3" X										T-42			
SIGN SUMMARY SHEET							SHEET TOTALS	22.08	0.00	2	0	0	6	0	0	3		35.0		0	0.0	0.0	0.0	0.0	PROJECT NAME: STATEWIDE-SOUTH REGION	PROJECT NUMBER: STPG SIGN(57)					
								SF	SF	EA	EA	EA	EA	EA	EA	EA		FT		EA	LB	LB	LB	LB							
							VERMONT AGENCY OF TRANSPORTATION																					FILE NAME: z16t041Shrewsburv103NB.xls	PLOT DATE: 2/27/2017		
							TOWN DIRECTIONAL TOTALS							190.2	0.0	12	1	1	35	0	0	20		290.0		0		0.0		PROJECT MANAGER: D. MUNRO	DRAWN BY: W. GORDON
																							DESIGNED BY: P. MCKECHNIE	CHECKED: BRZEZOWSKI							
																							SHREWSBURY VT-103 NB 3	SHEET 124 OF 264							