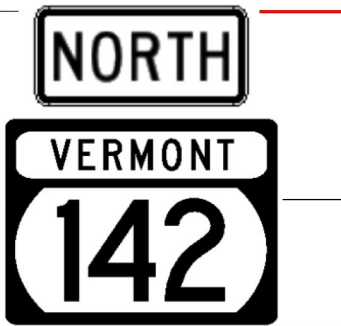


DIRECTION	MILEPOINT	LOCATION CODE (SHEET 4)	SIGN CODE	WIDTH (IN)	HEIGHT (IN)	SHEETING REMARKS	SIGN LEGEND	NEW SIGNS		EXISTING SIGNS				EXIST POST		NUMBER OF NEW POSTS	SQUARE STEEL (IN)			TUBULAR STEEL Ø (IN)				SIGN FRAME REQUIRED	REMARKS	SIGN DETAIL LOCATION					
								"A"	"B"	RETAIN	SALVAGE FROM	SALVAGE TO	REMOVE	RETAIN	REMOVE		1.75	2.00	2.50	FOUNDATION	3.00	3.50	4.00			5.00	SHSM	SIGN DETAILS SHEET #	STANDARD SHEET #		
																	(LB / FT)				(LB / FT)										
																	1.88	2.42	3.35		7.60	9.00	10.80			14.60					
NB VERNON VT ROUTE 142							FY-FLUORESCENT YELLOW FYG-FLUORESCENT YELLOW GREEN															"SHSM"-STANDARD HIGHWAY SIGNS AND MARKINGS BOOK									
NB	3.895	C	R1-1				 11/20/17 STOP							1		X															
		C	R1-1	36	36			9.00							2		13'-3" 13'-3" X								THIS SIGN FACES POND ROAD TRAFFIC	X					
NB	3.904	D	R1-1							1					X										POST OFFICE DRIVE						
NB	3.907	C	W1-7	48	24		 11/20/17	8.00							2		13'-9" 13'-3" X								INSTALL 10 TO 15 FEET NORTH OF STOP SIGN AT MP 3.904 NB; SIGN FACES POND ROAD TRAFFIC	X					
NB	3.920	A	M3-1										1	X																	
		A	VM1-5										1																		
		A	M3-1	24	12		 11/20/17	2.00																	INSTALL ON RETAINED POST NORTH, GREEN ON WHITE	X					
		A	VM1-5	30	24			5.00																			E-136				
NB	3.940-4.129	A	N/A				INSTALL (11) NEW DELINEATOR POSTS 11/21/17																		INSTALL (22) NEW TYPE I WHITE DELINEATORS BACK TO BACK ON 11 NEW POSTS. INSTALL THE FIRST POST 105' UPSTATION FROM EXISTING SIGN AT MP 3.920 NB THEN EVERY 100'			T-40			
NB	3.975	A	R2-1				 11/20/17						1		X																
		A	R2-1	24	30			5.00							1		14'-0" X									X					
NB	4.030	A	W1-5L				 11/20/17 LEFT WINDING ROAD						1		X																
		A	W1-5L	30	30	FY		6.25							1		14'-3" X									X					
NB	4.210	A	W11-1				BICYCLE TRAFFIC						1		X																
SIGN SUMMARY SHEET							SHEET TOTALS	35.25	0.00	1	0	0	6	0	0	6		90.0		0	0.0	0.0	0.0	0.0	PROJECT NAME: STATEWIDE-SOUTH REGION	SIGN DETAIL LOCATION					
								SF	SF	EA	EA	EA	EA	EA	EA	EA		FT		EA	LB	LB	LB	LB	PROJECT NUMBER: STPG SIGN(57)						
							VERMONT AGENCY OF TRANSPORTATION																					FILE NAME: z16t041Vernon142 NB.xls	PLOT DATE: 2/27/2017		
														TOWN DIRECTIONAL TOTALS	615.1	0.0	21	16	16	132	0	0	110		1630.0		0				
																							CHECKED: BRZEWOWSKI	SHEET 159 OF 264							