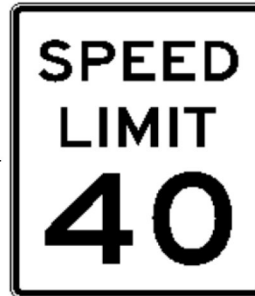
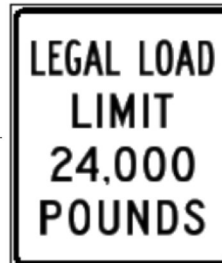


DIRECTION	MILEPOINT	LOCATION CODE (SHEET 4)	SIGN CODE	WIDTH (IN)	HEIGHT (IN)	SHEETING REMARKS	SIGN LEGEND	NEW SIGNS		EXISTING SIGNS				EXIST POST		NUMBER OF NEW POSTS	SQUARE STEEL (IN)			TUBULAR STEEL Ø (IN)				SIGN FRAME REQUIRED	REMARKS	SIGN DETAIL LOCATION						
								"A"	"B"	RETAIN	SALVAGE FROM	SALVAGE TO	REMOVE	RETAIN	REMOVE		1.75	2.00	2.50	FOUNDATION	3.00	3.50	4.00			5.00	SHSM	SIGN DETAILS SHEET #	STANDARD SHEET #			
																	(LB / FT)				(LB / FT)											
																	1.88	2.42	3.35		7.60	9.00	10.80			14.60						
SB VERNON VT ROUTE 142							FY-FLUORESCENT YELLOW FYG-FLUORESCENT YELLOW GREEN															"SHSM"-STANDARD HIGHWAY SIGNS AND MARKINGS BOOK										
		F	W1-10c	36	36	FY	 4/9/18	9.00								2		13'-3" 12'-9" X								X						
		F	W16-8P	30	8	FY			1.67																		4					
SB	4.230	F	W1-4L				 11/20/17					1		X																		
		F	W1-4L	30	30			6.25								1		14'-0" X								X						
SB	4.155	F	R2-1				 11/20/17					1		X																		
		F	R2-1	24	30			5.00								1		13'-3" X								X						
SB	4.028	F					VERNON'S FIRST MEETING HOUSE HISTORIC SIGN			1				X																		
SB	3.985	F					COMBINATION LEFT TURN/ SIDE ROAD					1		X																		
		F	W13-1P				 30 M.P.H. 11/20/17					1																				
		F		36	36	FY		9.00								2		16'-3" 15'-9" X								2						
		F	W13-1P	24	24	FY		4.00																INSTALL ON LEFT POST		X						
SB	3.910	FE	D3-1				11/21/17 Pond Rd				1	1	1		X	1		10'-0" X						POND RD (TH-2) SALVAGE SIGN TO NEW POST AT SAME STATION								
SB	3.908	G	VR-017				 11/20/17						1	X																		
		G	VR-017	24	30			5.00																INSTALL ON RETAINED POST			T-70					
SB	3.895	H	R1-1				STOP						1		X																	
SIGN SUMMARY SHEET							SHEET TOTALS	39.92	0.00	1	1	1	7	0	0	7		105.0		0	0.0	0.0	0.0	0.0	PROJECT NAME: STATEWIDE-SOUTH REGION	PROJECT NUMBER: STPG SIGN(57)			VERMONT AGENCY OF TRANSPORTATION			
								SF	SF	EA	EA	EA	EA	EA	EA	EA		FT		EA	LB	LB	LB	LB								
																															FILE NAME: z16t041Vernon142 SB.xls	PLOT DATE: 2/27/2017
							TOWN DIRECTIONAL TOTALS							485.1	0.0	14	12	12	104	0	0	88		1310.0		0		0.0		PROJECT MANAGER: D. MUNRO	DRAWN BY: W. GORDON	
																							DESIGNED BY: P. MCKECHNIE	CHECKED: BRZEZOWSKI								
																							VERNON VT-142 SB 7	SHEET 175 OF 264								