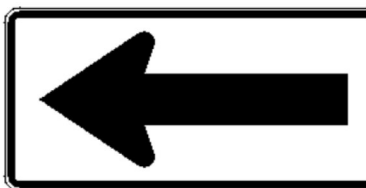


DIRECTION	MILEPOINT	LOCATION CODE (SHEET 4)	SIGN CODE	WIDTH (IN)	HEIGHT (IN)	SHEETING REMARKS	SIGN LEGEND	NEW SIGNS		EXISTING SIGNS				EXIST POST		NUMBER OF NEW POSTS	SQUARE STEEL (IN)			TUBULAR STEEL Ø (IN)				SIGN FRAME REQUIRED	REMARKS	SIGN DETAIL LOCATION							
								"A"	"B"	RETAIN	SALVAGE FROM	SALVAGE TO	REMOVE	RETAIN	REMOVE		1.75	2.00	2.50	FOUNDATION	3.00	3.50	4.00			5.00	SHSM	SIGN DETAILS SHEET #	STANDARD SHEET #				
																	(LB / FT)				(LB / FT)												
																	1.88	2.42	3.35		7.60	9.00	10.80			14.60							
SB VERNON VT ROUTE 142							FY-FLUORESCENT YELLOW FYG-FLUORESCENT YELLOW GREEN															"SHSM"-STANDARD HIGHWAY SIGNS AND MARKINGS BOOK											
		G	VD-700				MILE MARKER 1420 / 1318 / 0393				1		1										SALVAGE MILE MARKER BACK TO BACK WITH PROPOSED STOP SIGN AT SAME LOCATION										
		H	R1-1	36	36		 11/20/17	9.00							2		12'-6" 12'-3" X							X									
		G	VD-700				MILE MARKER 1420 / 1318 / 0393					1																					
SB	3.880	F	W1-6L				 11/20/17	8.00					1		X	2	12'-9" 11'-6" X							X									
		F	W1-6L	48	24	FY																											
SB	3.860	F	M3-3				 11/20/17	2.00 5.00					1		X	1	10'-0" X							X									
		F	VM1-5											1																			
		F	M3-3	24	12																												
		F	VM1-5	30	24																							E-136					
SB	3.825	E	W1-6R				 11/20/17	8.00					1	✖	X	2	12'-9" 10'-6" X																
		E	W1-6R	48	24	FY																				X							
SB	3.735	F	R2-1				 11/20/17	5.00					1		X	1	13'-6" X																
		F	R2-1	24	30																					X							
SB	3.470	FE	D3-1				PVT T Bird Dr				1			X																			
SB	3.427	F	W11-8				EMERGENCY VEHICLES					1		X																			
SIGN SUMMARY SHEET							SHEET TOTALS			37.00	0.00	1	1	1	7	0	0	6	90.0			0	0.0	0.0	0.0	PROJECT NAME: STATEWIDE-SOUTH REGION							
										SF	SF	EA	EA	EA	EA	EA	EA	EA		FT		EA	LB	LB	LB	LB				PROJECT NUMBER: STPG SIGN(57)			
																												FILE NAME: z16t041Vernon142 SB.xls			PLOT DATE: 2/27/2017		
							VERMONT AGENCY OF TRANSPORTATION			TOWN DIRECTIONAL TOTALS			485.1	0.0	14	12	12	104	0	0	88	1310.0			0	0.0			PROJECT MANAGER: D. MUNRO			DRAWN BY: W. GORDON	
																								DESIGNED BY: P. MCKECHNIE			CHECKED: BRZEZOWSKI						
																								VERNON VT-142 SB 8			SHEET 176 OF 264						