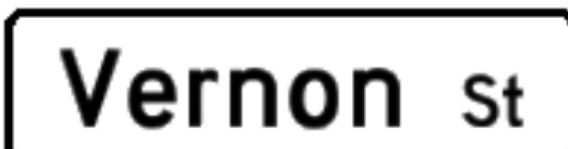


DIRECTION	MILEPOINT	LOCATION CODE (SHEET 4)	SIGN CODE	WIDTH (IN)	HEIGHT (IN)	SHEETING REMARKS	SIGN LEGEND	NEW SIGNS		EXISTING SIGNS				EXIST POST		NUMBER OF NEW POSTS	SQUARE STEEL (IN)			TUBULAR STEEL Ø (IN)				SIGN FRAME REQUIRED	REMARKS	SIGN DETAIL LOCATION					
								"A"	"B"	RETAIN	SALVAGE FROM	SALVAGE TO	REMOVE	RETAIN	REMOVE		1.75	2.00	2.50	FOUNDATION	3.00	3.50	4.00			5.00	SHSM	SIGN DETAILS SHEET #	STANDARD SHEET #		
																	(LB / FT)				(LB / FT)										
																	1.88	2.42	3.35		7.60	9.00	10.80			14.60					
SB BRATTLEBORO VT ROUTE 142							FY-FLUORESCENT YELLOW FYG-FLUORESCENT YELLOW GREEN															"SHSM"-STANDARD HIGHWAY SIGNS AND MARKINGS BOOK									
SB	2.137	F	R2-1				SPEED LIMIT 25						1		X								NOTE: BEGIN CLASS 1 TOWN HIGHWAY. STICKERS ON BACK OF SIGN SHALL READ "BRATTLEBORO", NOT "VAOT"								
		F	M3-3	24	12		 11/13/17	2.00								1	13'-0" X						THINNING AND TRIMMING SOUTH, GREEN ON WHITE	X							
		F	VM5-1	30	24		 11/13/17	5.00																	E-136						
SB	2.093	F	R2-1	24	30		 11/8/17	5.00								1	10'-3" X						INSTALL SIGN ±230' DOWNSTATION FROM EXISTING SIGN AT MP 2.137 SB	X							
SB	1.873	F	W3-3	30	30			6.25								1	10'-3" X						INSTALL SIGN AT BREAK IN RETAINING WALL, ±470' UPSTATION FROM EXISTING SIGN AT MP 1.784 SB	X							
SB	1.784	G	W14-2				NO OUTLET			1				X									ROYAL RD (TH-496)								
SB	1.772	GH	D3-1									1		X																	
		FE	D3-1									1																			
		GH	D3-1	42	12		 11/8/17	3.50								1	11'-0" X						VERNON ST, INSTALL ON TOP OF ROYAL RD SIGN WITH 12" BRACKET		8						
		FE	D3-1	38	12		 11/8/17	3.17																	8						
SB	1.720	F	R2-1				  LATE 2017	SPEED LIMIT 25				1		X									TOWN INSTALLED NEW SPEED LIMIT SIGNS LATE 2017								
SB	1.709	F	R2-1	24	30			5.00								1	13'-0" X						INSTALL SIGN ±60' DOWNSTATION FROM EXISTING SIGN AT MP 1.720 SB	X							
SB	1.515	F	M3-3				SOUTH					1		X																	
		F	VM5-1				VERMONT 142					1																			
SIGN SUMMARY SHEET							SHEET TOTALS	29.92	0.00	1	0	0	6	0	0	5		75.0		0	0.0	0.0	0.0	0.0	PROJECT NAME: STATEWIDE-SOUTH REGION	PROJECT NUMBER: STPG SIGN(57)					
								SF	SF	EA	EA	EA	EA	EA	EA	EA		FT		EA	LB	LB	LB	LB							
																												FILE NAME: z16t041Brattleboro142 SB.xls	PLOT DATE: 2/27/2017		
							VERMONT AGENCY OF TRANSPORTATION	TOWN DIRECTIONAL TOTALS	140.3	0.0	1	1	1	25	0	0	23		345.0		0		0.0						PROJECT MANAGER: D. MUNRO	DRAWN BY: W. GORDON	
																							DESIGNED BY: P. MCKECHNIE	CHECKED: BRZEZOWSKI							
																							BRATTLEBORO VT-142 SB 1	SHEET 192 OF 264							