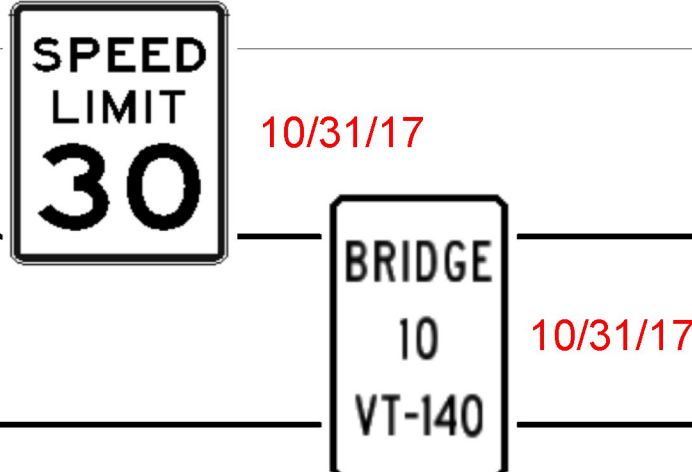


DIRECTION	MILEPOINT	LOCATION CODE (SHEET 4)	SIGN CODE	WIDTH (IN)	HEIGHT (IN)	SHEETING REMARKS	SIGN LEGEND	NEW SIGNS		EXISTING SIGNS				EXIST POST		NUMBER OF NEW POSTS	SQUARE STEEL (IN)			TUBULAR STEEL Ø (IN)				SIGN FRAME REQUIRED	REMARKS	SIGN DETAIL LOCATION			
								"A"	"B"	RETAIN	SALVAGE FROM	SALVAGE TO	REMOVE	RETAIN	REMOVE		1.75	2.00	2.50	FOUNDATION	3.00	3.50	4.00			5.00	SHSM	SIGN DETAILS SHEET #	STANDARD SHEET #
																	(LB / FT)				(LB / FT)								
																	1.88	2.42	3.35		7.60	9.00	10.80			14.60			
WB WALLINGFORD VT RTE 140							FY-FLUORESCENT YELLOW FYG-FLUORESCENT YELLOW GREEN															"SHSM"-STANDARD HIGHWAY SIGNS AND MARKINGS BOOK							
		G	VM5-1				VERMONT 155			1																			
		G	M6-1L				LEFT ARROW			1																			
		G	M3-2				EAST			1																			
		G	VM5-1				VERMONT 140			1																			
		G	M6-1R				RIGHT ARROW			1																			
		G	M4-5				TO			1																			
		G	VM5-1				VERMONT 103			1																			
		G	M6-1R				RIGHT ARROW			1																			
WB	6.244	F	R2-1				SPEED LIMIT 30						1	X															
		F	VD-701				BRIDGE / 10 / VT 140						1																
		F	R2-1	24	30			5.00																INSTALL NEW SIGN ON RETAINED POST	X				
WB	6.243	F	VD-701	6	10			0.42							1		7'-6" X											T-42	
WB	6.204	F	VD1-1A				(UP) Wallingford 6			1				X															
		F	M3-4				WEST			1																			
		F	VM5-1				VERMONT 140			1																			
SIGN SUMMARY SHEET							SHEET TOTALS	5.42	0.00	11	0	0	2	0	0	1	10.0			0	0.0	0.0	0.0	0.0	PROJECT NAME: STATEWIDE-SOUTH REGION	PROJECT NUMBER: STPG SIGN(57)			VERMONT AGENCY OF TRANSPORTATION
								SF	SF	EA	EA	EA	EA	EA	EA	EA		FT		EA	LB	LB	LB	LB					
																											FILE NAME: z16t041Wallinaford140WB.xls	PLOT DATE: 2/27/2017	
														TOWN DIRECTIONAL TOTALS	572.0	0.0	35	2	2	128	0	0	93	1325.0			2	183.0	
																							DESIGNED BY: P. MCKECHNIE	CHECKED: BRZEZOWSKI					
																							WALLINGFORD VT-140 WB 2					SHEET 216 OF 264	