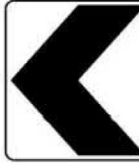
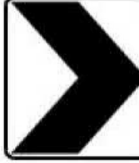


DIR	MILEPOINT	LOCATION CODE	MUTCD CODE	WIDTH	HEIGHT	SHEETING REMARKS	SIGN LEGEND	NEW SIGNS		EXISTING SIGNS				EXIST POST		NUMBER OF NEW POSTS	SQUARE STEEL (in)			TUBULAR STEEL Ø (IN)				SIGN FRAME REQUIRED	REMARKS	SIGN DETAIL			
								"A"	"B"	RETAIN	SALVAGE FROM	SALVAGE TO	REMOVE	RETAIN	REMOVE		1.75	2.00	2.50	FOUNDATION	3.00	3.50	4.00			5.00	DETAIL IN SHSM	DETAIL ON SHEET NUMBER	DETAIL ON STD SHEET NUMBER
																	(LB / FT)				(LB / FT)								
																	1.88	2.42	3.35		7.60	9.00	10.80			14.60			
ST ALBANS TOWN			VT36	EB		FYG-FLUORESCENT YELLOW-GREEN																"SHSM" - STANDARD HIGHWAY SIGNS AND MARKINGS							
	4.691	A	W13-1P	18	18		35 MPH SCHOOL BUS STOP AHEAD	9.00									15.00 X 15.75												
EB	4.730	A	VW-054L	30	30			6.25										1	210					INSTALL SIGN ASSEMBLY 315 FEET EAST OF EXISTING ASSEMBLY			T-80		
		A	W1-10L	30	30			6.25																X					
		A	W13-1P	18	18			2.25																X					
EB	4.760	A	W1-8L	18	24		CHEVRON						1	1										BACK TO BACK					
		B	W1-8R	18	24		CHEVRON						1											BACK TO BACK					
		A	W1-8L	18	24			3.00																X					
EB	4.761	B	W1-8R	18	24			3.00							1	13.25 X								INSTALL SIGN 5 FEET FROM COMPLEMENTARY CHEVRON SIGN	X				
EB	4.775	A	W1-8L	18	24		CHEVRON						1	1										BACK TO BACK					
		B	W1-8R	18	24		CHEVRON						1											BACK TO BACK					
EB	4.783	A	W1-8L	18	24			3.00							1	11.75 X								INSTALL SIGN 40 FEET WEST FROM EXISTING TO MAINTAIN 120 FOOT SIGN SPACING	X				
EB	4.784	B	W1-8R	18	24			3.00							1	12.00 X								INSTALL SIGN 5 FEET FROM COMPLEMENTARY CHEVRON SIGN	X				
EB	4.790	A	W1-8L	18	24		CHEVRON						1	1										BACK TO BACK					
		B	W1-8R	18	24		CHEVRON						1											BACK TO BACK					
EB	4.805	A	W1-8L	18	24		CHEVRON						1	1										BACK TO BACK					
SIGN SUMMARY SHEET							SHEET TOTALS		26.75	0.00	0	0	0	8	2	2	3	45		1	210			PROJECT NAME: STATEWIDE- NORTHWEST					
									SF	SF	EA	EA	EA	EA	EA	EA	EA	FT				17.25'	131.1 LBS		PROJECT NUMBER: STPG SIGN (58)				
									35.75					7				67.75								FILE NAME: z16T042 VT36-ST ALBANS EB. PLOT DATE: 3/10/2017			
							TOWN TOTALS		326.25	0.00	76	7	7	62	52	29	45	675		1	210				PROJECT MANAGER: B. BRESLEND DRAWN BY: O. DALMER				
VERMONT AGENCY OF TRANSPORTATION																							DESIGNED BY: O. DALMER CHECKED BY: B. BRESLEND						
																							ST ALBANS TOWN VT36 EB 13 SHEET 26 OF 146						