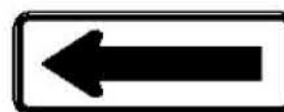


DIR	MILEPOINT	LOCATION CODE	MUTCD CODE	WIDTH	HEIGHT	SHEETING REMARKS	SIGN LEGEND	NEW SIGNS		EXISTING SIGNS				EXIST POST		NUMBER OF NEW POSTS	SQUARE STEEL (in)			TUBULAR STEEL Ø (IN)				SIGN FRAME REQUIRED	REMARKS	SIGN DETAIL			
								"A"	"B"	RETAIN	SALVAGE FROM	SALVAGE TO	REMOVE	RETAIN	REMOVE		1.75	2.00	2.50	FOUNDATION	3.00	3.50	4.00			5.00	DETAIL IN SHSM	DETAIL ON SHEET NUMBER	DETAIL ON STD SHEET NUMBER
																	(LB / FT)				(LB / FT)								
																	1.88	2.42	3.35		7.60	9.00	10.80			14.60			
FAIRFIELD			VT36	EB		FYG-FLUORESCENT YELLOW-GREEN																"SHSM" - STANDARD HIGHWAY SIGNS AND MARKINGS							
EB	8.818	A	W1-2L	30	30		LEFT CURVE						1		1														
		A	W13-1P	18	18		35 MPH						1																
EB	8.868	A	W1-2L	30	30			6.25	SIGN DAMAGED & REPLACED				1			1		15.25	X					INSTALL SIGN ASSEMBLY 260 FEET EAST OF EXISTING SIGN ASSEMBLY	X				
		A	W13-1P	18	18			2.25																X					
EB	8.913	A	W1-6L	48	24			8.00								2		12.00	X	12.25				INSTALL SIGNS 500 FEET EAST OF EXISTING "LEFT CURVE" SIGN ASSEMBLY AND 10 FEET APART FROM EACH OTHER	X				
EB	8.915	A	W1-6R	48	24			8.00								2		11.75	X	12.25					X				
EB	9.118	A	VR2-5A	24	30		REDUCED SPEED AHEAD						1		1									REQUIRES VEGETATION CLEARING					
		A	W3-5	36	36			9.00								2		14.00	X	15.25					X				
EB	9.173	A	VD-018A	36	24			6.00								2		14.00	X	15.50					INSTALL SIGN 210 FEET WEST OF EXISTING "SPEED LIMIT 35" SIGN			T-95	
EB	9.213	A	R2-1	24	30		SPEED LIMIT 35						1		1														
		A	R2-1	30	36			7.50								1		14.75	X						X				
EB	9.273	C	VR-017	24	30		LLL 24,000 LBS						1		1									TH 49					
		C	W12-2	36	36		LOW CLEARANCE - 8'-0"				1		1											TH 49					
		C	VR-017	24	30			5.00								1		16.75	X					TH 49			T-70		
EB	9.273	C	W5-3	36	36		ONE LANE BRIDGE			1				2										TH 49					
SIGN SUMMARY SHEET							SHEET TOTALS		52.00	0.00	1	1	0	-5	2	4	11	465							PROJECT NAME: STATEWIDE- NORTHWEST				
									SF	SF	EA	EA	EA	EA	EA	EA	EA	FT							PROJECT NUMBER: STPG SIGN (58)				
									58.25					7				153.75							FILE NAME: z16T042 VT36-FAIRFIELD EB.x				
							TOWN TOTALS		461.50	0.00	25	16	16	87	32	60	92	1380							PLOT DATE: 3/10/2017				
VERMONT AGENCY OF TRANSPORTATION																								DRAWN BY: O. DALMER					
																								CHECKED BY: B. BRESLEND					
																								FAIRFIELD VT36 EB 11					
																								SHEET 52 OF 146					