


STATE OF VERMONT
AGENCY OF TRANSPORTATION

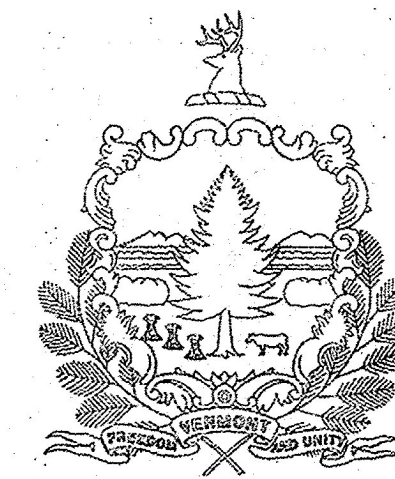



PROPOSED IMPROVEMENT
TOWNS OF STARKSBORO AND BUELS GORE
COUNTY OF ADDISON & CHITTENDEN
VT ROUTE 17 - MAJOR COLLECTOR

BEGINNING IN THE TOWN OF STARKSBORO ON VT RTE 17 AT MM 2.050
AND EXTENDING EASTERLY ALONG VT RTE 17 A DISTANCE OF 6.104 MILES
TO MM 2.745 IN THE TOWN OF BUELS GORE.

	LENGTH (FEET) (MILES)
TOWN OF STARKSBORO MM 2.050 TO MM 5.409	17735.52 = 3.359
TOWN OF BUELS GORE MM 0.000 TO MM BT 2.745	14493.60 = 2.745
PROJECT TOTALS	32229.12 = 6.104

WORK TO BE PERFORMED UNDER THIS PROJECT INCLUDES COLD PLANING, RESURFACING EXISTING
HIGHWAY WITH A BITUMINOUS CONCRETE LEVELING COURSE AND A WEARING COURSE, NEW GUARDRAIL,
PAVEMENT MARKINGS, DRAINAGE IMPROVEMENTS, AND OTHER HIGHWAY RELATED ITEMS.

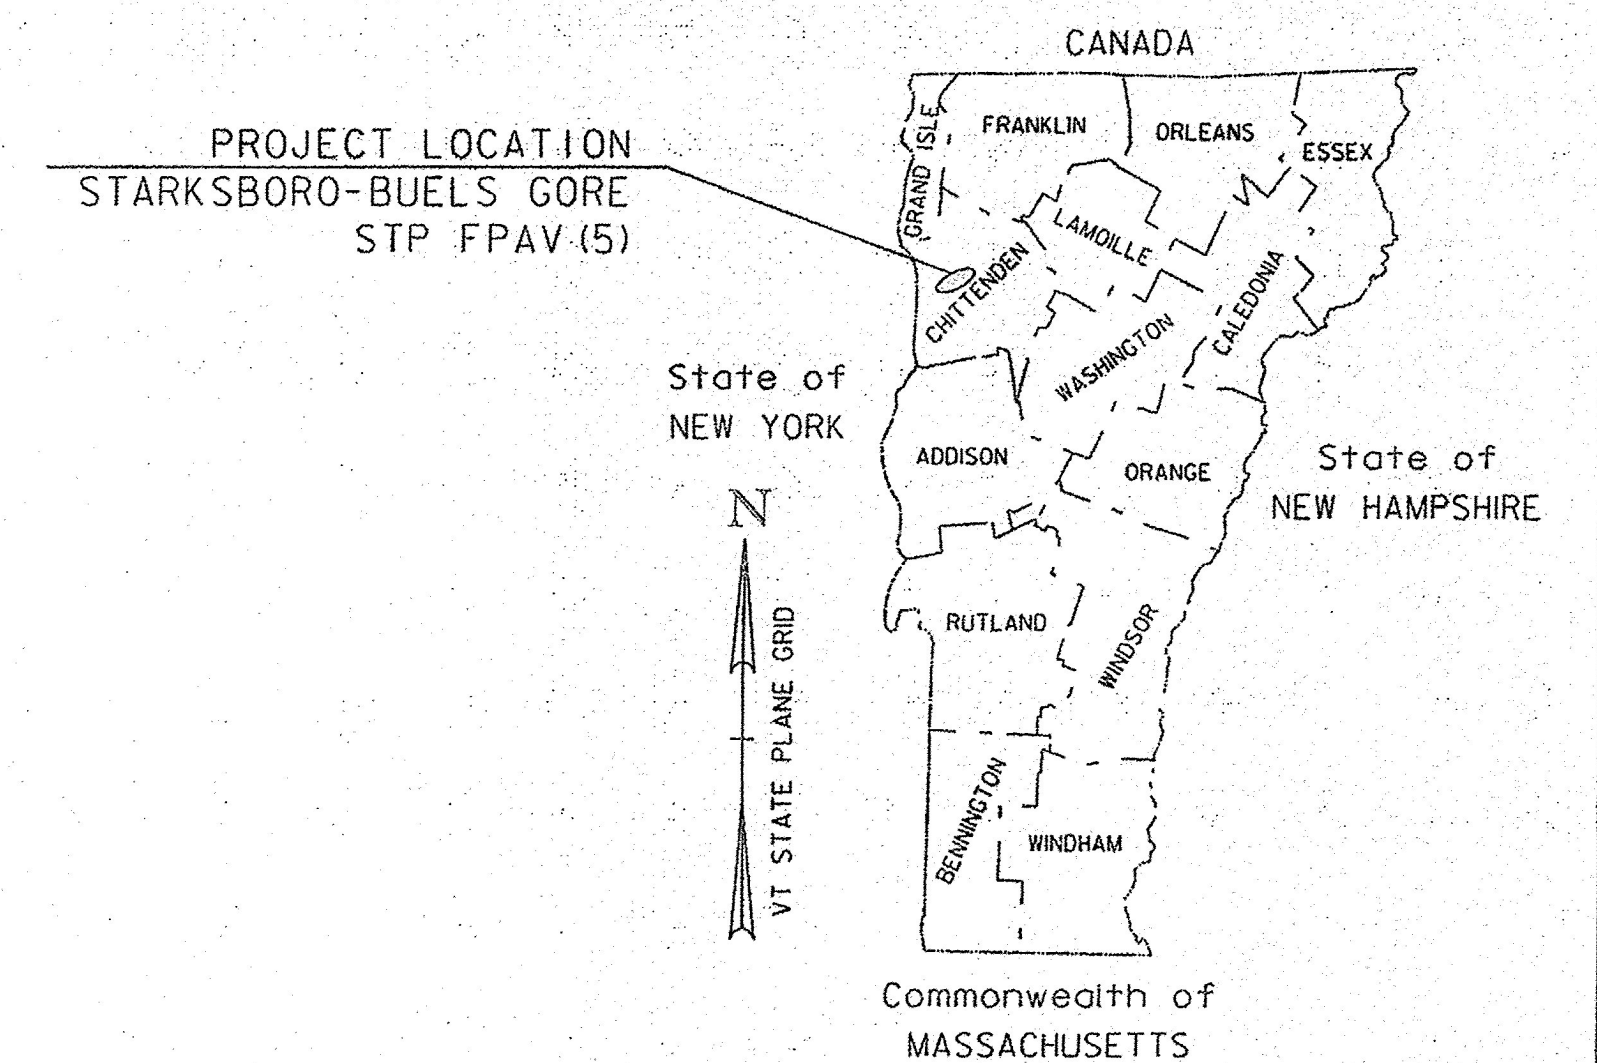


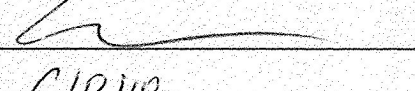RECORD PLANS	
CONTRACTOR:	PIKE INDUSTRIES, INC. - BERLIN, VT
RESIDENT ENGINEER:	CHRIS ACHILLES
CONSTRUCTION BEGAN:	AUGUST 29, 2016
CONSTRUCTION COMPLETE:	NOVEMBER 10, 2016
RECORD PLANS BY:	CHRIS ACHILLES & AARON WEAVER
I HEREBY CERTIFY THAT ALL THE CONSTRUCTION REQUIRED BY THIS SET OF DRAWINGS HAS BEEN ACCOMPLISHED AS INDICATED HEREIN.	
BY	 RESIDENT ENGINEER
DATE	6/8/16
NOTE: Any further information concerning final quantities, amounts or other details relative to this project may be found by contacting Vtrans Records Management.	

CONSTRUCTION IS TO BE CARRIED ON IN ACCORDANCE WITH THESE PLANS AND THE STANDARD SPECIFICATIONS FOR CONSTRUCTION DATED 2011, AS APPROVED BY THE FEDERAL HIGHWAY ADMINISTRATION ON JULY 20, 2011 FOR USE ON THIS PROJECT, INCLUDING ALL SUBSEQUENT REVISIONS AND SUCH REVISED SPECIFICATIONS AND SPECIAL PROVISIONS AS ARE INCORPORATED IN THESE PLANS.


QUALITY ASSURANCE PROGRAM : LEVEL 3	
SURVEYED BY :	N/A
SURVEYED DATE :	N/A
DATUM	
VERTICAL	N/A
HORIZONTAL	N/A


BEGIN STP FPAV (5)
STARKSBORO MM 2.050

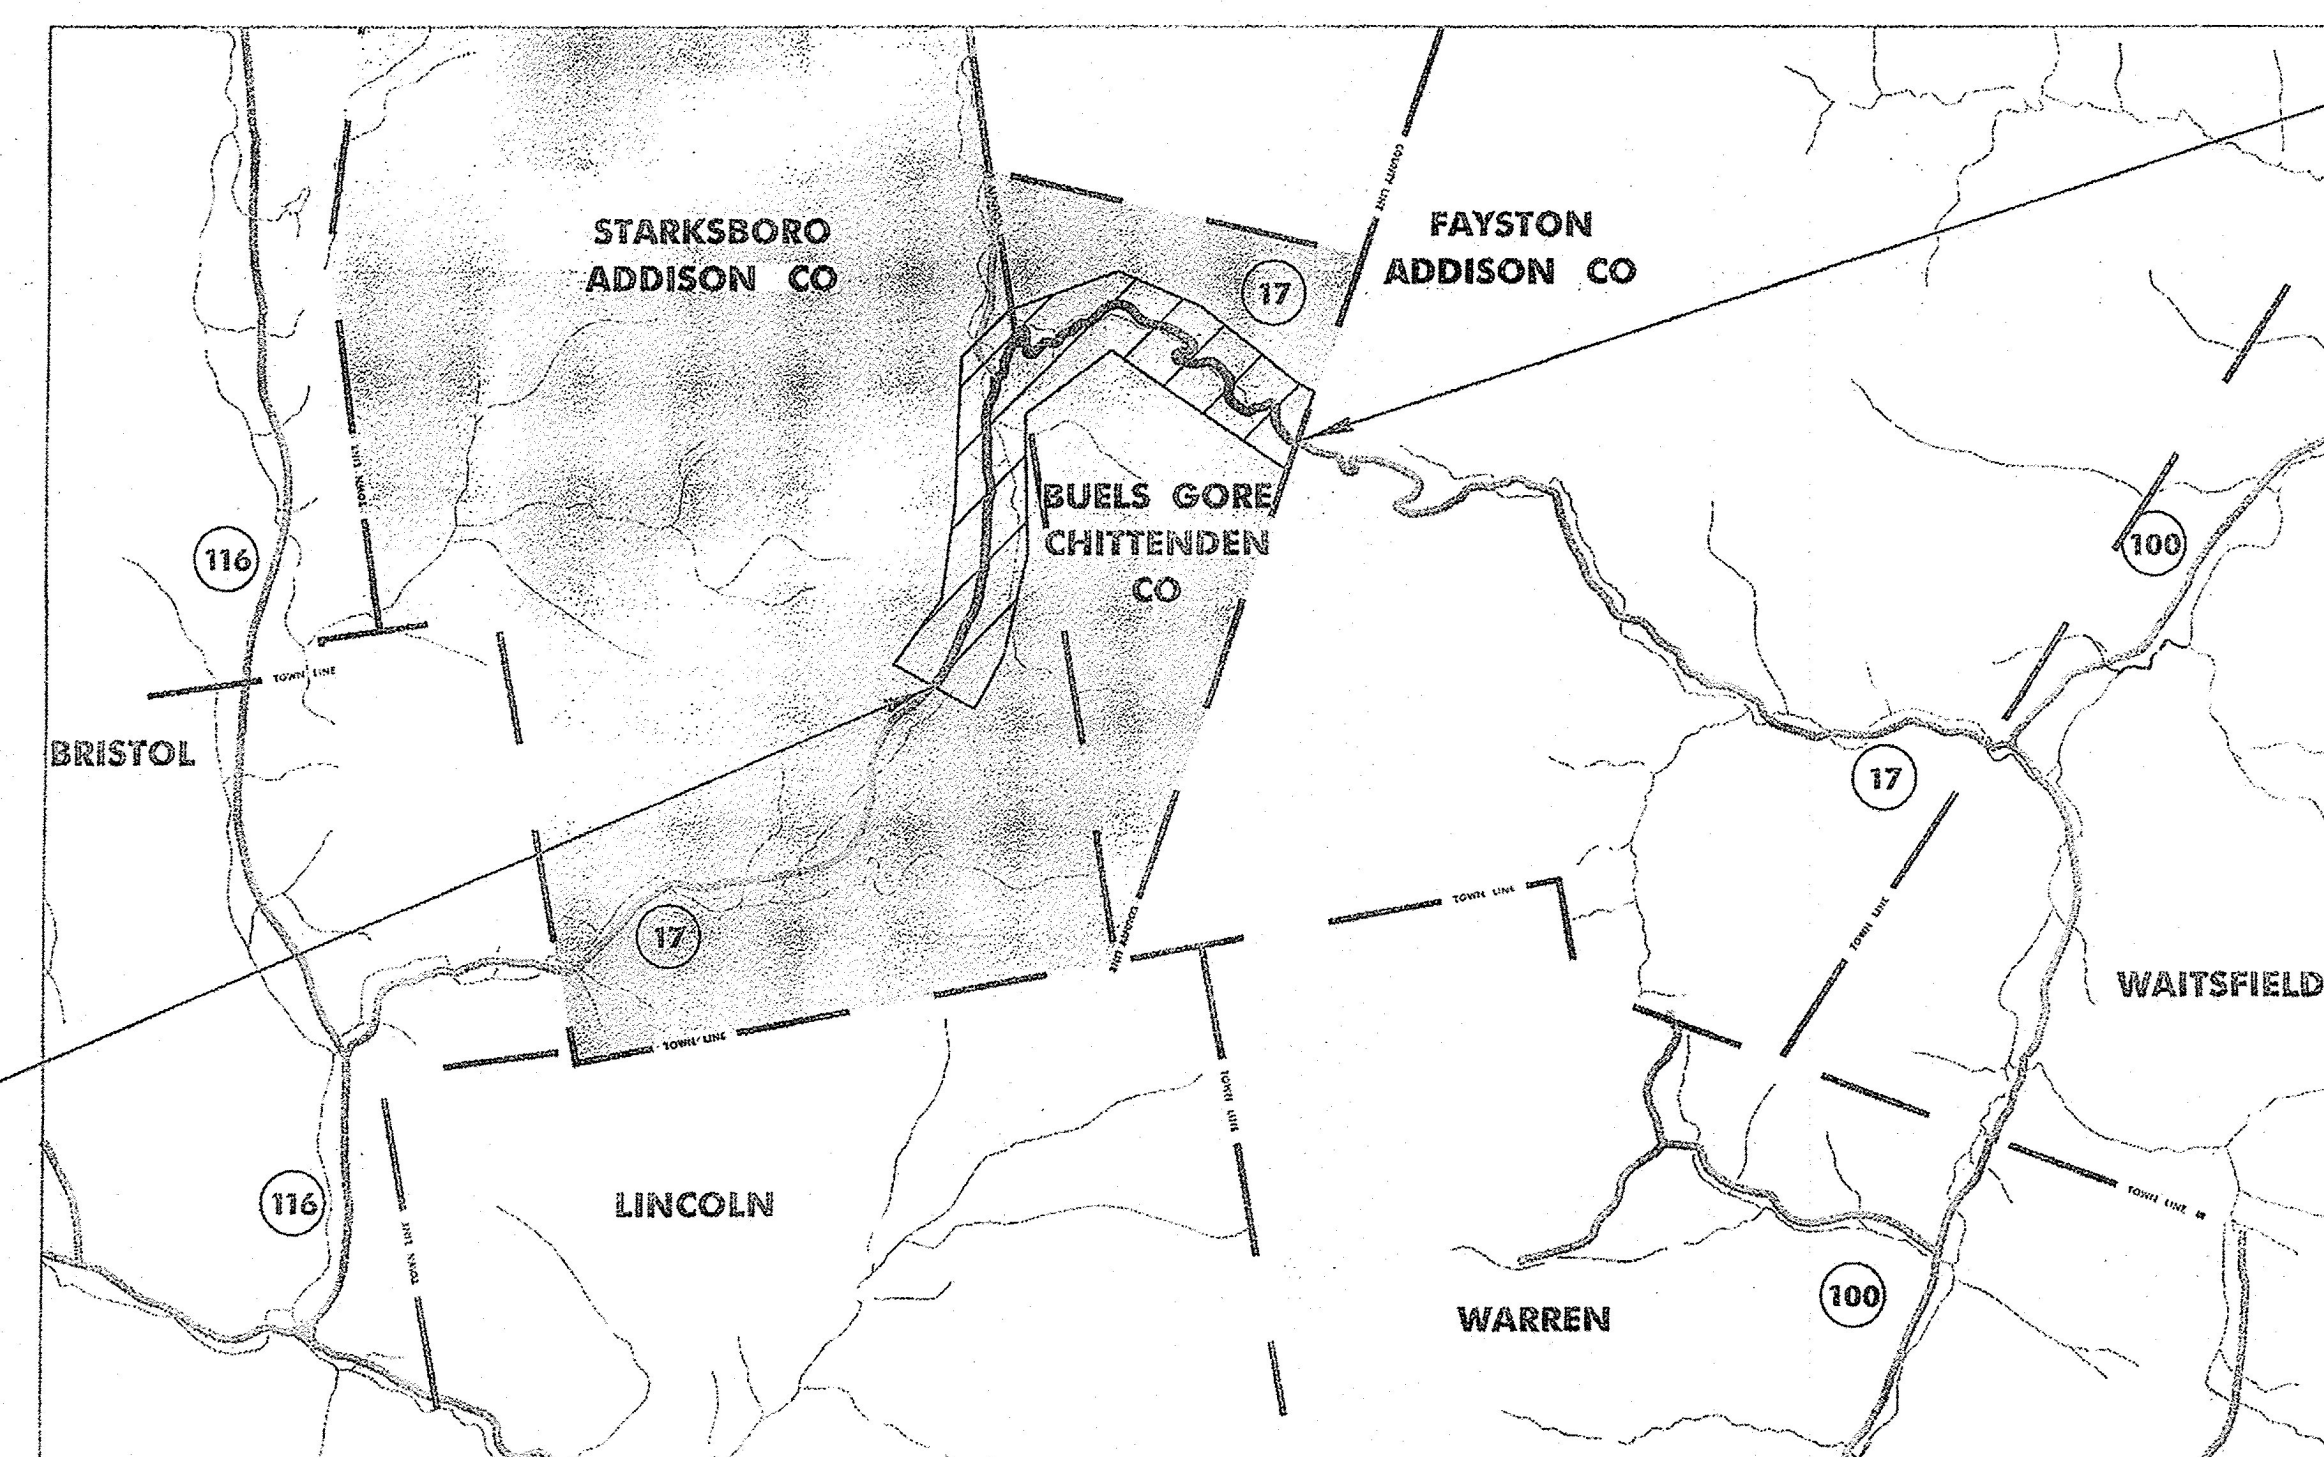

END STP FPAV (5)
BUELS GORE MM 2.745

DuBois & King Inc.

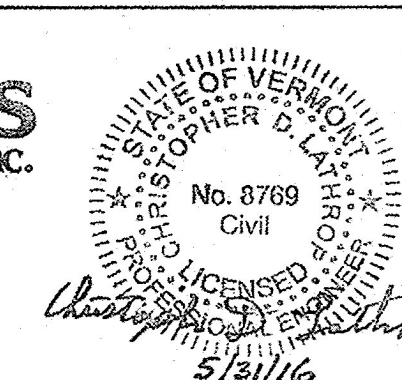

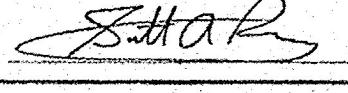DIRECTOR OF PROJECT DELIVERY	
APPROVED 	DATE 6/6/16
PROJECT MANAGER : MICHAEL J. FOWLER, P.E.	
PROJECT NAME : STARKSBORO-BUELS GORE	
PROJECT NUMBER : STP FPAV(5)	
SHEET 1 OF 22 SHEETS	