
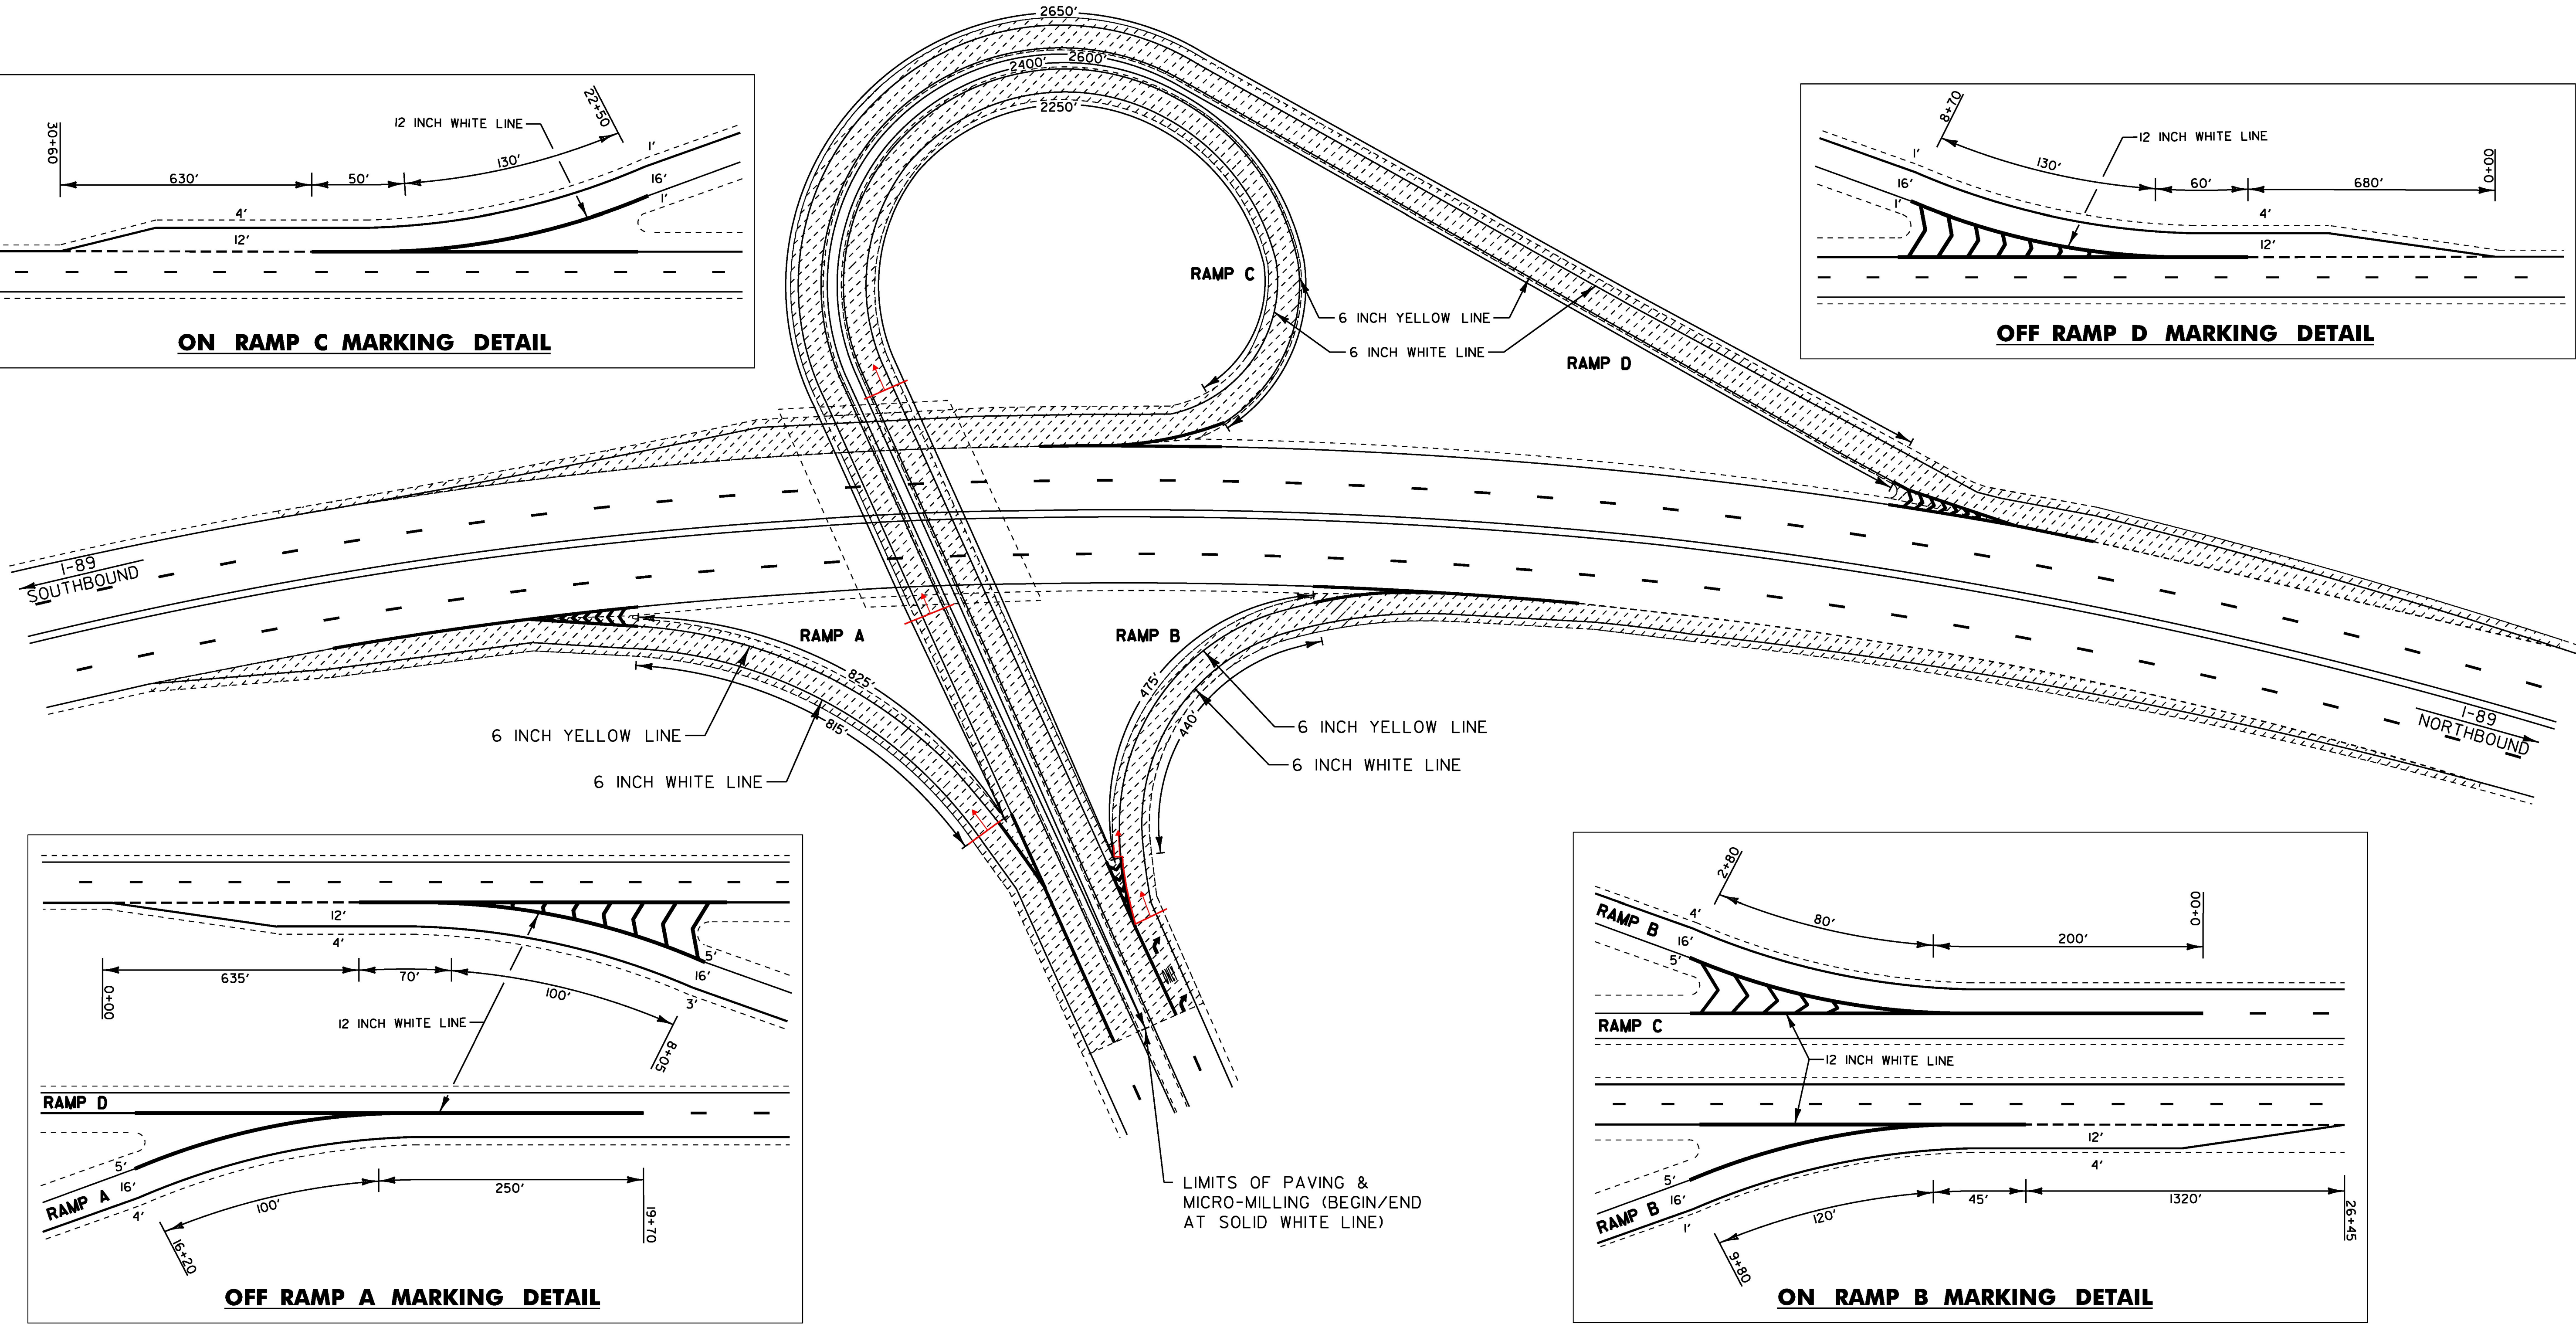
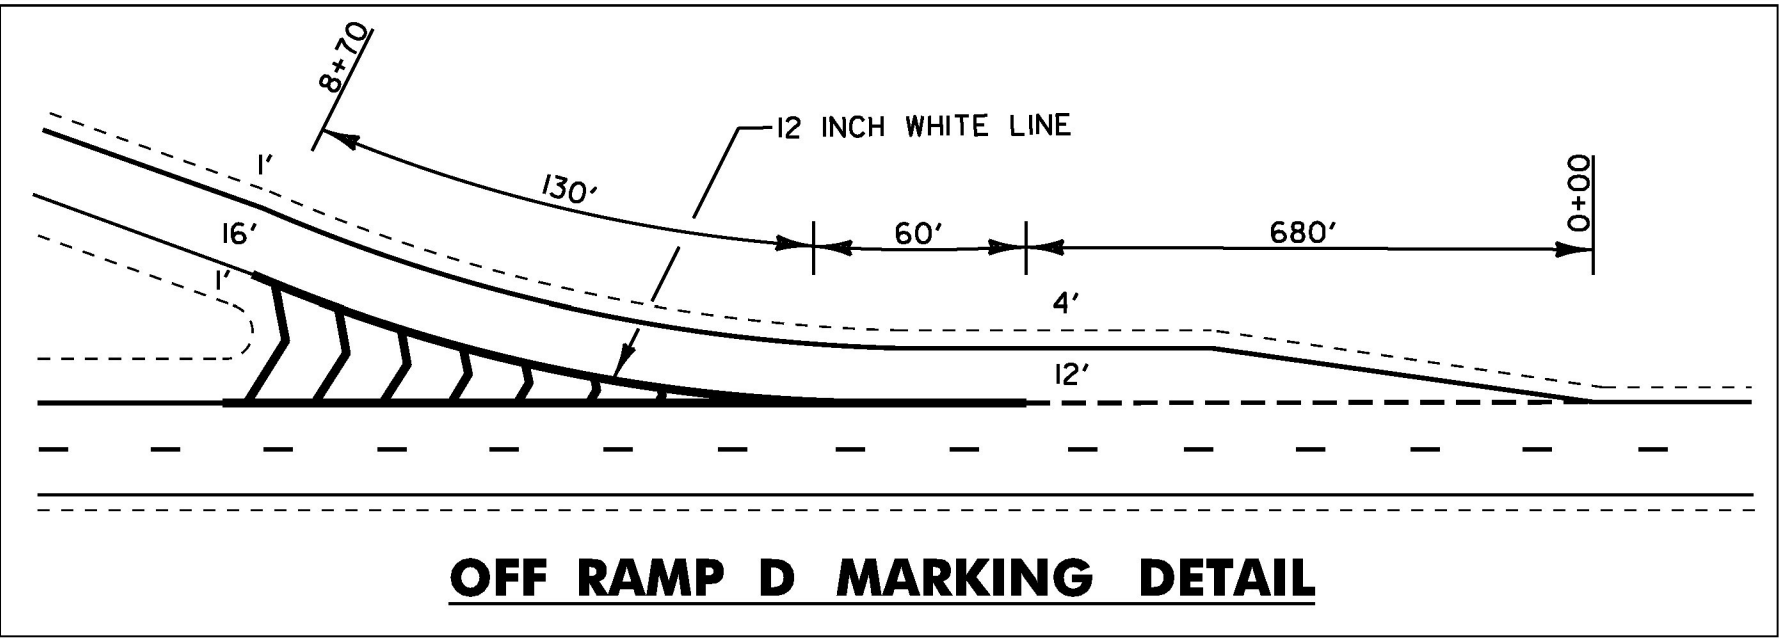


TEMPORARY 6 INCH WHITE LINE &
DURABLE 6 INCH WHITE LINE, (SEE OPTION ITEM)
RAMP A - SOLID RT (1165')
RAMP A - DOTTED (635')
RAMP B - SOLID RT (720')
RAMP B - DOTTED (1320')
RAMP C - SOLID RT (2250')
RAMP D - SOLID RT (2650')
RAMP D - DOTTED (630')



TEMPORARY 6 INCH YELLOW LINE &
DURABLE 6 INCH YELLOW LINE, (SEE OPTION ITEM)
RAMP A - SOLID LT (825')
RAMP B - SOLID LT (475')
RAMP C - SOLID LT (2600')
RAMP D - SOLID LT (2400')

TEMPORARY 12 INCH WHITE LINE &
DURABLE 12 INCH WHITE LINE, (SEE OPTION ITEM)
RAMP A - GORE AREA ~~(800')~~ 348'
RAMP B - GORE AREA ~~(700')~~ 329'
RAMP C - GORE AREA ~~(260')~~ 301'
RAMP D - GORE AREA ~~(450')~~ 416'

TEMPORARY LETTER OR SYMBOL, PAINT &
DURABLE LETTER OR SYMBOL (OPTION BID ITEM)
RAMP B - "R" (1 EACH)
RAMP B - "ONLY" (4 EACH)
RAMP B - "R" (1 EACH)

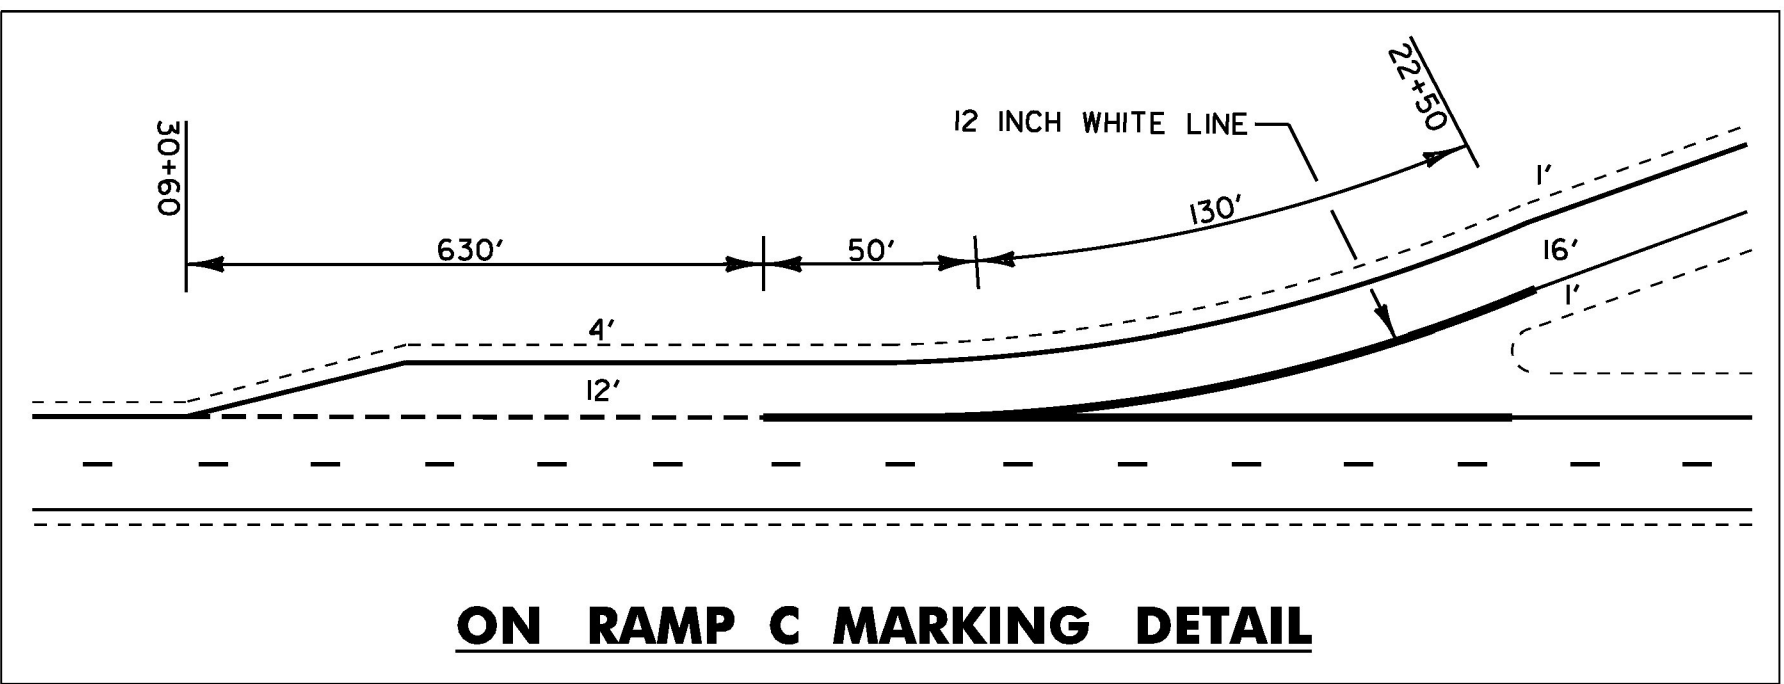

LEGEND: MICRO-MILLING AREA FOR RAMPS

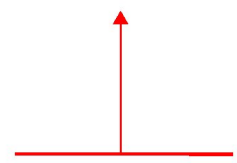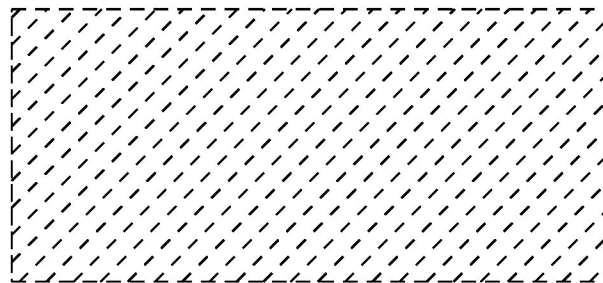

= LIMITS OF
MICRO-MILLING
AND PPST

EXIT 8 RAMP DETAILS

NOTE: SEE PAVEMENT MARKING DETAIL SHEET 4 FOR ADDITIONAL MARKING DETAILS

NOT TO SCALE

PROJECT NAME: MONTPELIER-WATERBURY
PROJECT NUMBER: IM SURF(59)

FILE NAME: pl6v098 Montpelier-Water.dgn PLOT DATE: 20-MAR-2018
PROJECT LEADER: M. BOGACZYK DRAWN BY: N. PAPPAS
DESIGNED BY: N. PAPPAS CHECKED BY: M. BOGACZYK
PAVEMENT MARKING DETAIL SHEET 2 SHEET 16 OF 34