
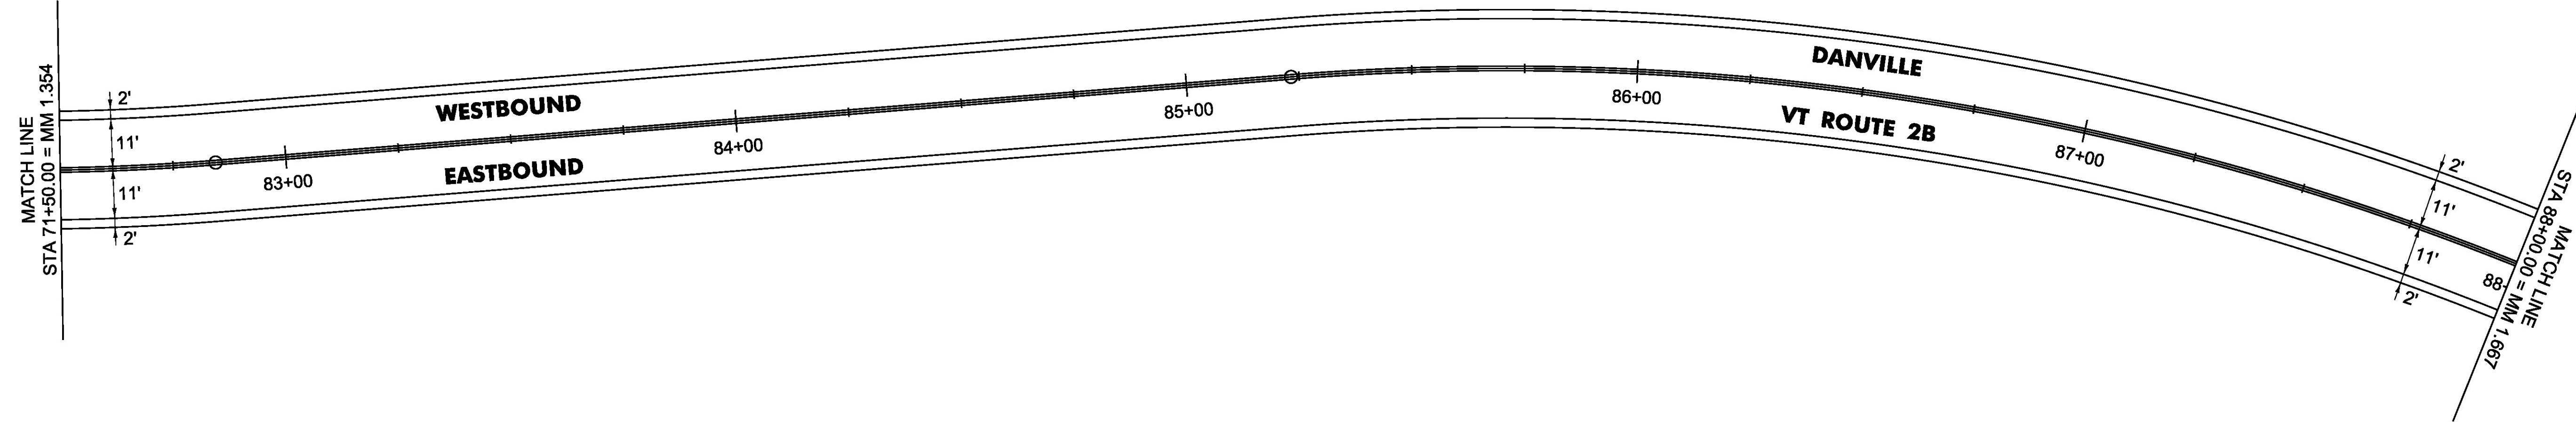


4 INCH YELLOW LINE, WATERBORNE PAINT
77+00 TO 88+00 SOLID RT & LT

TEMPORARY 4 INCH YELLOW LINE, PAINT
77+00 TO 88+00 SOLID RT & LT

4 INCH WHITE LINE, WATERBORNE PAINT
77+00 TO 88+00 SOLID RT & LT

TEMPORARY 4 INCH WHITE LINE, PAINT
77+00 TO 88+00 SOLID RT & LT

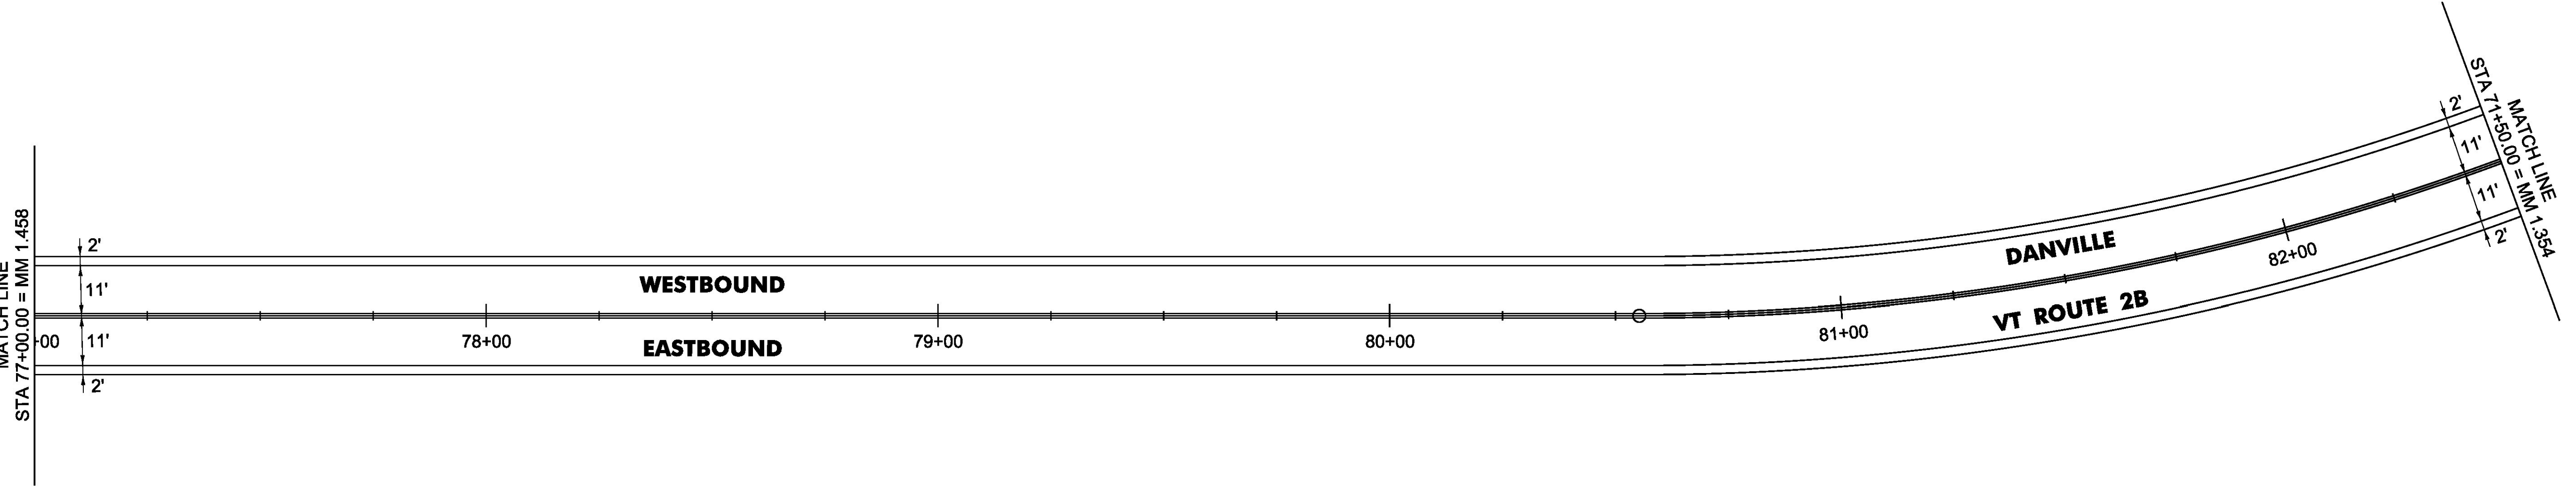

NOT TO SCALE

PROJECT NAME:	DANVILLE-ST. JOHNSBURY		
PROJECT NUMBER:	STP FPAV(9)		
FILE NAME:	16v148.dgn	PLOT DATE:	05-JUN-2017
PROJECT LEADER:	B. KIPP	DRAWN BY:	B. KIPP
DESIGNED BY:	B. KIPP	CHECKED BY:	M. FOWLER
PLAN SHEET 8		SHEET 23	OF 33