

INDEX OF SHEETS

1	TITLE SHEET
2	CRACK SEALING TYPICAL
3	QUANTITY SHEET
4	LOCATION LAYOUT
5-6	CRACK SEALING LOCATION DETAIL SHEETS
7-31	INTERCHANGE DETAIL SHEETS
32	TRAFFIC CONTROL NOTES

VAOT STANDARDS

T-1	04/25/16
T-10	08/06/12
T-11	08/06/12
T-12	08/06/12
T-16	08/06/12
T-17	08/06/12
T-20	08/06/12
T-28	08/06/12
T-29	08/06/12
T-30	08/06/12
T-31	08/06/12

RECORD PLANS

CONTRACTOR: ANNSEAL, INC. - JOHNSON CITY, NY

RESIDENT ENGINEER: CHRIS LAVALETTE

CONSTRUCTION BEGAN: AUGUST 28, 2017

CONSTRUCTION COMPLETE: MAY 10, 2018

RECORD PLANS BY: CHRIS LAVALETTE & JESSE IVES

I HEREBY CERTIFY THAT ALL THE CONSTRUCTION REQUIRED BY THIS SET OF DRAWINGS HAS BEEN ACCOMPLISHED AS INDICATED HEREIN.

BY Chris L RESIDENT ENGINEER

DATE 9/10/18

NOTE: Any further information concerning final quantities, amounts or other details relative to this project may be found at Central Files in the electronic archives.

CONSTRUCTION IS TO BE CARRIED ON IN ACCORDANCE WITH THESE PLANS AND THE STANDARD SPECIFICATIONS FOR CONSTRUCTION DATED 2011, AS APPROVED BY THE FEDERAL HIGHWAY ADMINISTRATION ON JULY 20, 2011 FOR USE ON THIS PROJECT, INCLUDING ALL SUBSEQUENT REVISIONS AND SUCH REVISED SPECIFICATIONS AND SPECIAL PROVISIONS AS ARE INCORPORATED IN THESE PLANS.

QUALITY ASSURANCE PROGRAM : LEVEL 1


SURVEYED BY : N/A

SURVEYED DATE : N/A

DATUM


VERTICAL : N/A

HORIZONTAL : N/A

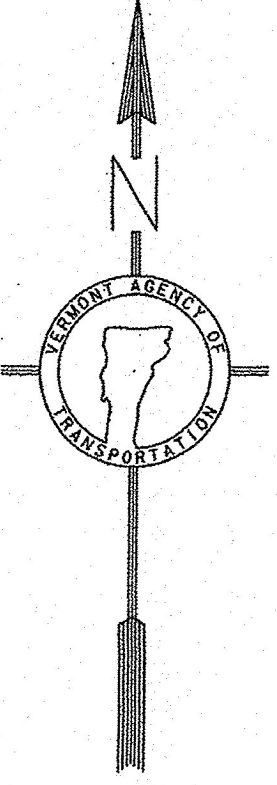

STATE OF VERMONT




AGENCY OF TRANSPORTATION

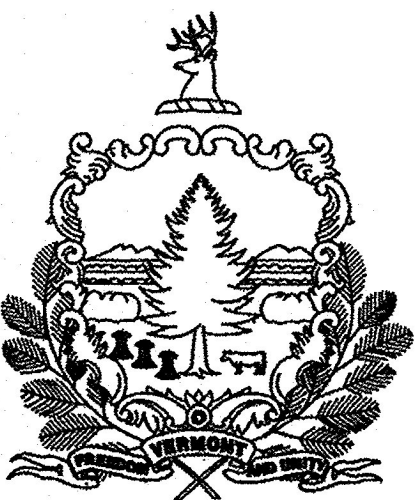

PROPOSED IMPROVEMENT

STATEWIDE CRACK SEALING

WORK TO BE PERFORMED UNDER THIS PROJECT INCLUDES THE ROUTING AND SEALING OF CRACKS IN BITUMINOUS CONCRETE PAVEMENT ON EXISTING STATE, U.S., AND INTERSTATE HIGHWAYS AND THE APPROPRIATE TRAFFIC CONTROL.

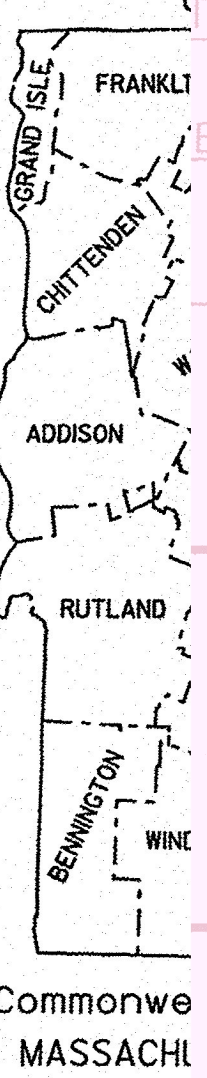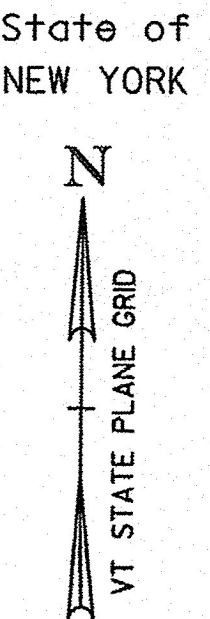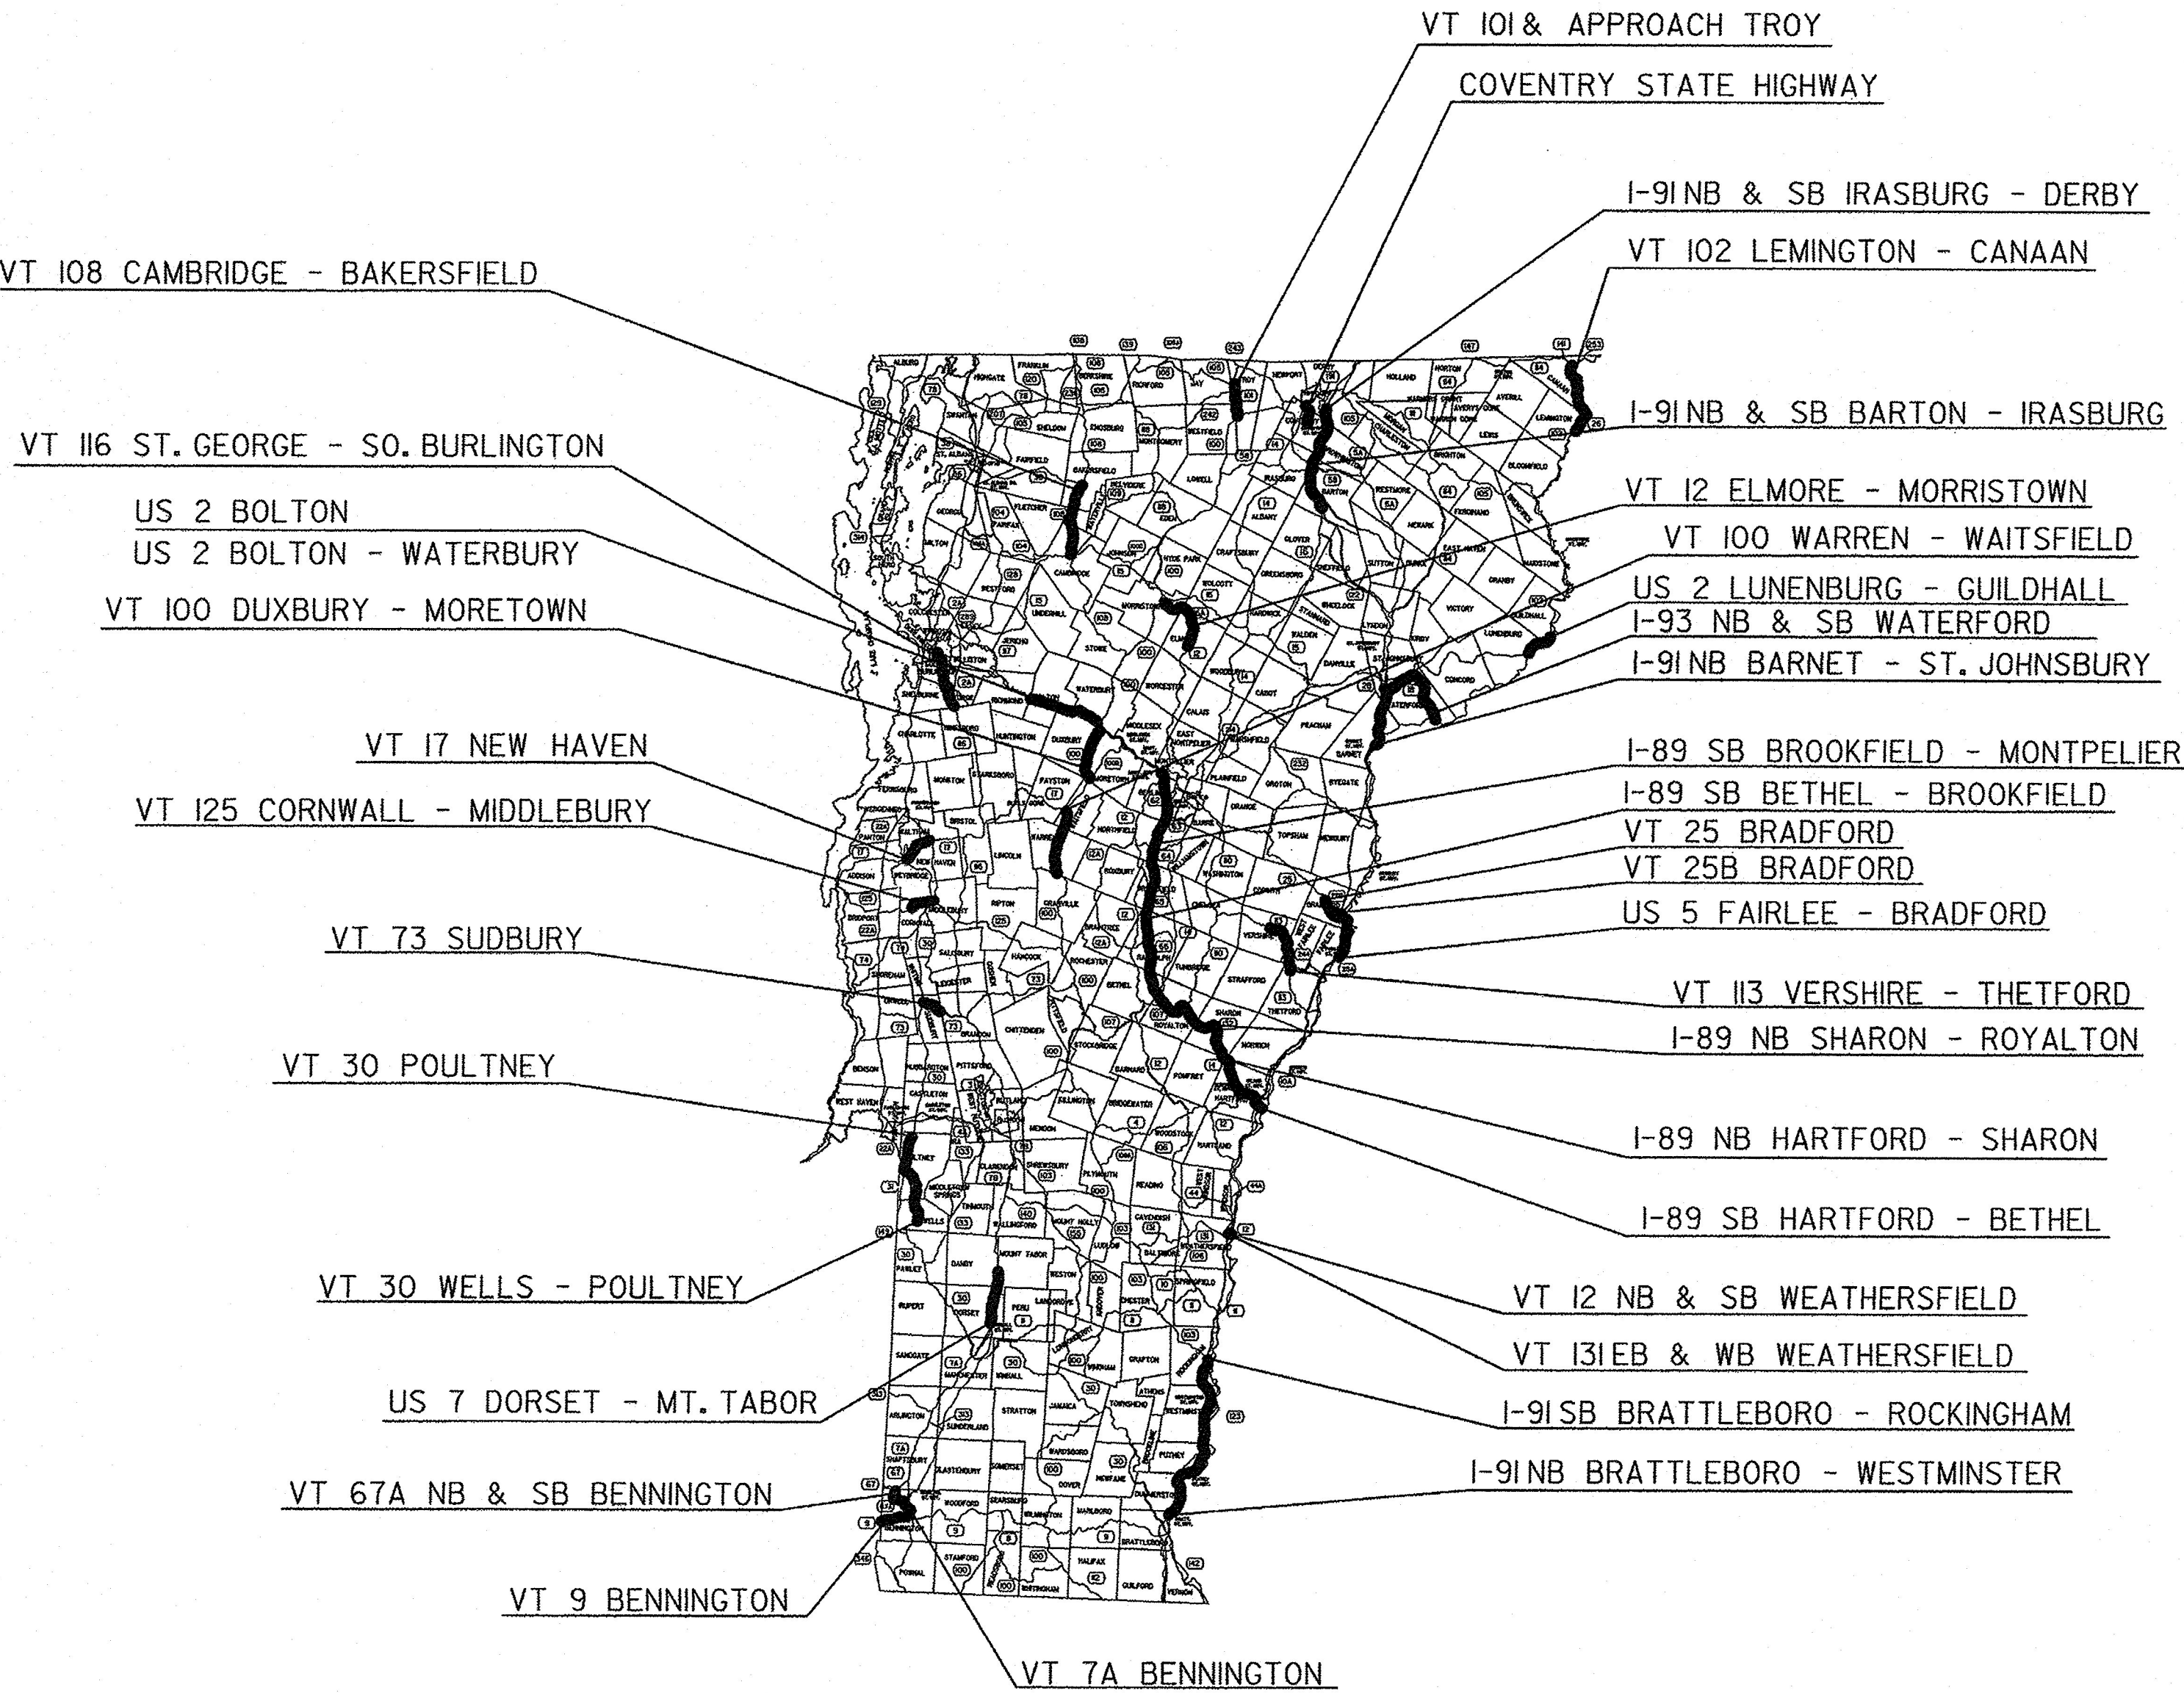

DIRECTOR OF PROJECT

APPROVED [Signature]

PROJECT MANAGER : MIC

PROJECT NAME : STATEWIDE

PROJECT NUMBER : STP

SHEET 1 OF 32

NOT TO SCALE