
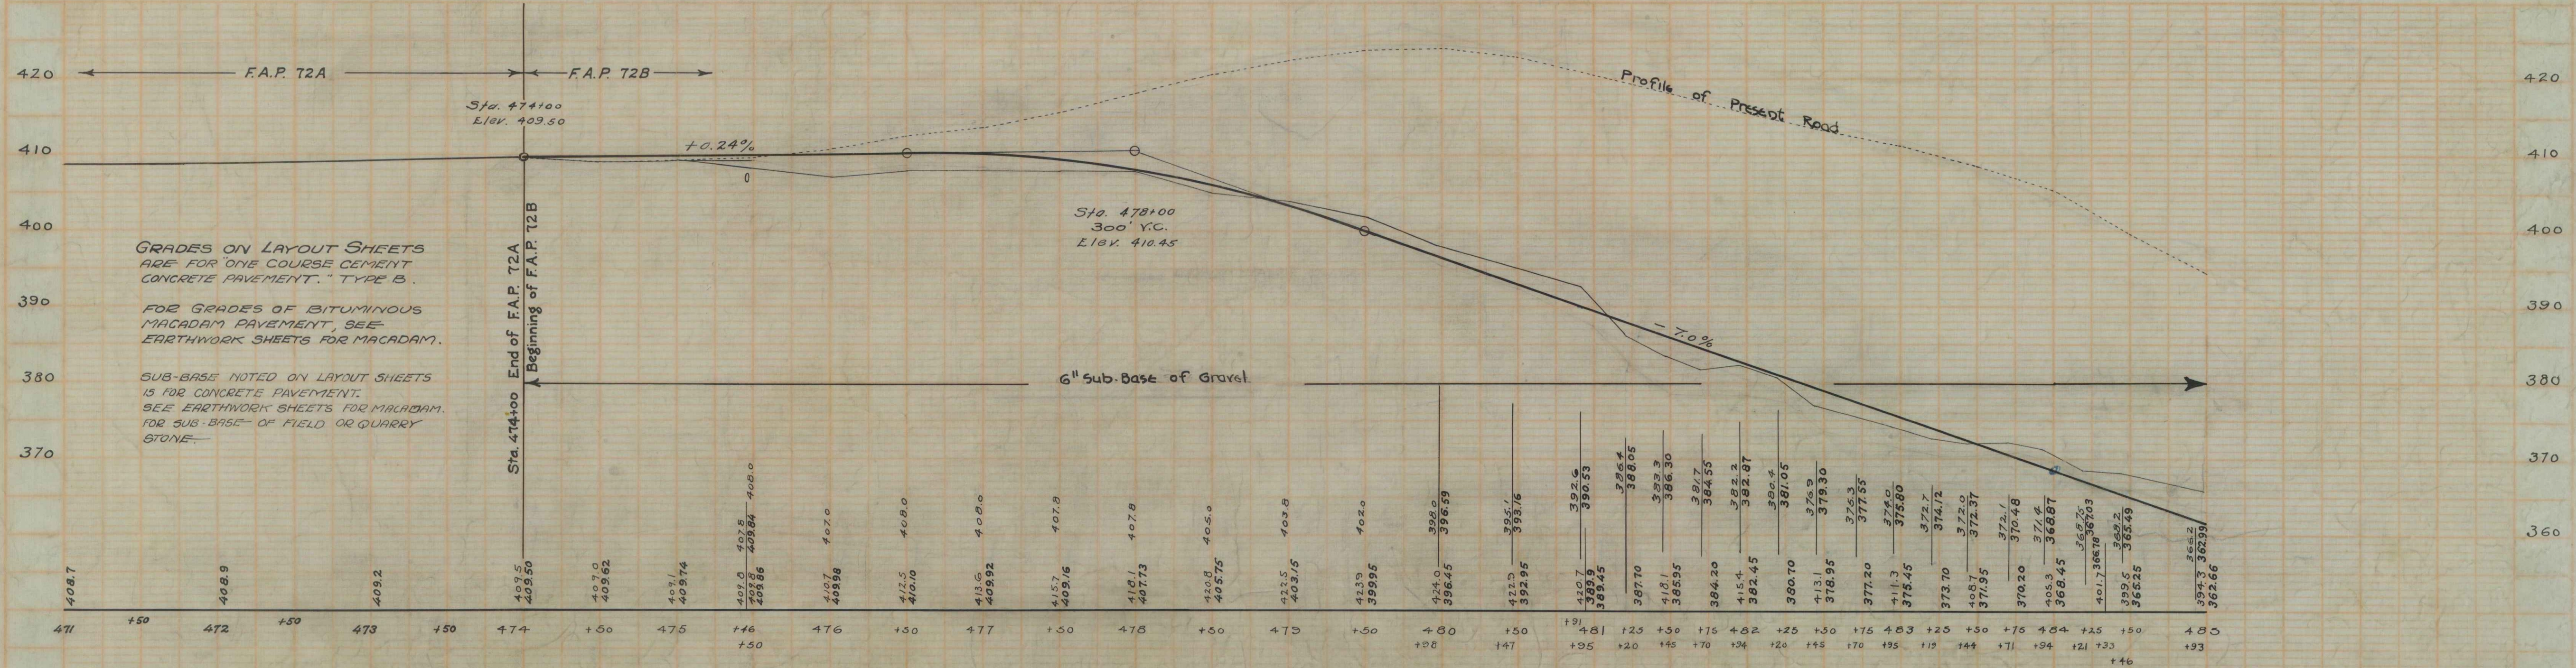


CABLE GUARD RAIL REQUIRED
LEFT
 Sta. 475+34 to 475+58 Length 24 ft.
 " 483+00 " 483+40 " 40 ft.
 " 484+50 " 485+00 " 50 ft.

WOOD GUARD RAIL REQUIRED
Right
 Sta. 475+34 to Sta. 475+58 Length 24 ft.
 " 483+00 " 483+40 " 40 ft.
 " 484+50 " 485+00 " 50 ft.

NEW CULVERTS REQUIRED
 Sta. 475+46 - 30" Reinf. Concrete Pipe Culvert 40 Linft.
 Concrete Class A (1-2-4) 35 cu. yds.
 Reinforcing Steel 65 pounds.
 " 483+00 - 18" Reinf. Concrete Pipe Culvert 32 Linft.
 Concrete Class A (1-2-4) 1.07 cu. yds.
 " " B (1-2 1/2-5) 0.82 " " " " 45 lbs

SUB-BASE OF GRAVEL REQUIRED
 Sta. 474+00 to 485+00. 6" Sub-base of Gravel 1100 Lin ft.

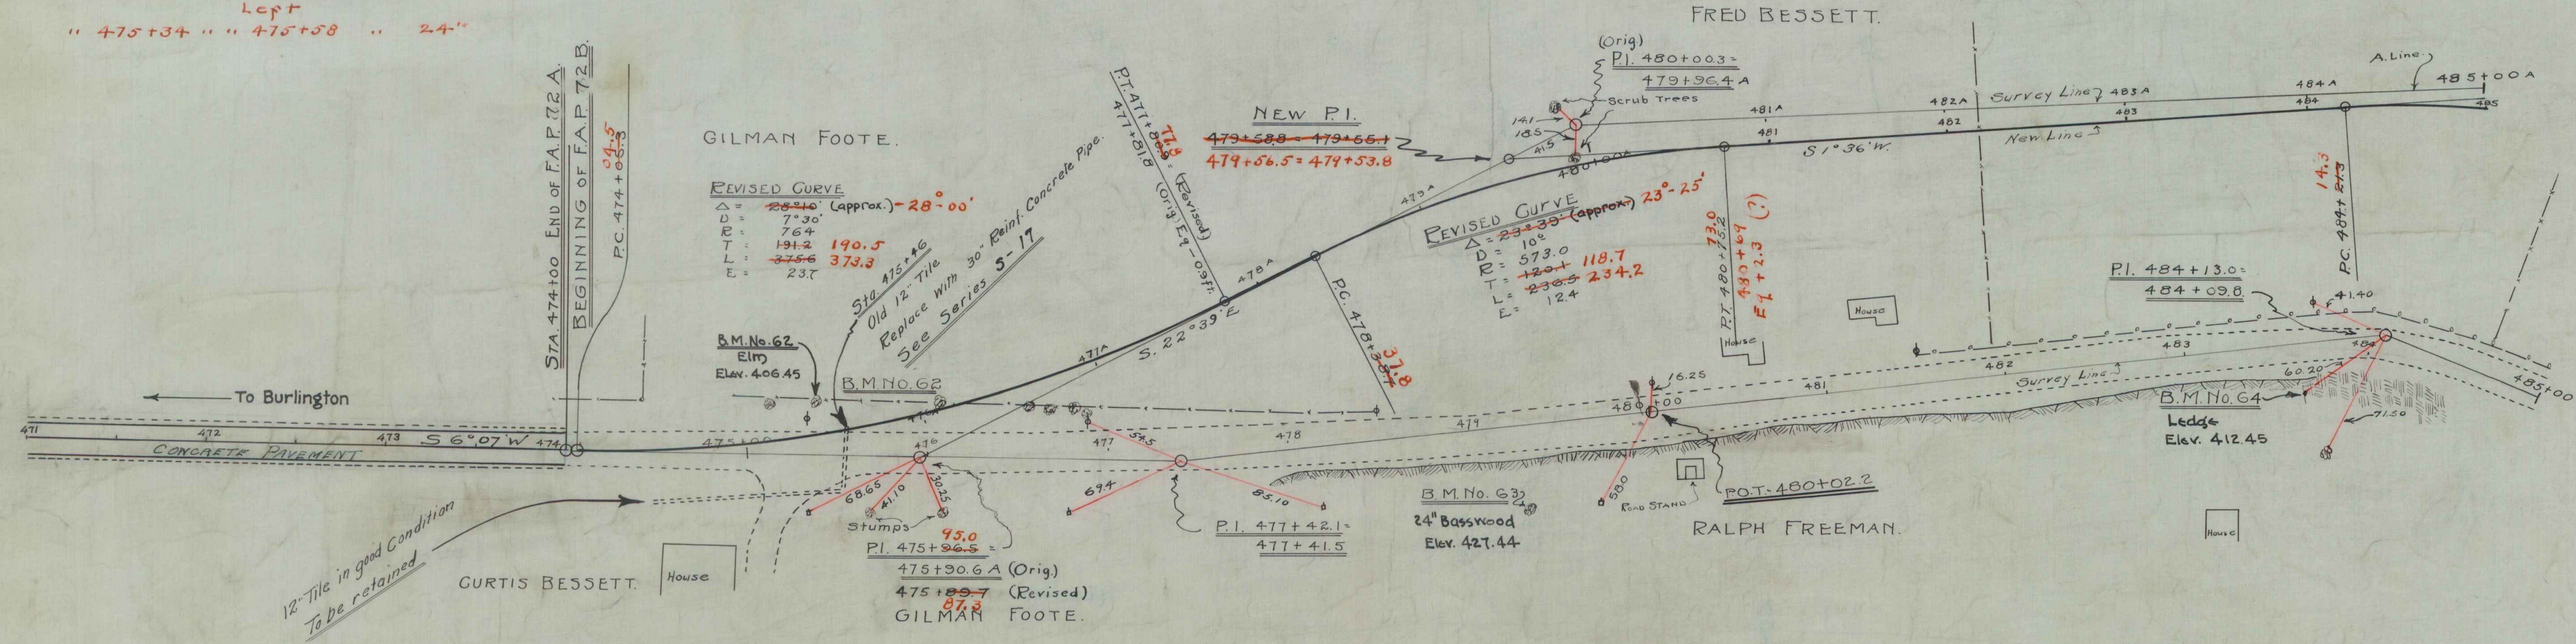

B.M. No. 62 Spike in Elm Left of Sta. 475+11 Elev. 406.45
 B.M. No. 63 Spike in 24" Basswood Right of Sta. 479+32 Elev. 427.44
 B.M. No. 64 Paint Point on Ledge Right of Sta. 483+62 Elev. 412.45