

WOOD GUARD RAIL REQUIRED

Sta.	Left	Length
Sta. 532+00 to 533+12	24 ft	
" 535+38 " 535+62	" 24 "	
Sta. 532+00 to 533+12	24 ft	
" 535+38 " 535+62	" 24 "	

NEW CULVERTS REQUIRED



Sta.	18" Reinf. Concrete Pipe Culvert	32 Lin. ft
Sta. 533+00	Concrete Class A (1-2-4)	2.7 Cu yds. 2.5
	Reinforcing Steel	54 lbs
Sta. 535+50	15" Reinf. Conc. Pipe Culvert	32 Lin. ft
	Concrete Class B (1-2-4)	2.5 Cu yds
	Reinforcing Steel	54 lbs

SUB-BASE OF GRAVEL REQUIRED

Sta.	6" Sub-base of gravel	300 Lin. ft
Sta. 531+00 to 533+00	545+00	1500 "

Driveway Culverts

Sta.	Left - Relay 25 ft of pipe	1.4 Cu yds
Sta. 537+10	Concrete Class B (1-2 1/2-5)	
Sta.	Left - Relay 20 ft of pipe	1.4 "
Sta. 538+00	Concrete class B (1-2 1/2-5)	

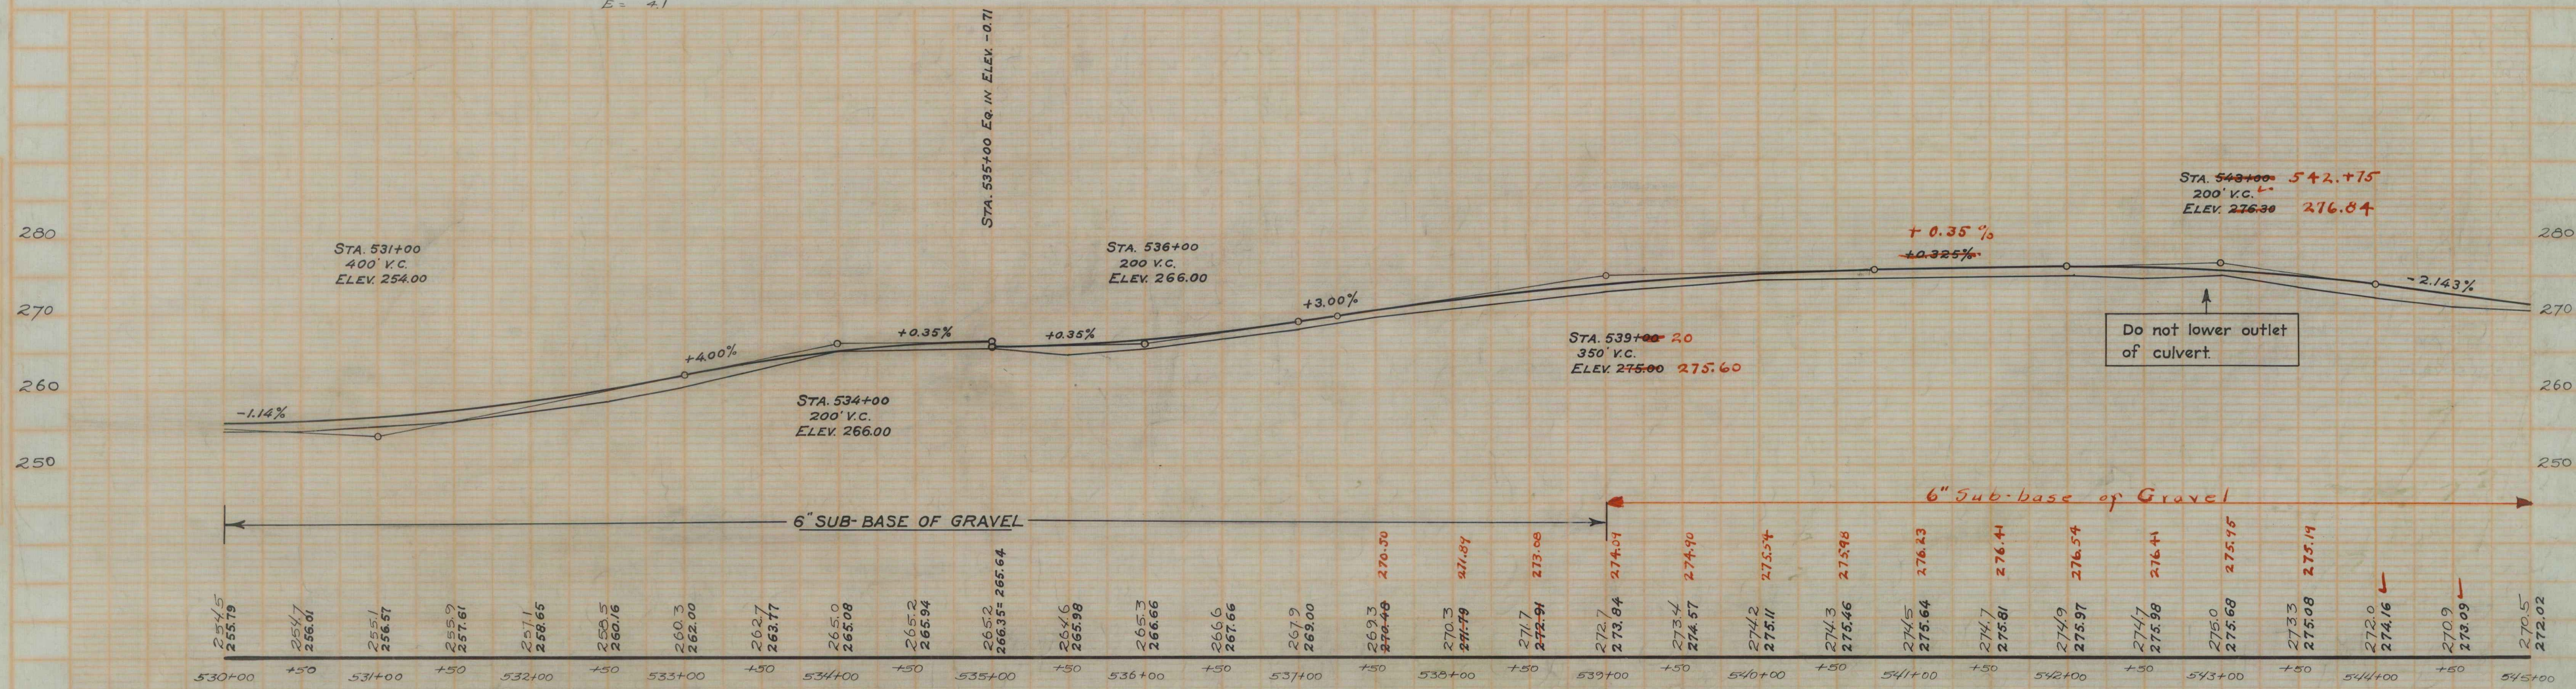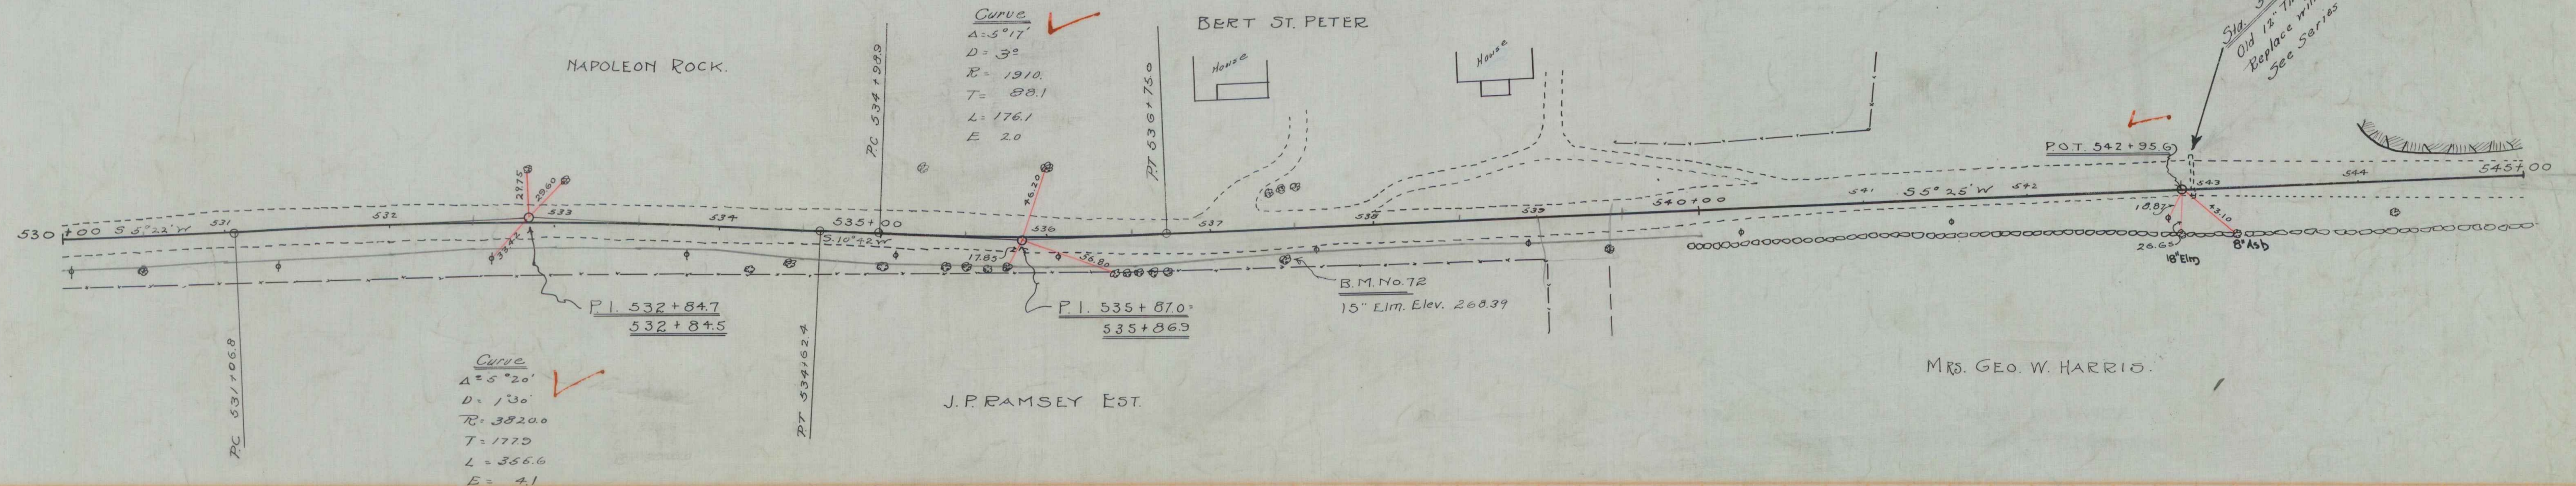

B.M. No. 72. Spike in 15" Elm. Right of Sta. 537+45, Elev. 268.39