

WOOD GUARD RAIL REQUIRED

LEFT			
Sta.	Length	# P.	Notes
Sta. 560+00 to 560+04	4 ft	✓	
" 564+67 " 564+91	24 ft	✓	
" 568+52 " 568+76	24 ft	✓	

RIGHT			
Sta.	Length	# P.	Notes
Sta. 560+00 to 560+04	4 ft	✓	
Sta. 564+67 " 564+91	24 ft	✓	
" 568+52 " 568+76	24 ft	✓	

NEW CULVERTS REQUIRED

Sta. 564+79 - 18" Rein. Concrete Pipe Culvert	32 Lin ft	✓
Concrete Class II (1-2 1/2")	2.422 Cu yds	
Reinforcing Steel	54 32 pounds	
Sta. 568+68 - 18" Rein. Concrete pipe Culvert	32 Lin ft	✓
Concrete Class II (1-2 1/2")	2.422 Cu yds	
Reinforcing Steel	54 32 pounds	



SUB-BASE OF GRAVEL REQUIRED

Sta. 560+00 to 561+00	100 Lin ft	✓
561+00 " 562+00	6" Sub-base of Gravel	

Cable Guard Rail
Sta. 565+73 to 567+05 - Right - length 192 lin ft

DRIVEWAY CULVERTS
Sta. 562+10 on left - New headwalls required. 14 targets

FED. ROAD DIST. NO.	STATE	FED. AID PROJ. NO.	FISCAL YEAR	SHEET NO.	TOTAL SHEETS
8	VT.	720	1928	10	124

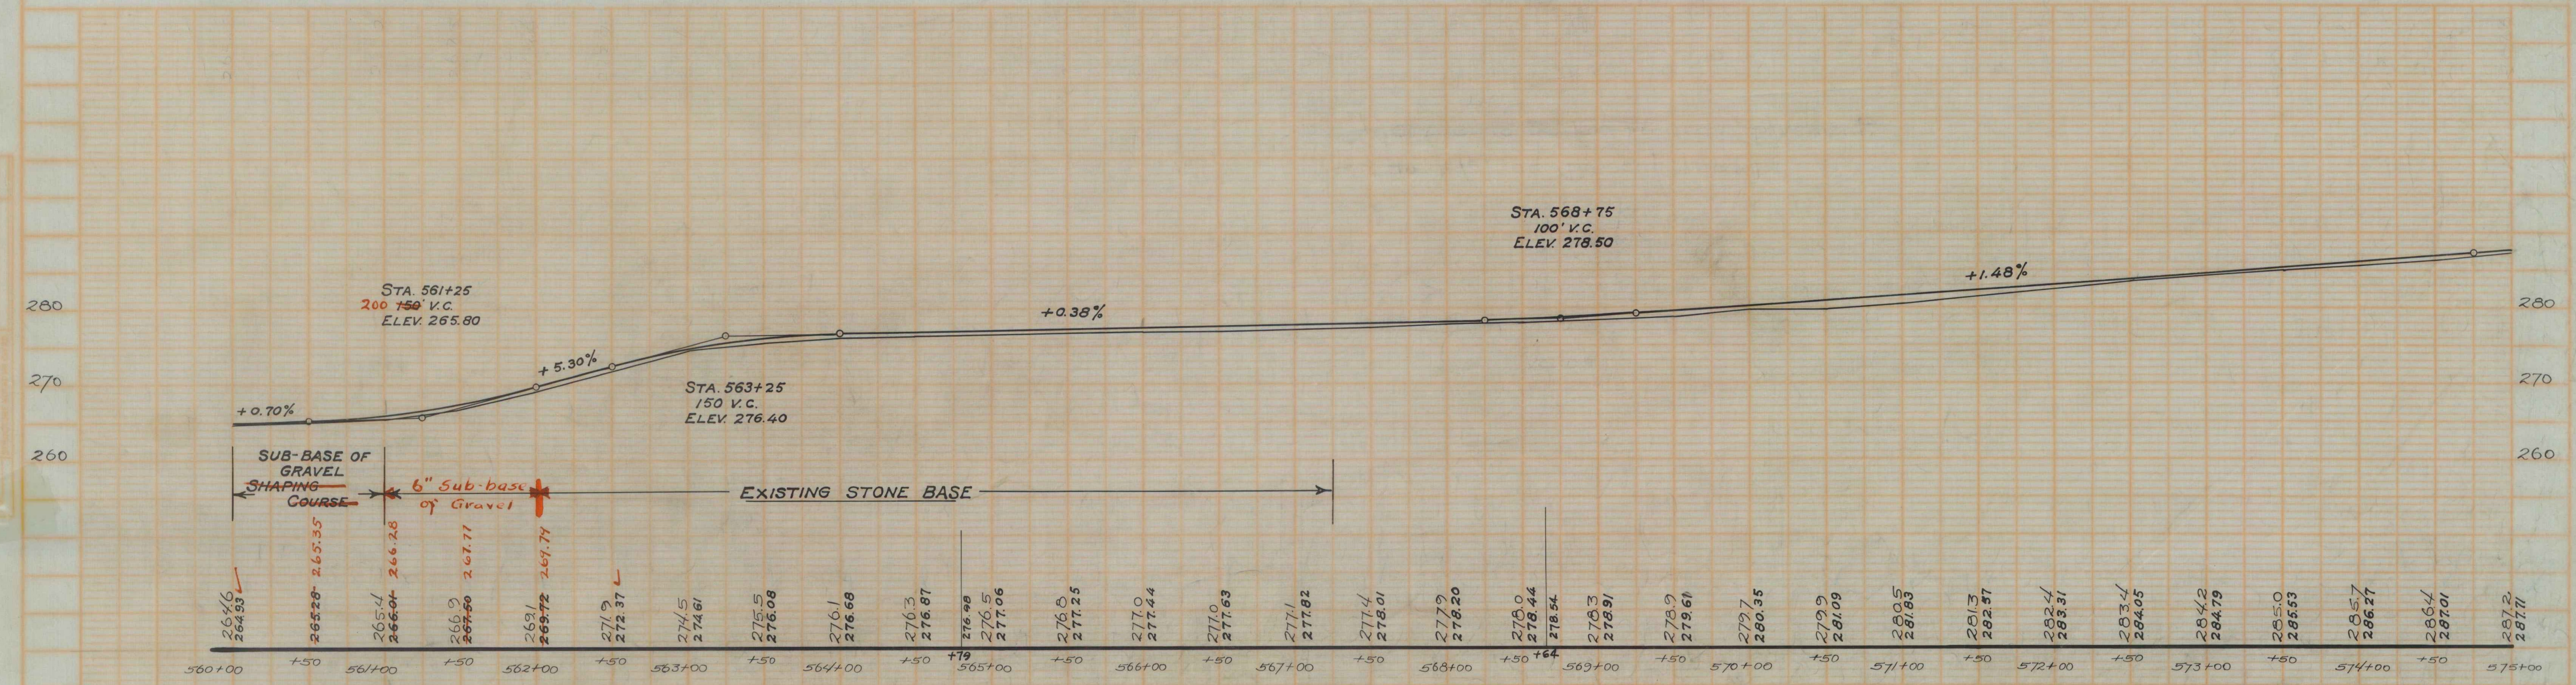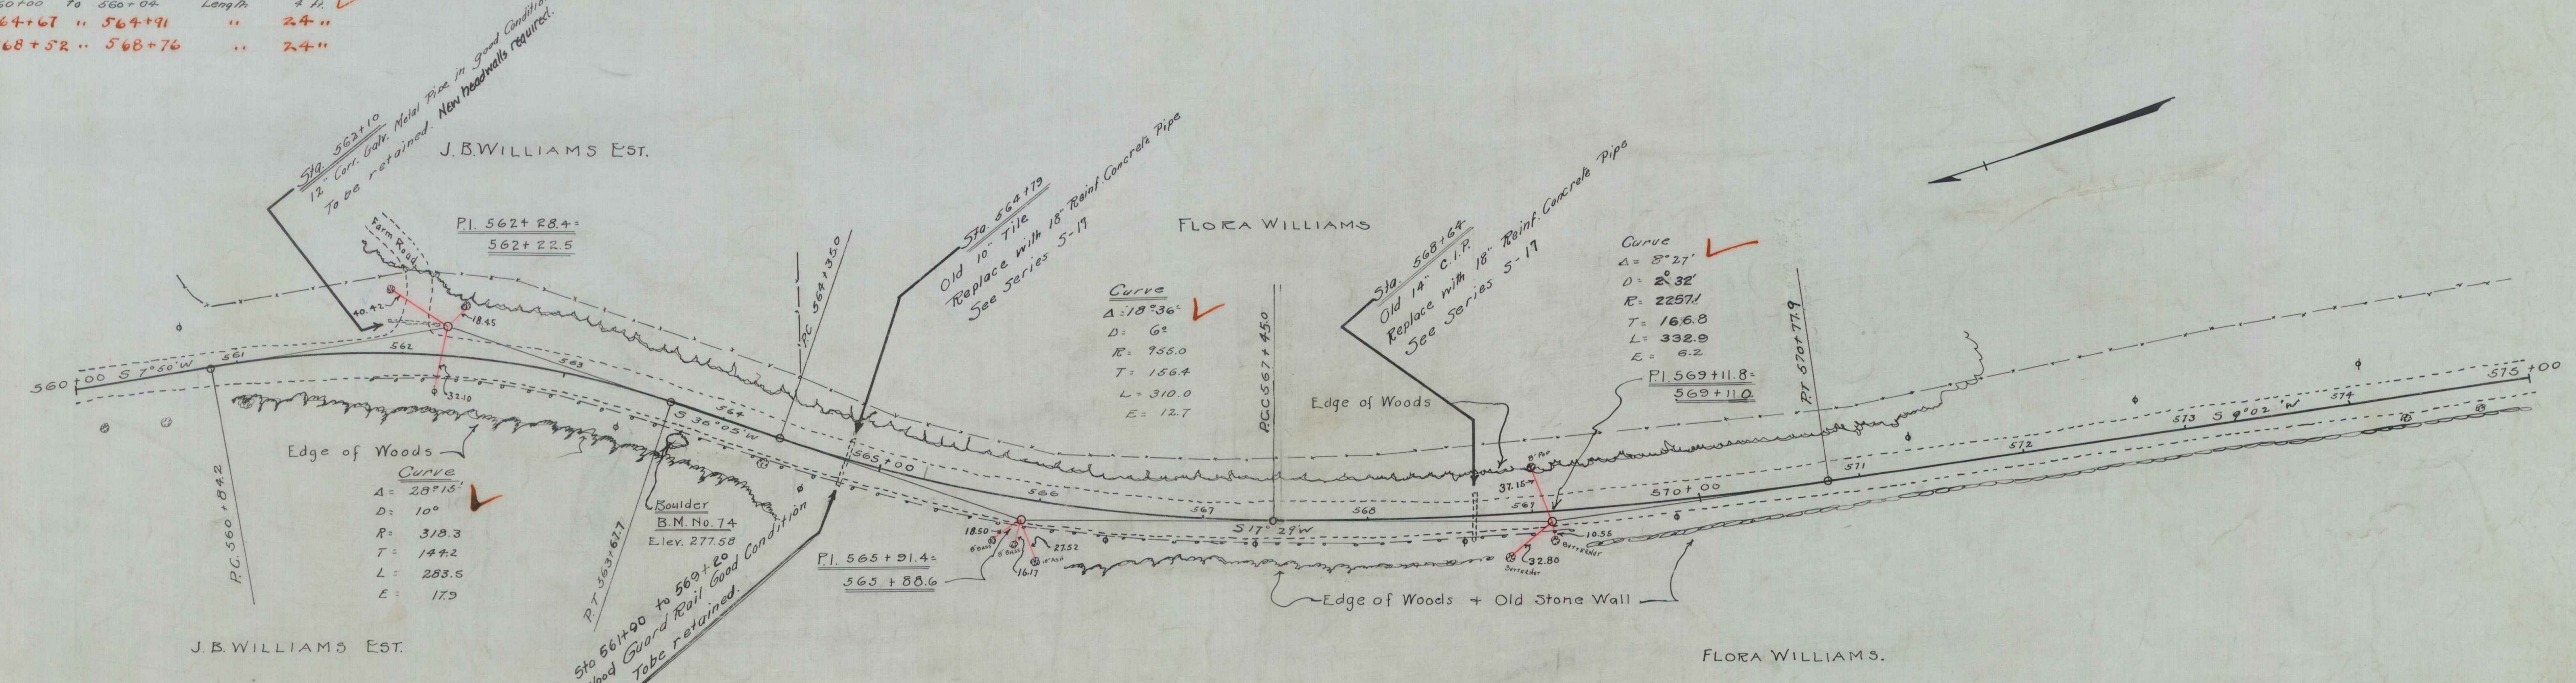

B.M. No. 74, Boulder on right of Sta. 563+79, Elev. 277.58

Series F No. 72 B
Sheet 10 of 104