

WOOD GUARD RAIL REQUIRED.

Sta.	Left	Length	Right
575+50 to 575+74	24 ft.	✓	
588+17 " 588+41	24 "	✓	
" 582+88 " 583+12	24 "	✓	



NEW CULVERTS REQUIRED

Sta. 575+62	18" Rein. Concrete Pipe Culvert	32 Lin ft.
	Concrete Class B (1-2X-4)	2.4 cu yds.
	Reinforcing Steel	54 lbs.
Sta. 588+29	18" Rein. Concrete Pipe Culvert	36 Lin ft.
	Concrete Class B (1-2X-4)	2.4 cu yds.
	Reinforcing Steel	54 lbs.
Sta. 582+50	18" Rein. Conc. Pipe Culvert	32 Lin ft.
	Concrete Class B (1-2X-4)	2.4 cu yds.
	Reinforcing Steel	54 lbs.

SUB-BASE OF GRAVEL REQUIRED.

Sta. 588+00 to 588+29 6" Sub-base of gravel 100 Lin ft.

FED. ROAD DIST. NO.	STATE	FED. AID PROJ. NO.	FISCAL YEAR	SHEET NO.	TOTAL SHEETS
9	VI.	72.B.	1928	11	104

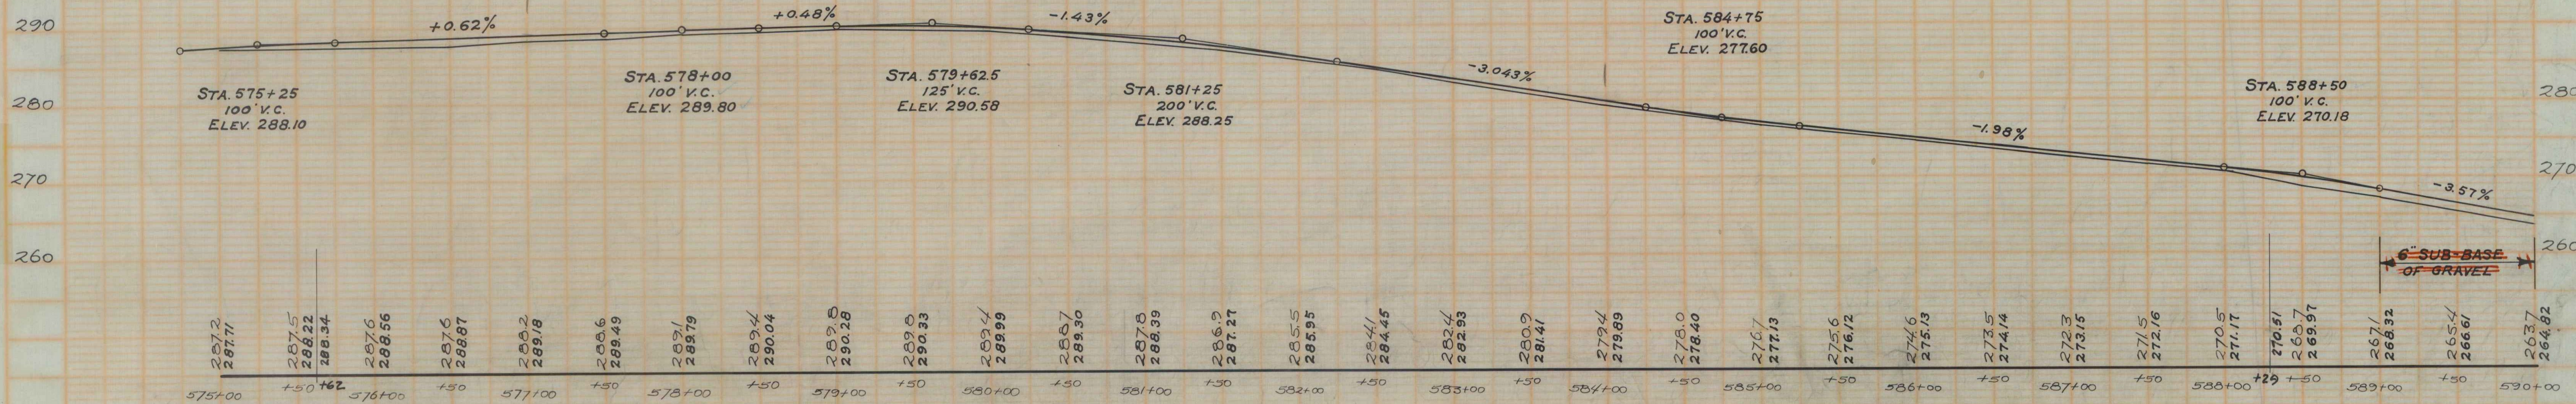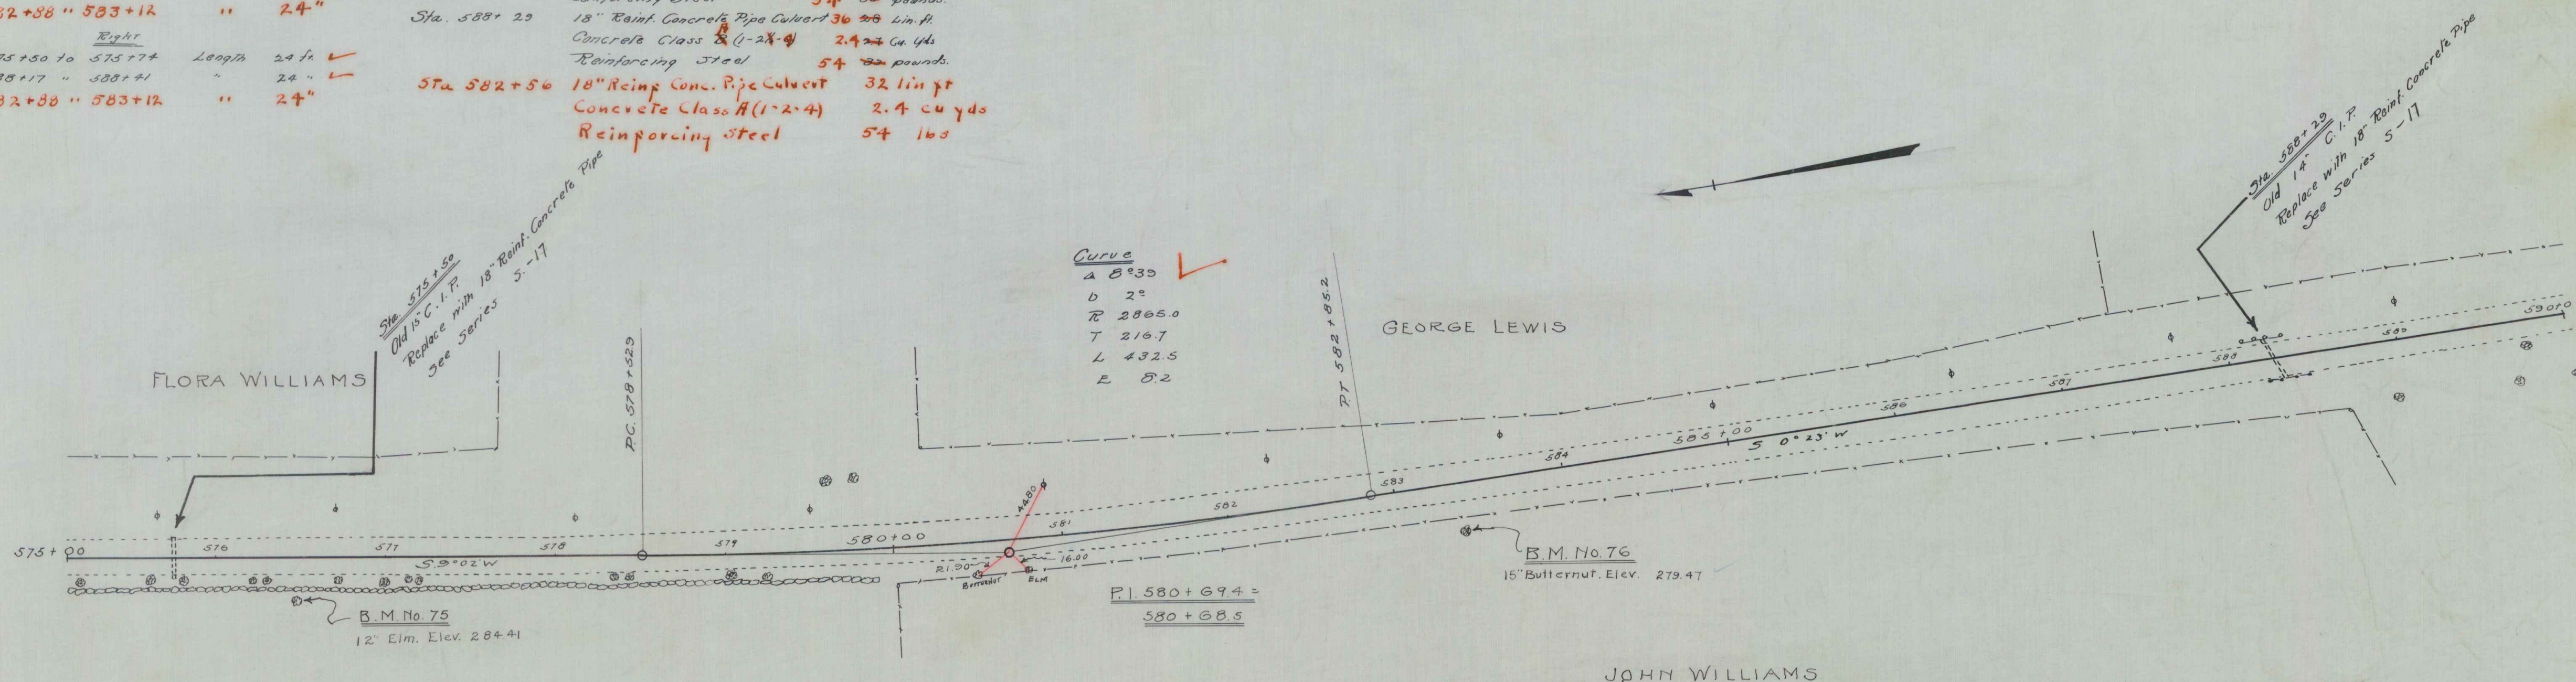

B.M. No. 75 Spike in 12" Elm. Right of Sta. 576+49. Elev. 284.41
B.M. No. 76 Spike in 15" Butternut Right of Sta. 583+38 Elev. 279.47

Series F. No. 72B.
Sheet 11 of 104