

DRIVEWAY CULVERTS REQUIRED

Sta. 591+50 Right 12" Cor. Galv. Metal Pipe 32 Lin. ft.
 Concrete Class B (1-2 1/2-3) 1.4 cu yd
 Sta. 593+60 Right 12" Cor. Galv. Metal Pipe 20 Lin. ft.
 Concrete Class B (1-2 1/2-3) 1.4 cu yd


SUB-BASE OF GRAVEL REQUIRED

Sta. 590+00 to 595+00 - 6" Sub-base of gravel 500 Lin. ft.

FED. ROAD DIST. NO.	STATE	FED. AID PROJ. NO.	FISCAL YEAR	SHEET NO.	TOTAL SHEETS
5	VA	72B	1928	12	104

12/16
 A & D

12/16
 A & D

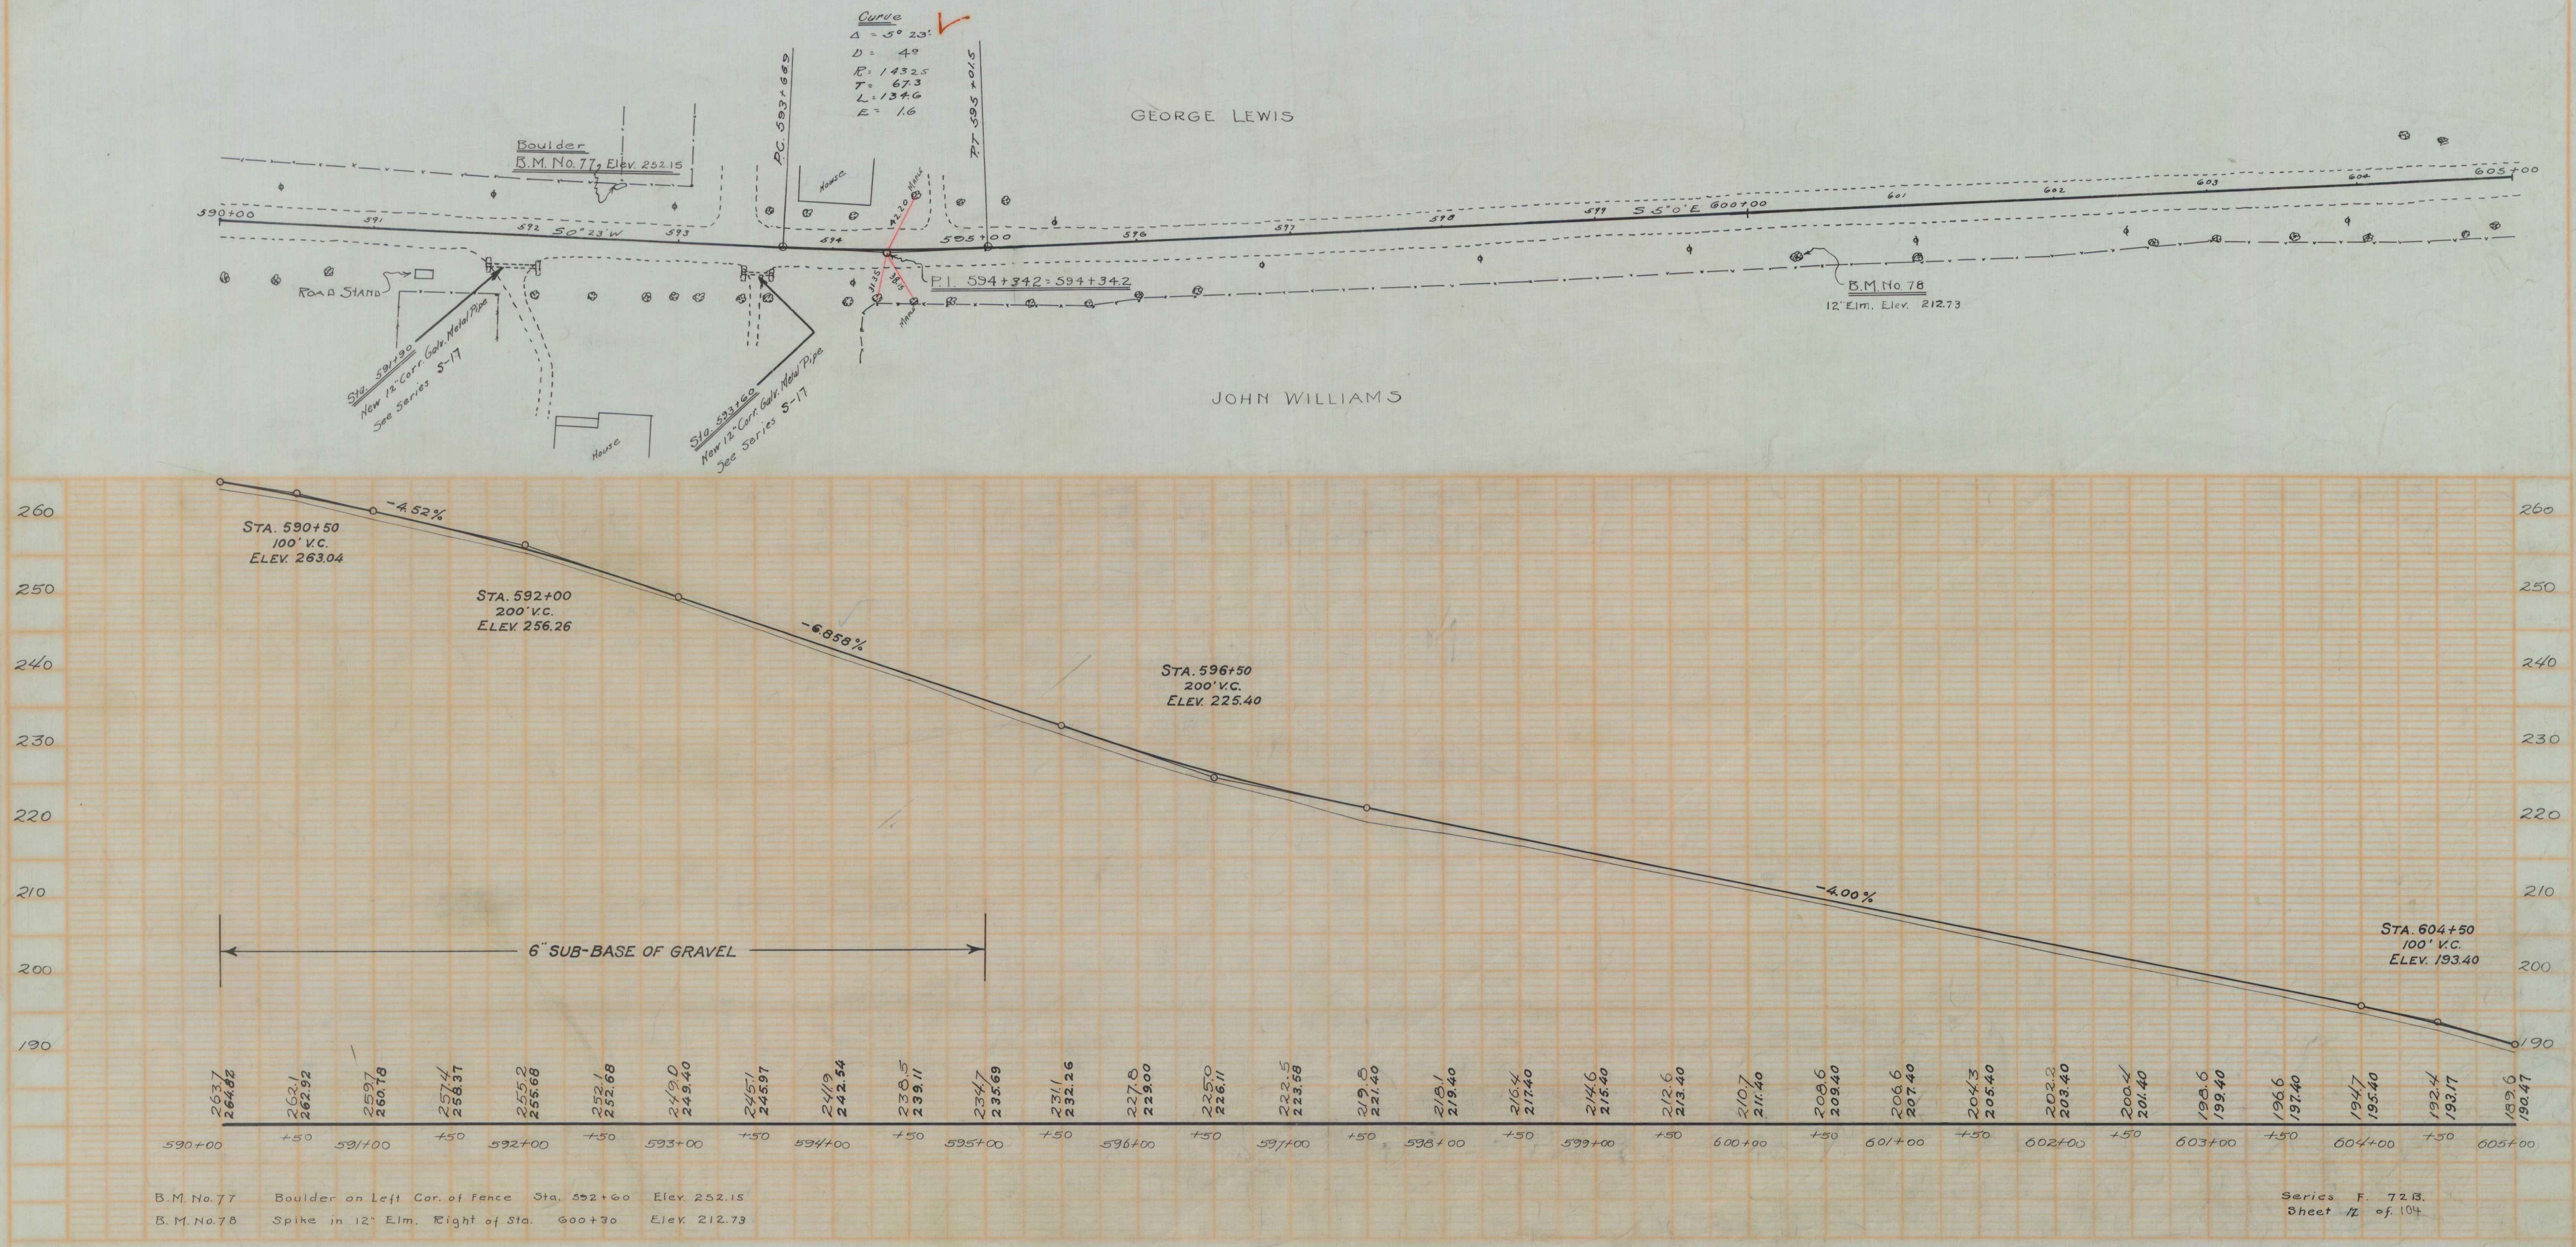

B.M. No. 77 Boulder on Left Cor. of Fence Sta. 592+50 Elev. 252.15
 B.M. No. 78 Spike in 12" Elm. Right of Sta. 600+30 Elev. 212.73

Series F. 72B.
 Sheet 12 of 104