

CABLE GUARD RAIL REQUIRED.

Sta 606+75 to 607+24.0 Length 48 ft
 " 618+02 " 618+50 " 48 ft

RIGHT
 Sta 606+75 to 607+24.0 Length 48 ft
 " 618+02 " 618+50 " 48 ft



DRIVEWAY CULVERTS REQUIRED.

Sta 607+25 to 608+12.5 Cor. Culvert 20 ft
 Concrete Class B (1-2-4) 11 Cu Yds.

CULVERT REPAIRS REQUIRED.

Sta 618+24 to 618+24.0
 Concrete Class A (1-2-4) 9.6 Cu Yds.
 Sta 618+24 (Extension of barrel is to be constructed)
 Concrete Class A (1-2-4) 3.6 Cu Yds. 4.5
 Reinforcing Steel 220 Pounds 239

FED. ROAD DIST. NO.	STATE	FED. AID PROJ. NO.	FISCAL YEAR	SHEET NO.	TOTAL SHEETS
8	VI.	720	1928	13	1226

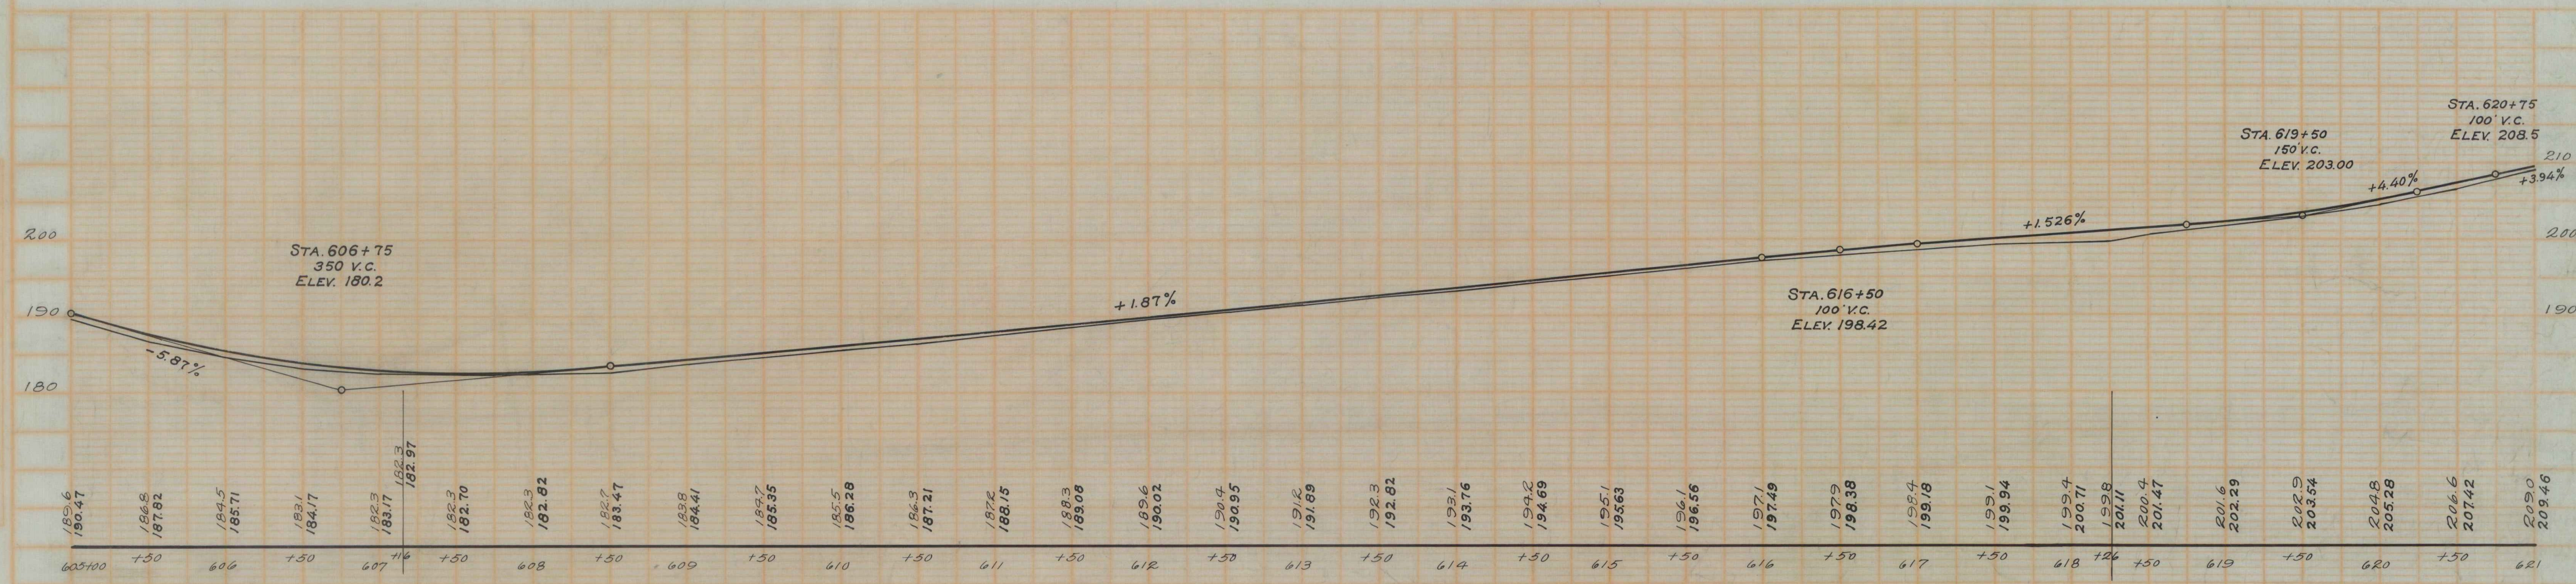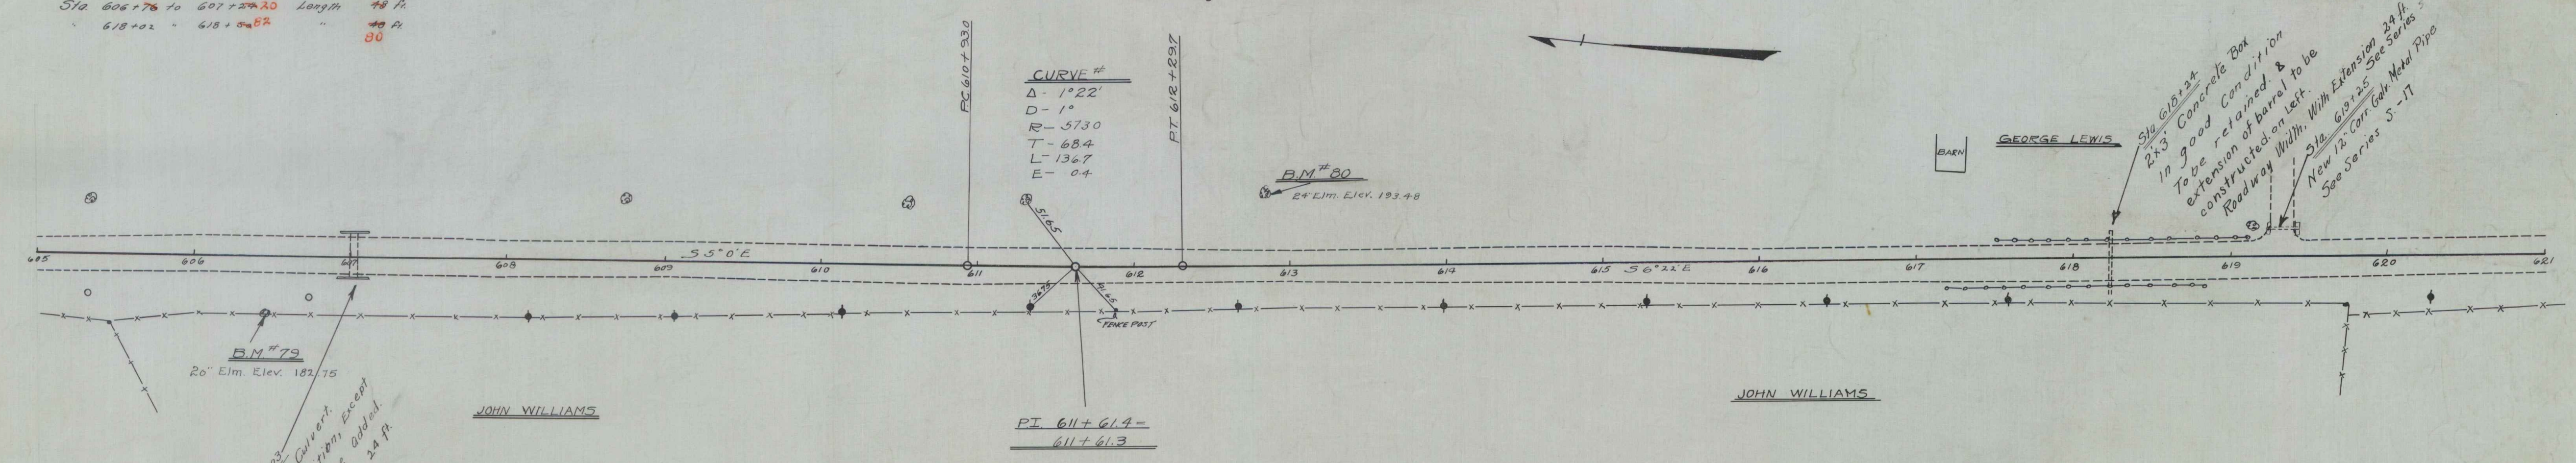

B.M. NO. 79 - SPIKE IN 20' ELM, 38' RIGHT OF STA. 606+46, ELEV. 182.75
 B.M. NO. 80 - SPIKE IN 24' ELM, 45' LEFT OF STA. 612+87, ELEV. 193.48