

WOOD GUARD RAIL REQUIRED
 LEFT
 Sta 610+00 to 610+02 Length 22 ft
 RIGHT
 Sta 610+00 to 610+02 Length 22 ft



NEW CULVERTS REQUIRED
 Sta. 646+50 18" Rein. Concrete Pipe Culvert 22 Lf.
 with Drop Inlet on left and straight H.W. on right.
 Concrete Class A (124) 1.0 cu yd
 Concrete Class B (124) 1.4
 Reinforcing Steel 100 lbs.
 24 lin. ft. of pipe 12 in. and removed
 Pipe used at outlet Sta 700+00

NEW DRIVEWAY CULVERTS REQUIRED
 Sta 646+10 Left 12" Rein. Concrete Pipe 15 Lf.
 Concrete Class B (124) 1.1 cu yd

DRIVEWAY CULVERT REPAIRS REQUIRED
 Sta. 651+75 Build New Headwall 1.5 ft 1.4 Sta. 652+00 to 652+02
 Class B Concrete (124) 1.4 cu yd
 Relay 75 ft up Pipe

SUB-BASE OF GRAVEL REQUIRED
 Sta. 648+00 to 652+00 6" Sub-base of Gravel
 400 lin. ft.
 1.00

FED. ROAD DIST. NO.	STATE	FED. AID PROJ. NO.	FISCAL YEAR	SHEET NO.	TOTAL SHEETS
3	VT	728	1928	15	104

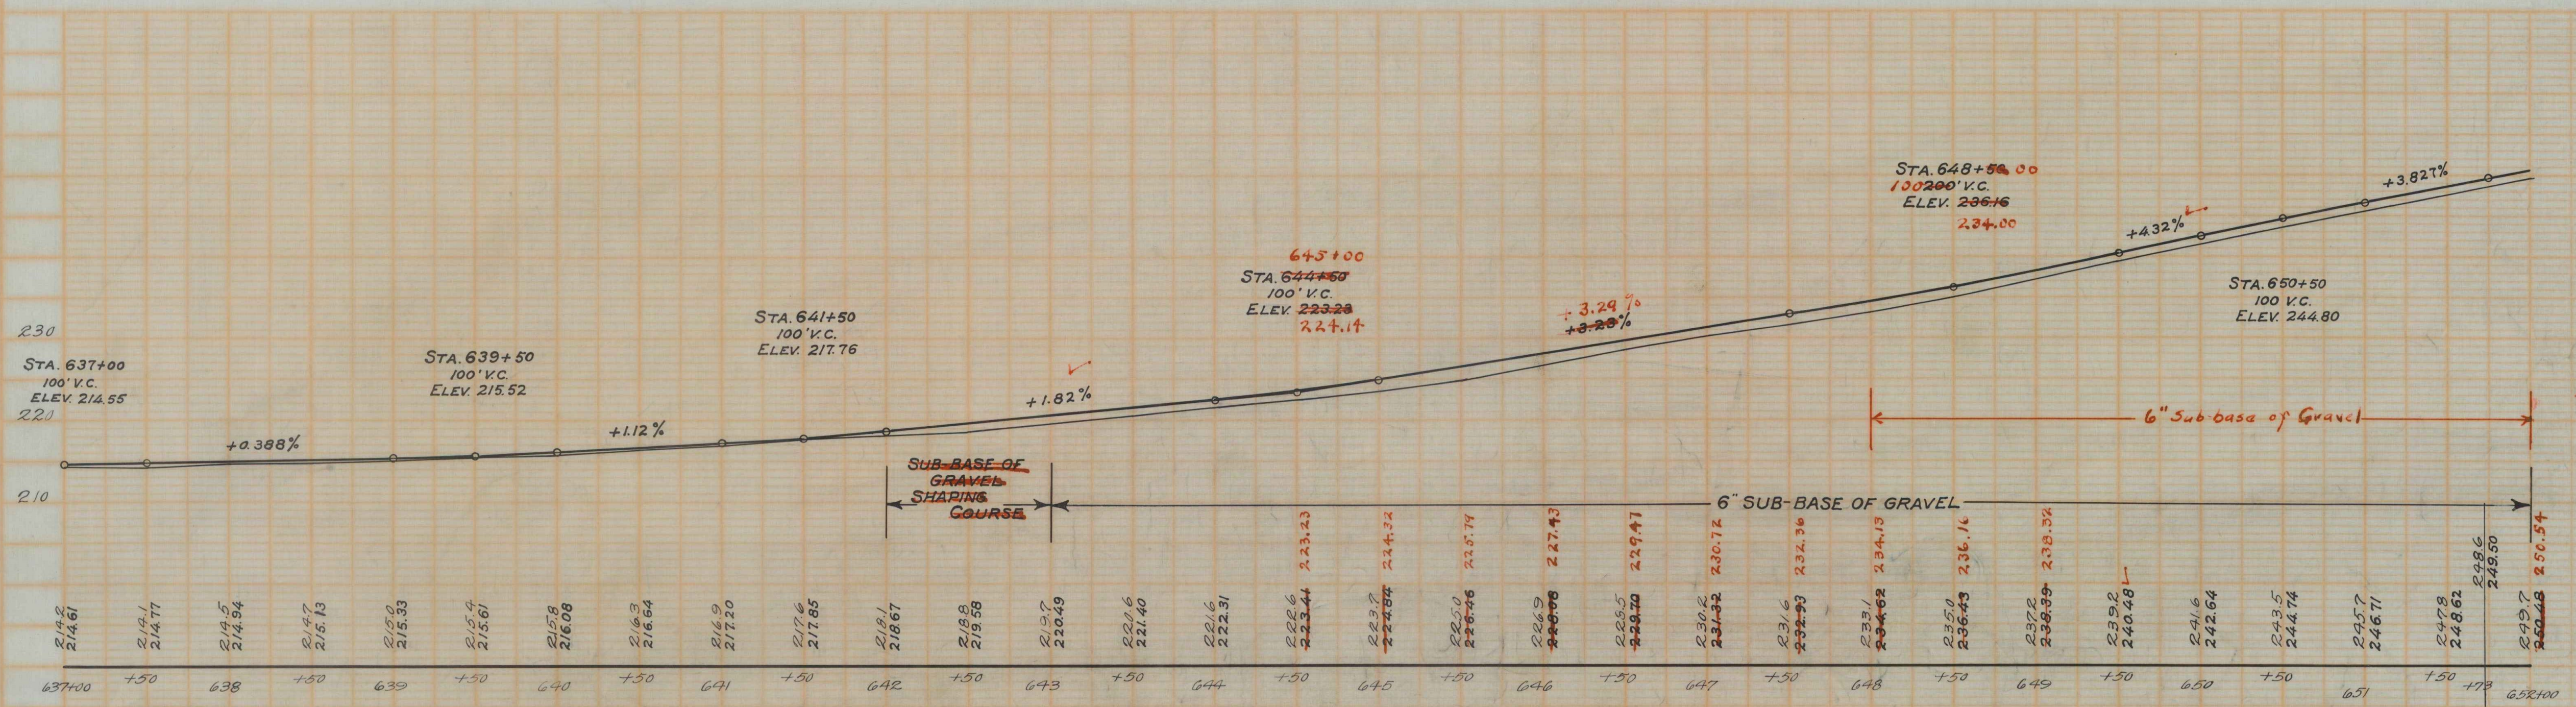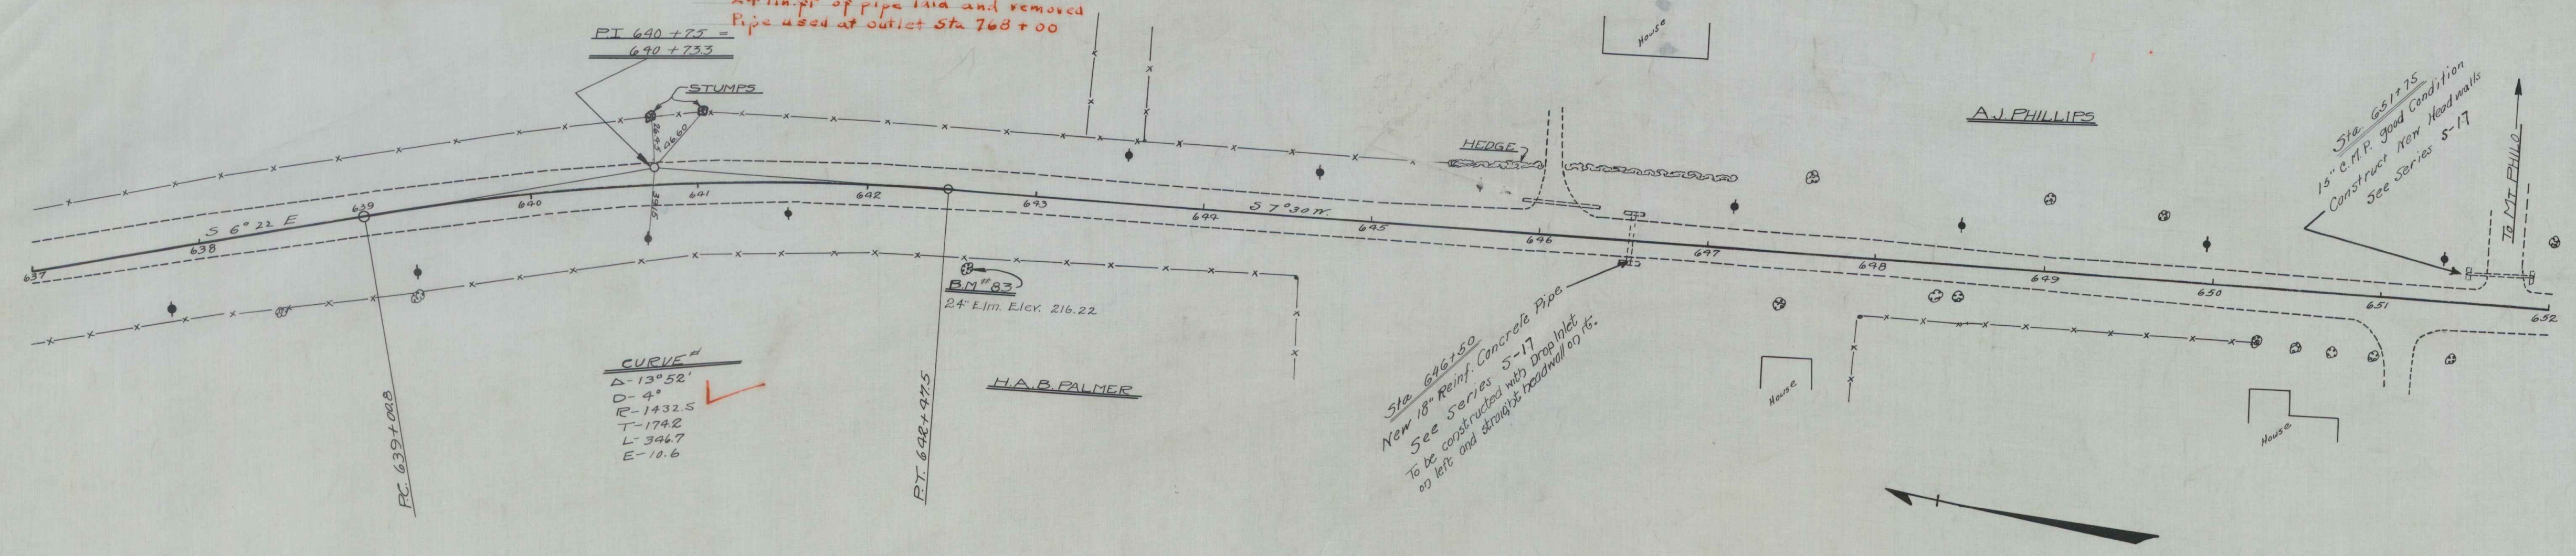

B.M. NO. 83 = SPIKE IN 24" ELM, 47' RIGHT OF STA. 642+62 ELEV. 216.22

SERIES F No 728
 SHEET 15 of 104