



WOOD GUARD RAIL REQUIRED.
 LEFT and Right 4B
 Sta. 671+58 to 671+62 Length 4 ft.
CABLE GUARD RAIL REQUIRED
 Sta. 668+00 to 674+25 Length 625 ft.
 " 670+75 to 672+25 " 150 "

NEW CULVERTS REQUIRED.
 Sta. 671+50 - 30" Rein. Concrete Pipe Culvert to left
 Concrete Class A (1-2-4) 8.5 cu yds 8.9
 Reinforcing Steel 66 pounds 54

DRIVEWAY CULVERTS REQUIRED
 Sta. 673+25 - Left 12" Cor. Gully Metal Pipe 50 lin. ft.
 Concrete Class B (1-2-4) 11 cu yds.
 Sta. 675+25 - Right 12" Cor. Gully Metal Pipe 30 lin. ft.
 Concrete Class B (1-2-4) 5.4 cu yds.
 " 679+00 - Right 12" Cor. Gully Metal Pipe 20 lin. ft.
 Concrete Class B 1.4 cu yds.
GOLDIE DEAN

SUB-BASE OF GRAVEL REQUIRED.
 Sta. 668+00 to 674+25 - 6" Sub-base of gravel 800 lin. ft.
 " 670+75 to 672+25 - 9" " " 400 "

FED. ROAD DIST. NO.	STATE	FED. AID PROJ. NO.	FISCAL YEAR	SHEET NO.	TOTAL SHEETS
VI.	72B	1228	17	104	

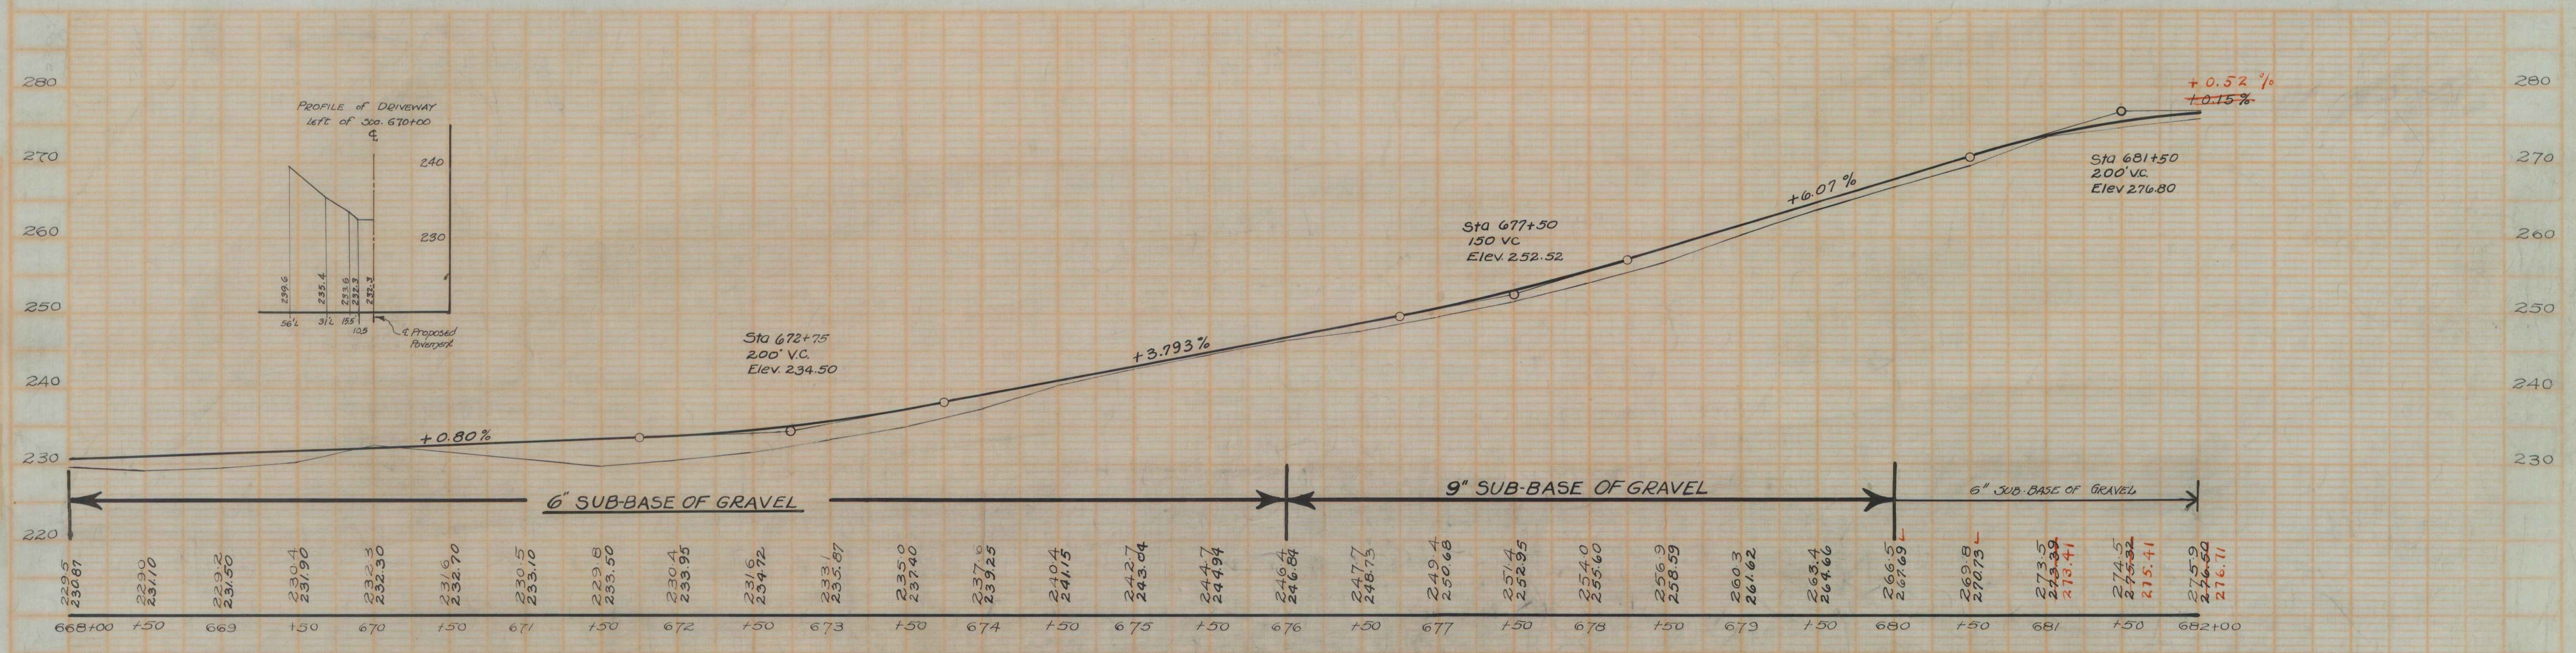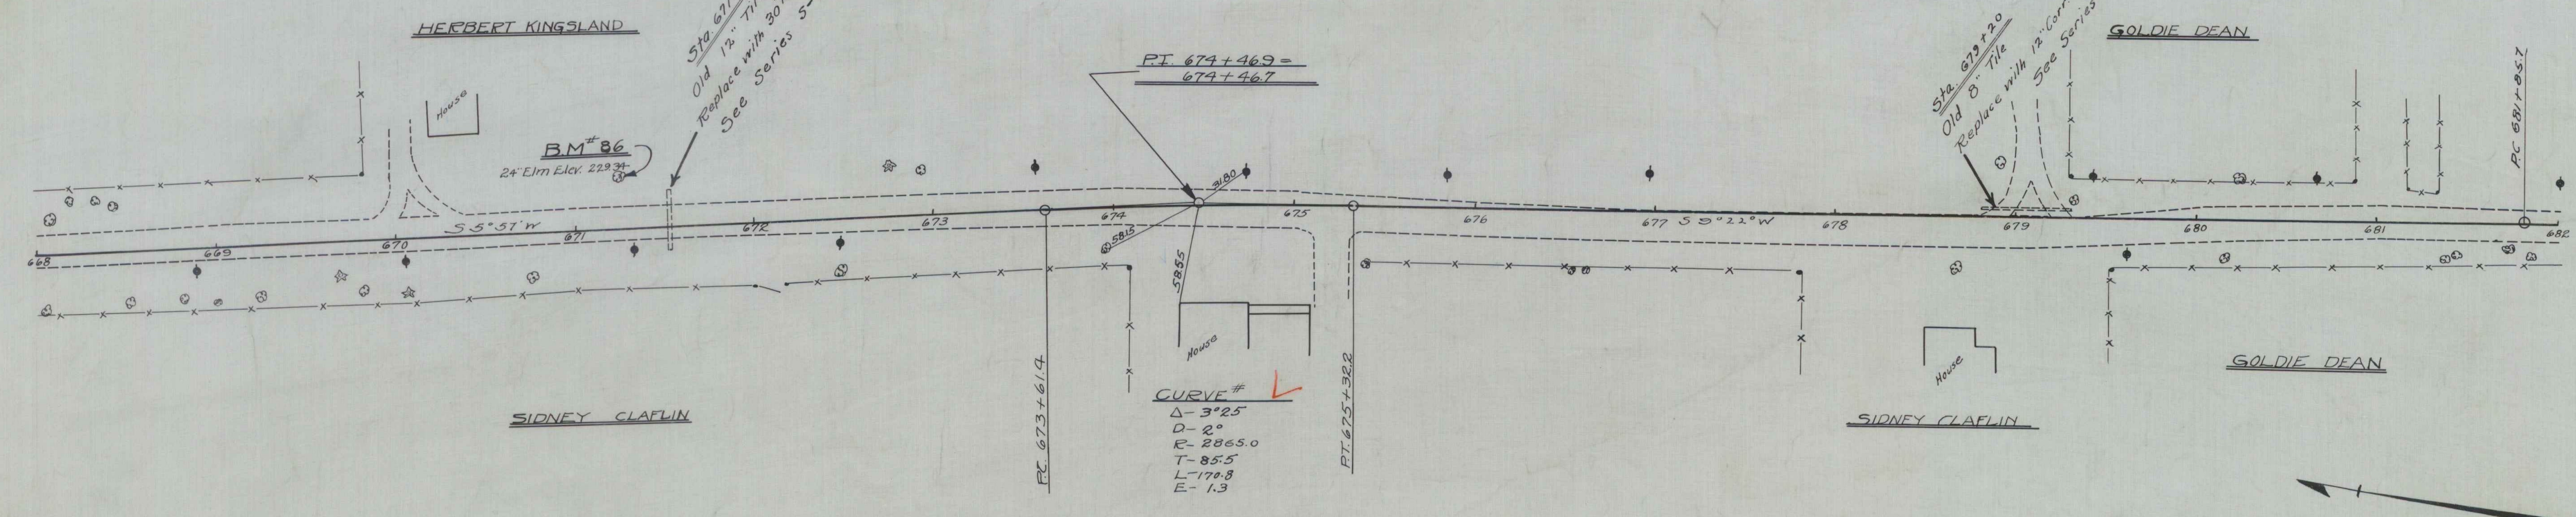

B.M. NO. 86 - SPIKE IN 24" ELM, 28' LEFT OF STA. 671+25 ELEV. 229.34