
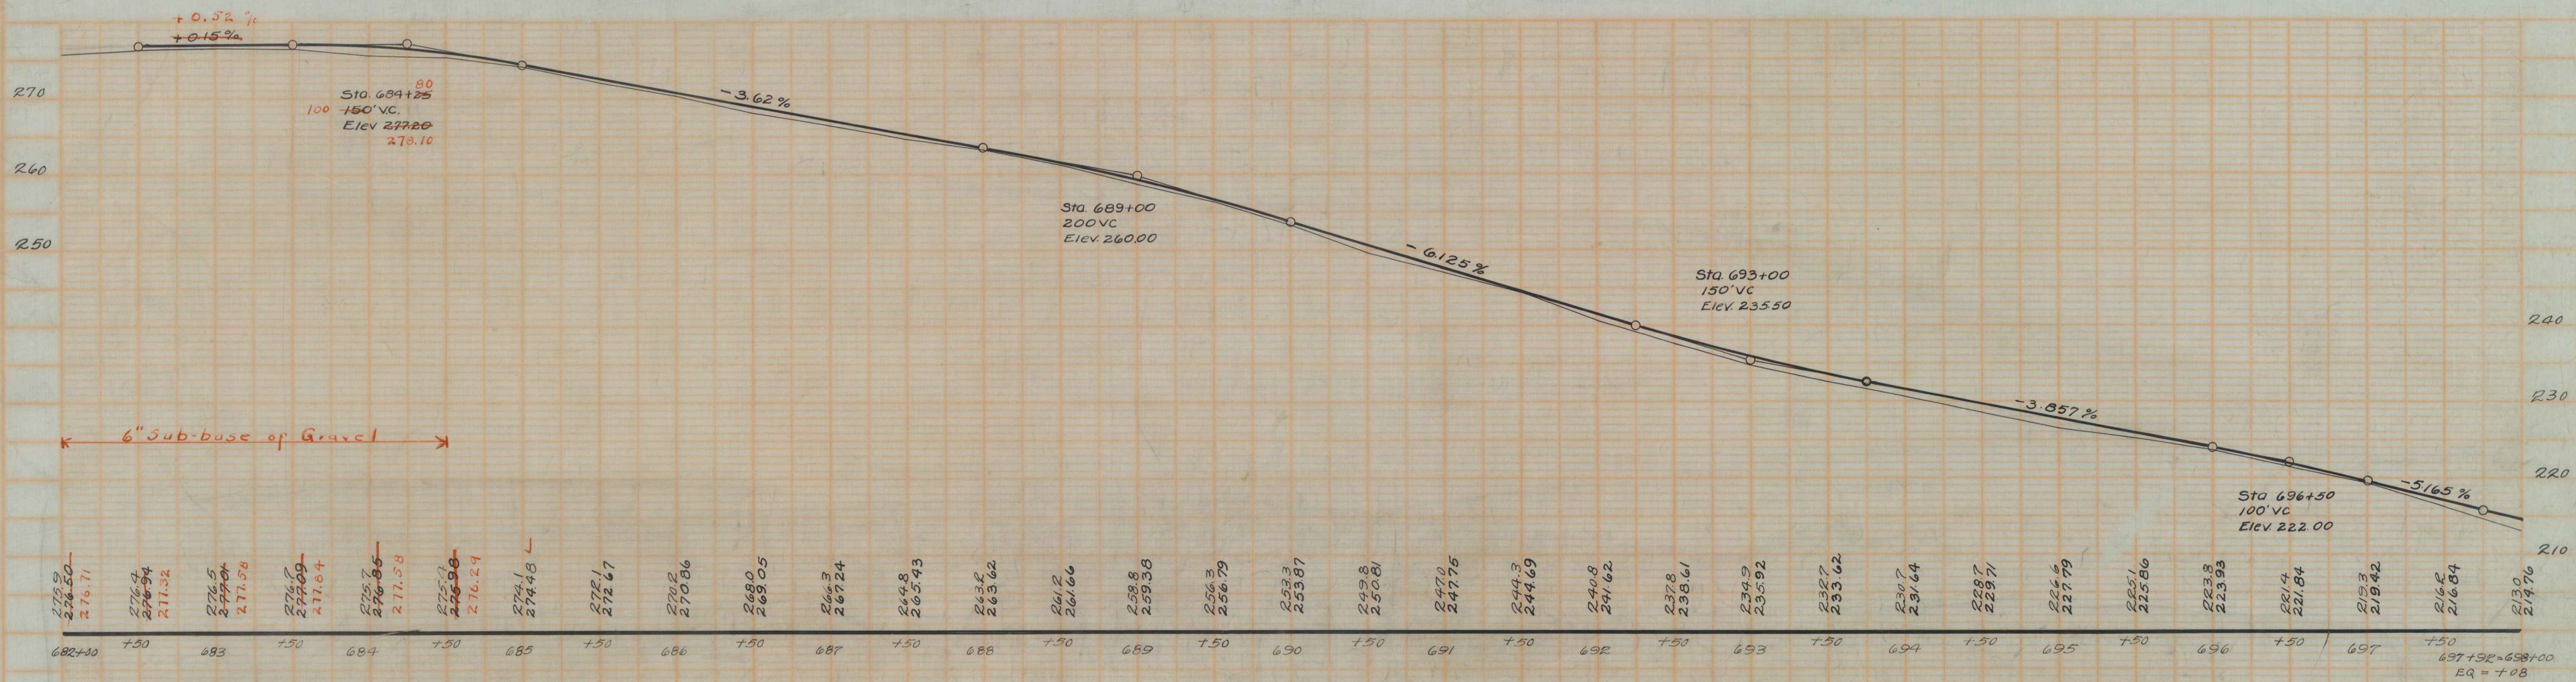


DRIVEWAY CULVERTS REQUIRED
Sta 683+75 Right 12" Cor. Galv. Metal Pipe 14' Lin. fr. 32
Concrete Class 2 (1-2'-3) 1.4 Cuts 1.4

FED. ROAD DIST. NO.	STATE	FED. AID PROJ. NO.	FISCAL YEAR	SHEET NO.	TOTAL SHEETS
9	VI.	728	1928	18	102

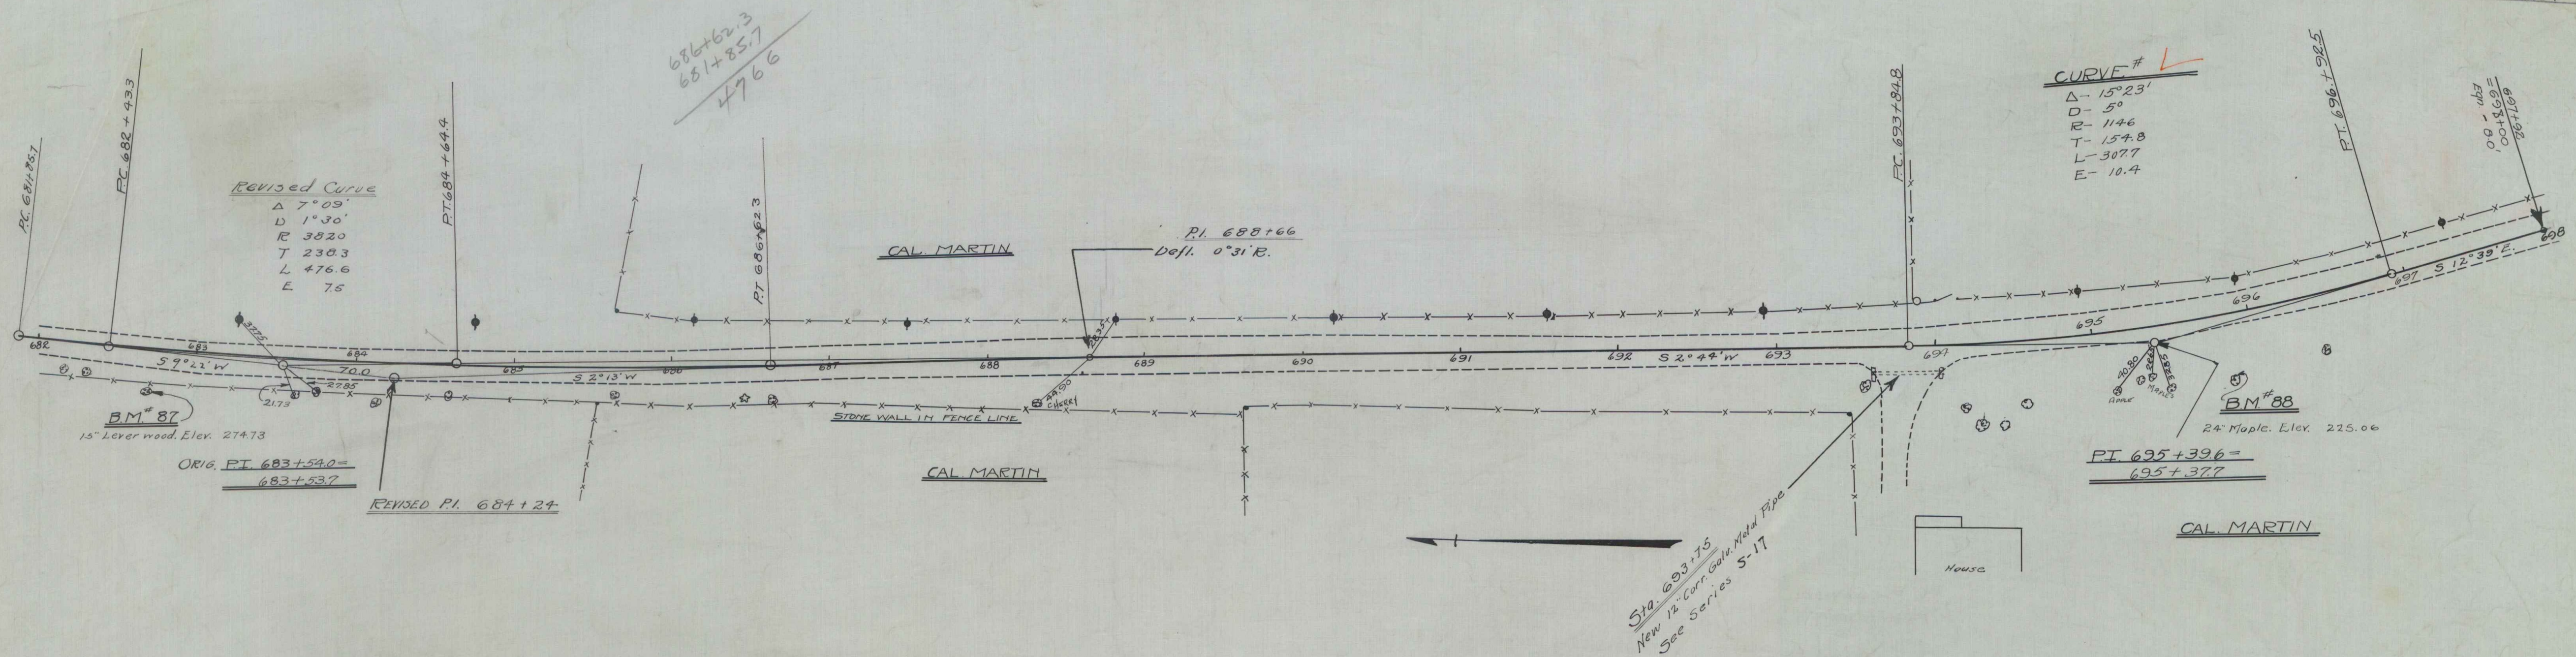

B.M. No 87 = SPIKE IN 15" LEVER WOOD, 15' RIGHT OF STA. 682+32 ELEV. 274.73
 B.M. No 88 = SPIKE IN 24" MAPLE, 93' RIGHT OF STA. 695+86 ELEV. 225.06

SERIES F NO 72B
SHEET 18 of 104