
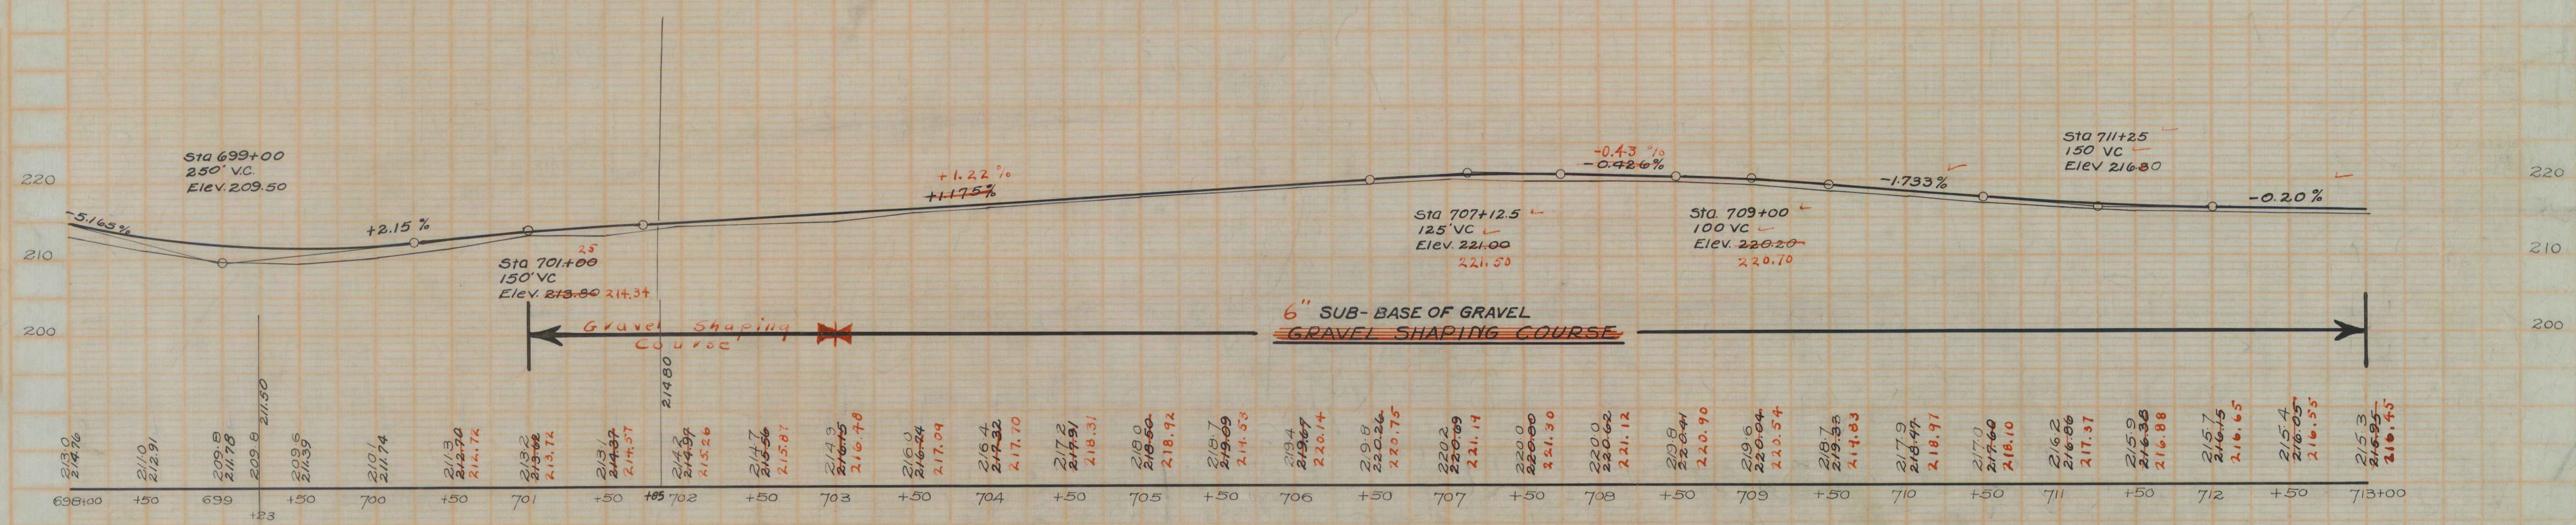


WOOD GUARD RAIL REQUIRED				CABLE GUARD RAIL REQUIRED				NEW CULVERTS REQUIRED				PLAYING DRIVEWAY CULVERTS			
LEFT		Length	27 Lin. ft	LEFT		Length	90 Lin. ft	Sta. 712+88 - 24" Rein. Concrete Pipe Culvert		32 Lin. ft		Sta. 702+20 Left 18" Cor. Galv. Metal Pipe		Length 16 ft.	
Sta. 712+73 to 712+97				RIGHT				Concrete Class B (1-2-4) 4.7		2.6 Cu yds		Concrete Class B (1-2-4) 5		1.4 Cu yds	
" 644+21 " 644+45 RIGHT				Sta. 698+50 to 699+40				Reinforcing Steel		54	60 pounds	Left 16" Cor. Galv. Metal Pipe		Length 16 ft.	0
Sta. 712+73 to 712+97		Length	24 Lin. ft	Sta. 698+50 to 699+40		Length	90 Lin. ft	SUB-BASE OF GRAVEL REQUIRED		200		Concrete Class B (1-2-4) 5		1.4 Cu yds	1.4
" 644+21 " 644+45				Sta. 698+50 to 699+40				Sta. 701+00 to 703+00 Gravel Shaping Course		1200 Lin. ft		Left 16" Cor. Galv. Metal Pipe		Length 16 ft.	0
								" 703+00 " 713+00 6" Sub-base of Gravel		1000 " "		Concrete Class B (1-2-4) 5		1.4 Cu yds	1.4

FED. ROAD DIST. NO.	STATE	FED. AID PROJ. NO.	FISCAL YEAR	SHEET NO.	TOTAL SHEETS
9	VI.	723	1923	19	104

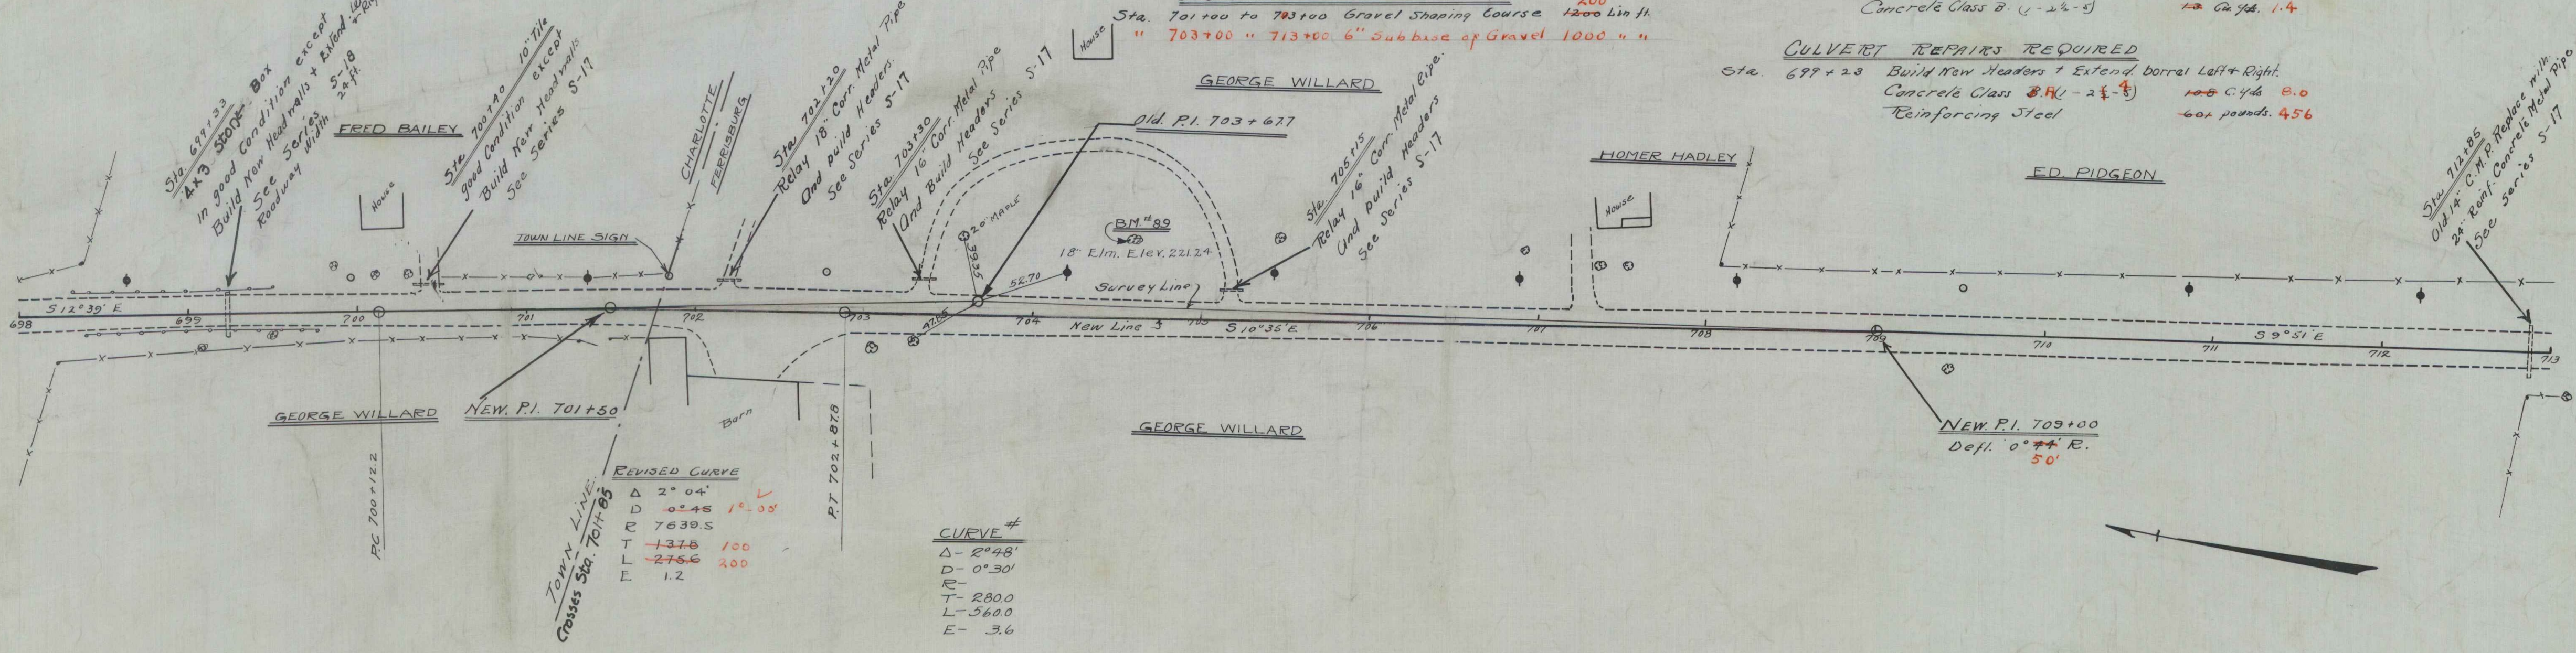

B.M. NO. 89 = SPIKE IN 18" ELM. 40' LEFT OF STA. 704+62 ELEV. 221.24