

WOOD GUARD RAIL REQUIRED

STATION	LEFT	RIGHT	Length
Sta 733+76 to 734+00			24 ft
" 736+00 to 737+12			24 "
Sta 733+76 to 734+00			24 ft
" 736+00 to 737+12			24 "

NEW CULVERTS REQUIRED



STATION	DESCRIPTION	Length
Sta. 733+88	15" Reinf. Concrete Pipe Culvert	30 ft. +8
	Concrete Class B (1-2 1/2'-5)	2.6 cu yds
	Reinforcing Steel	33 pounds
Sta. 737+00	15" Reinf. Concrete Pipe Culvert	32 ft.
	Concrete Class B (1-2 1/2'-5)	2.6 cu yds
	Reinforcing Steel	33 pounds

DEWEY CULVERTS REQUIRED

STATION	DESCRIPTION	Length
Sta. 727+20	Left 12" Cor. Galv. Metal Pipe	20 ft.
	Concrete Class B (1-2 1/2'-5)	11 cu yds
Sta. 730+20	Left 12" Cor. Galv. Metal Pipe	40 ft.
	Concrete Class B (1-2 1/2'-5)	1.1 cu yds
Sta. 736+20	Left 12" Cor. Galv. Metal Pipe	20 ft.
	Concrete Class B (1-2 1/2'-5)	1.4 cu yds

Sta 736+15 Right - 12" Cor. Galv. Metal Pipe 20 Lin. ft.
 Concrete Class B (1-2 1/2'-5) 1.4 cu yds
 " 726+00 Left - Repair Headwalls
 Concrete class B (1-2 1/2'-5) 1.4 cu yds

FED. ROAD DIST. NO.	STATE	FED. AID PROJ. NO.	FISCAL YEAR	SHEET NO.	TOTAL SHEETS
9	VT.	728	1948	21	104

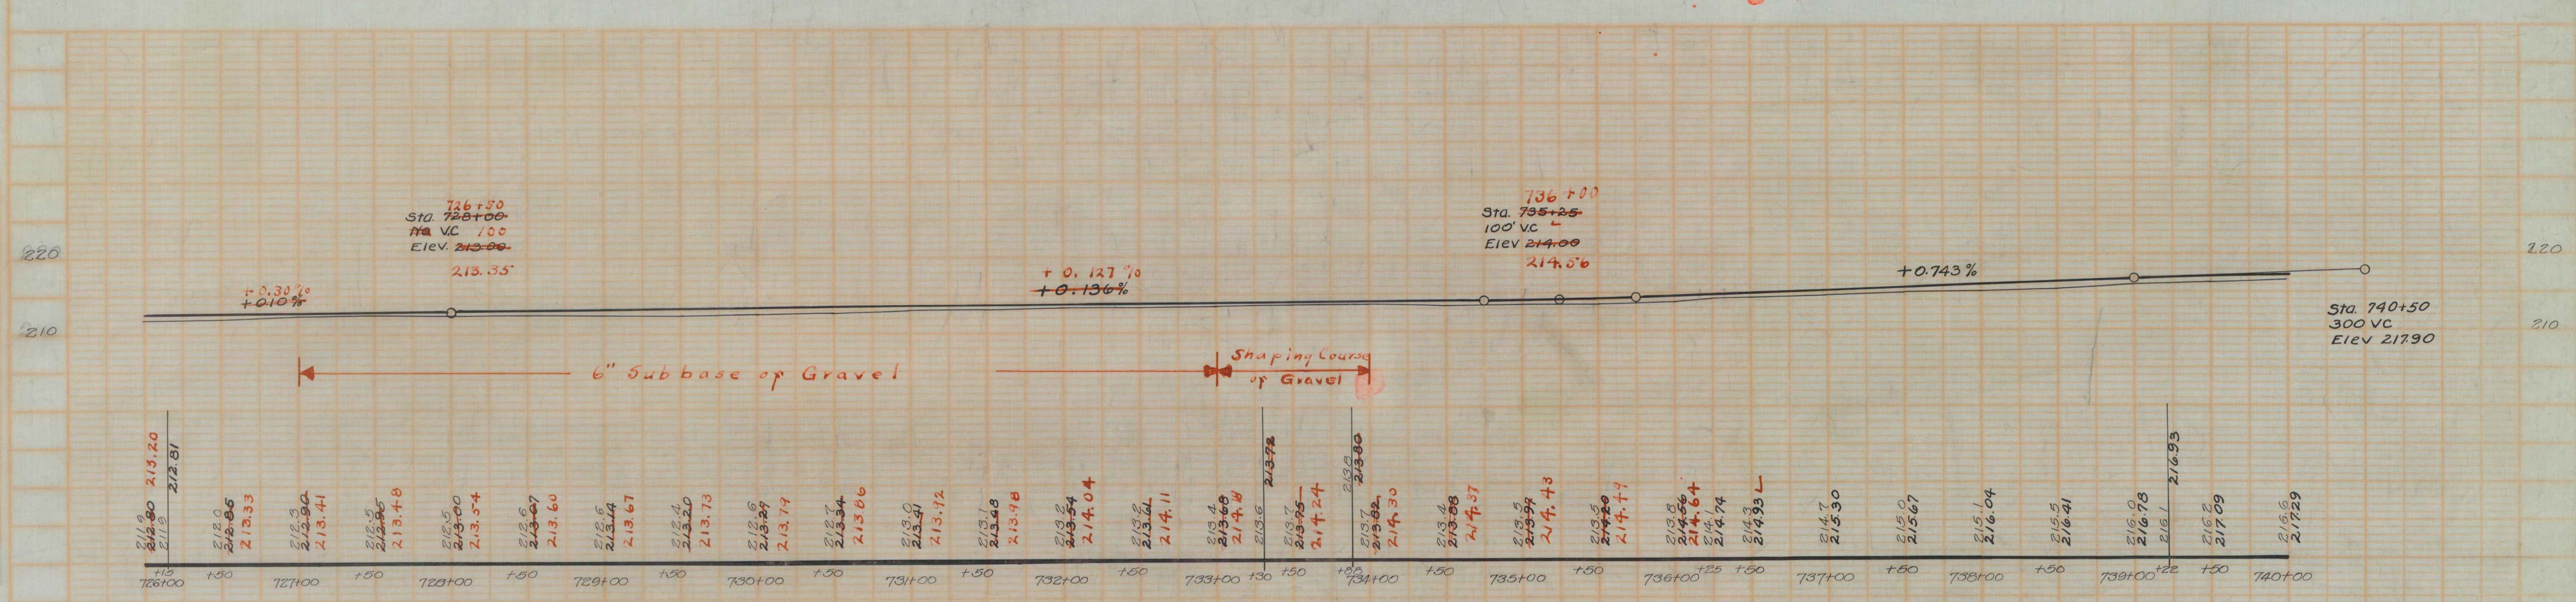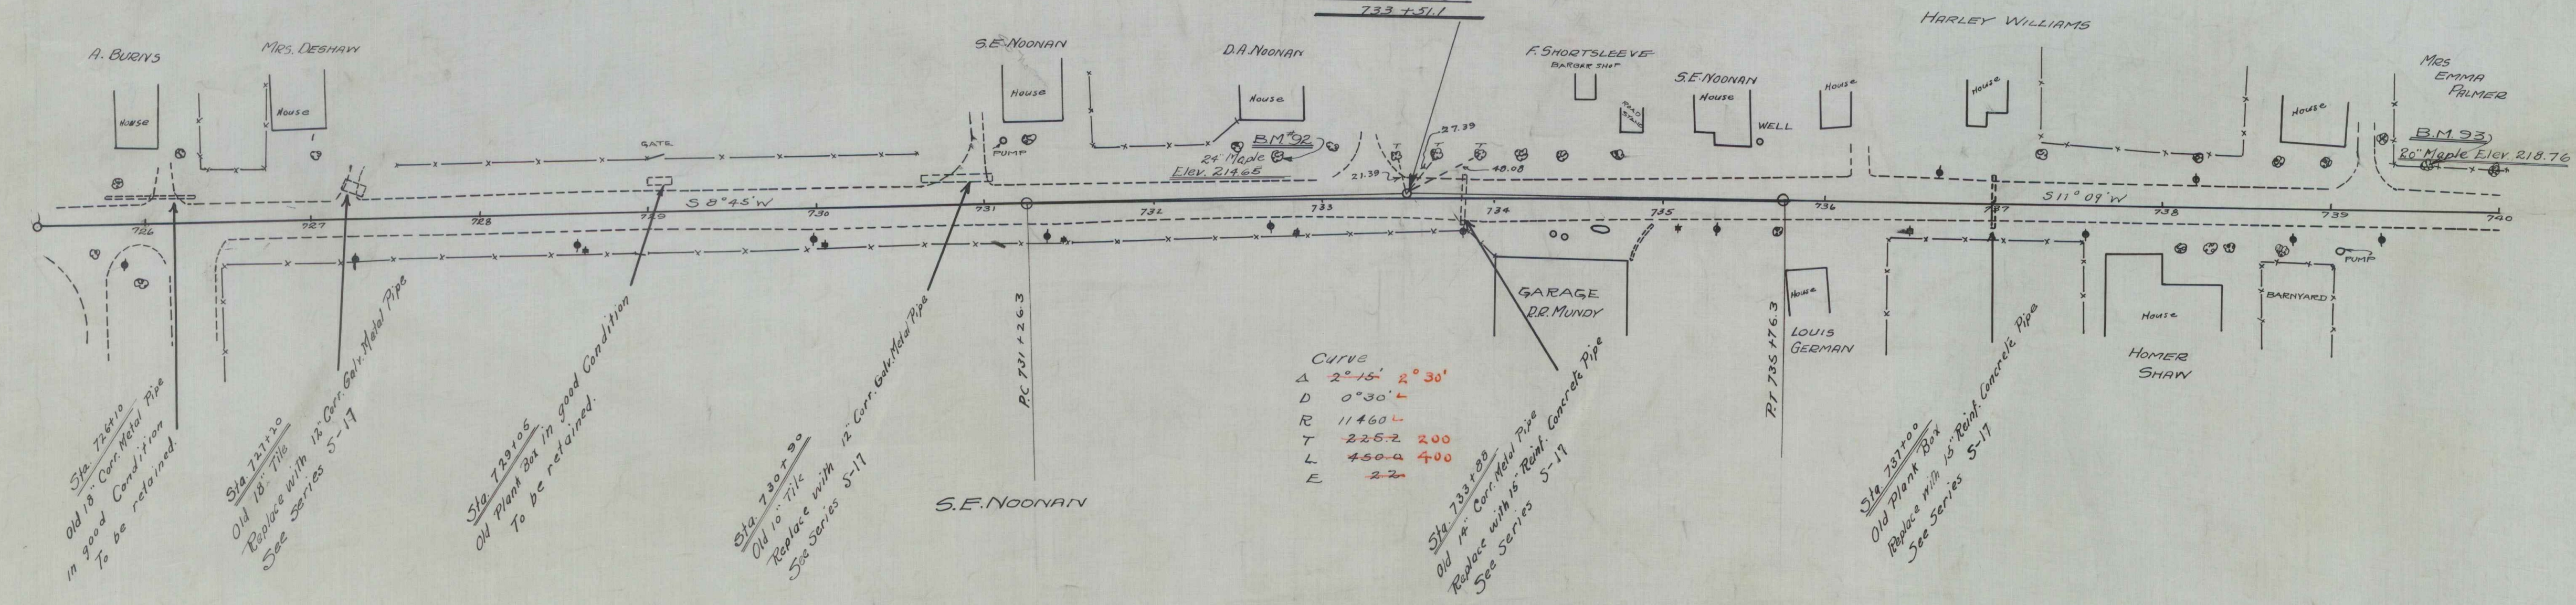

B.M. No. 92. Spike in 24" Maple. Left of Sta. 722+75 Elev. 214.65
 B.M. No. 93. " " 20 " " " 739+55 " 218.76