
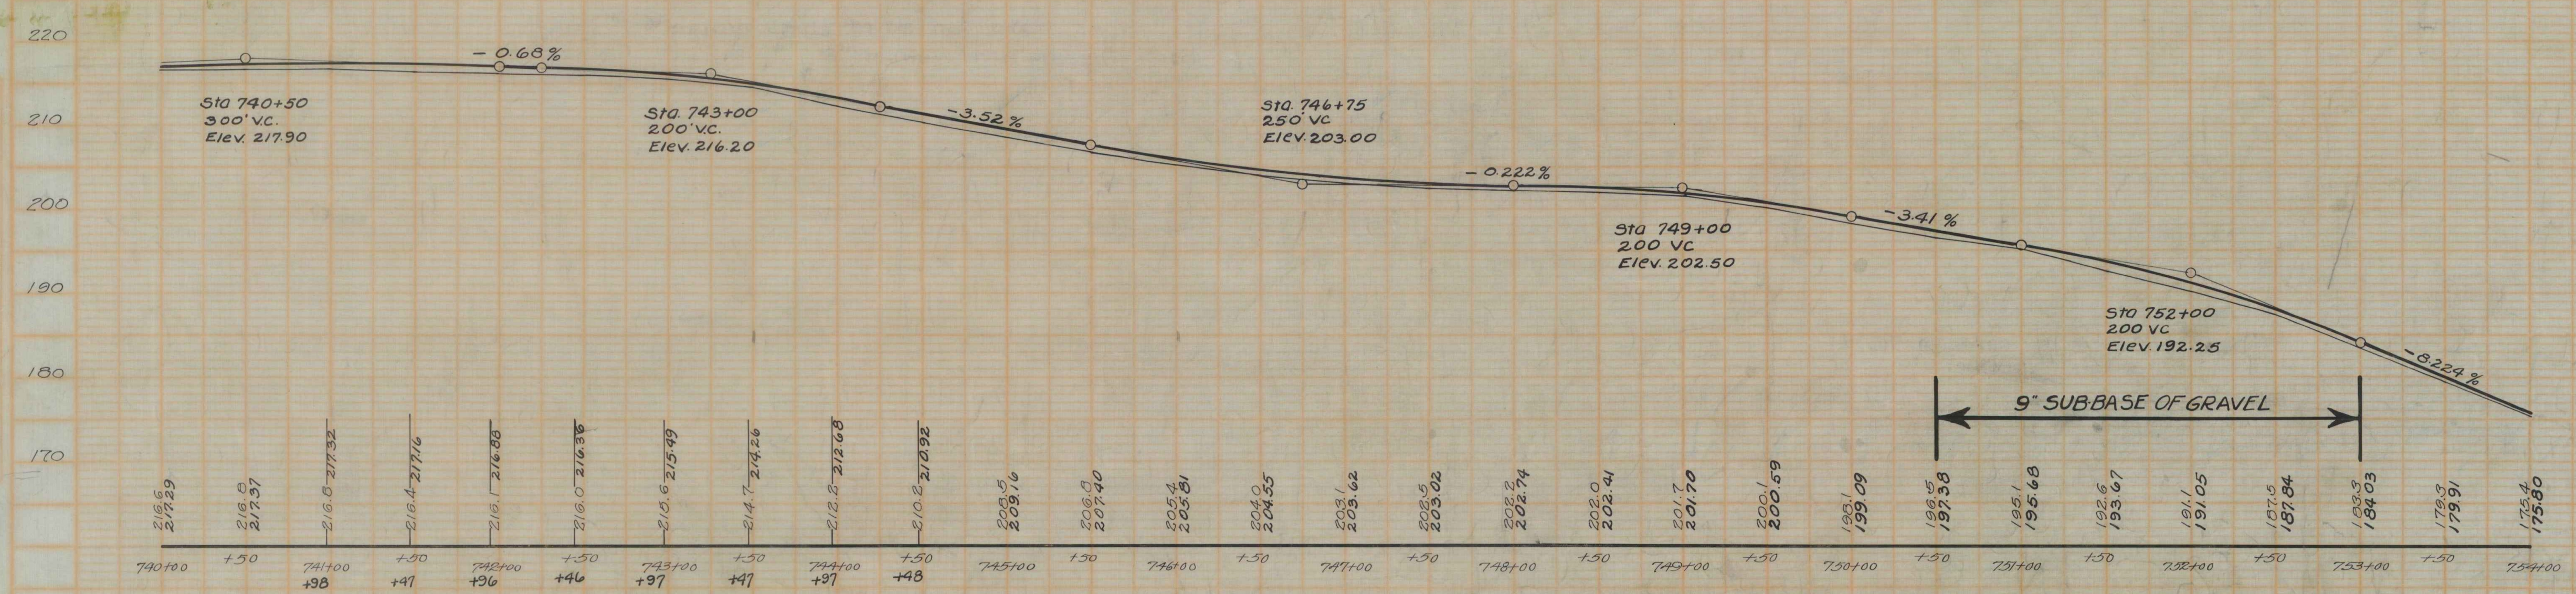


DRIVEWAY CULVERTS REQUIRED.
 Sta. 750+00 Right 12" Corrugated Metal Pipe 20 ft.
 Concrete Class B (1-2 1/2") 14 cu yds.
 Sta. 744+25 Lefts Relay 20" Line of Pipe
 Concrete class B (1-2 1/2") 14 cu yds.

SUB-BASE OF GRAVEL REQUIRED.
 Sta. 750+50 to 753+00 9" Sub-base of gravel 250 ft.
 " 753+00 to 754+00 9" Sub-base of gravel 100 ft.
 743+50 to 746+00 6" Sub-base of gravel 250 ft

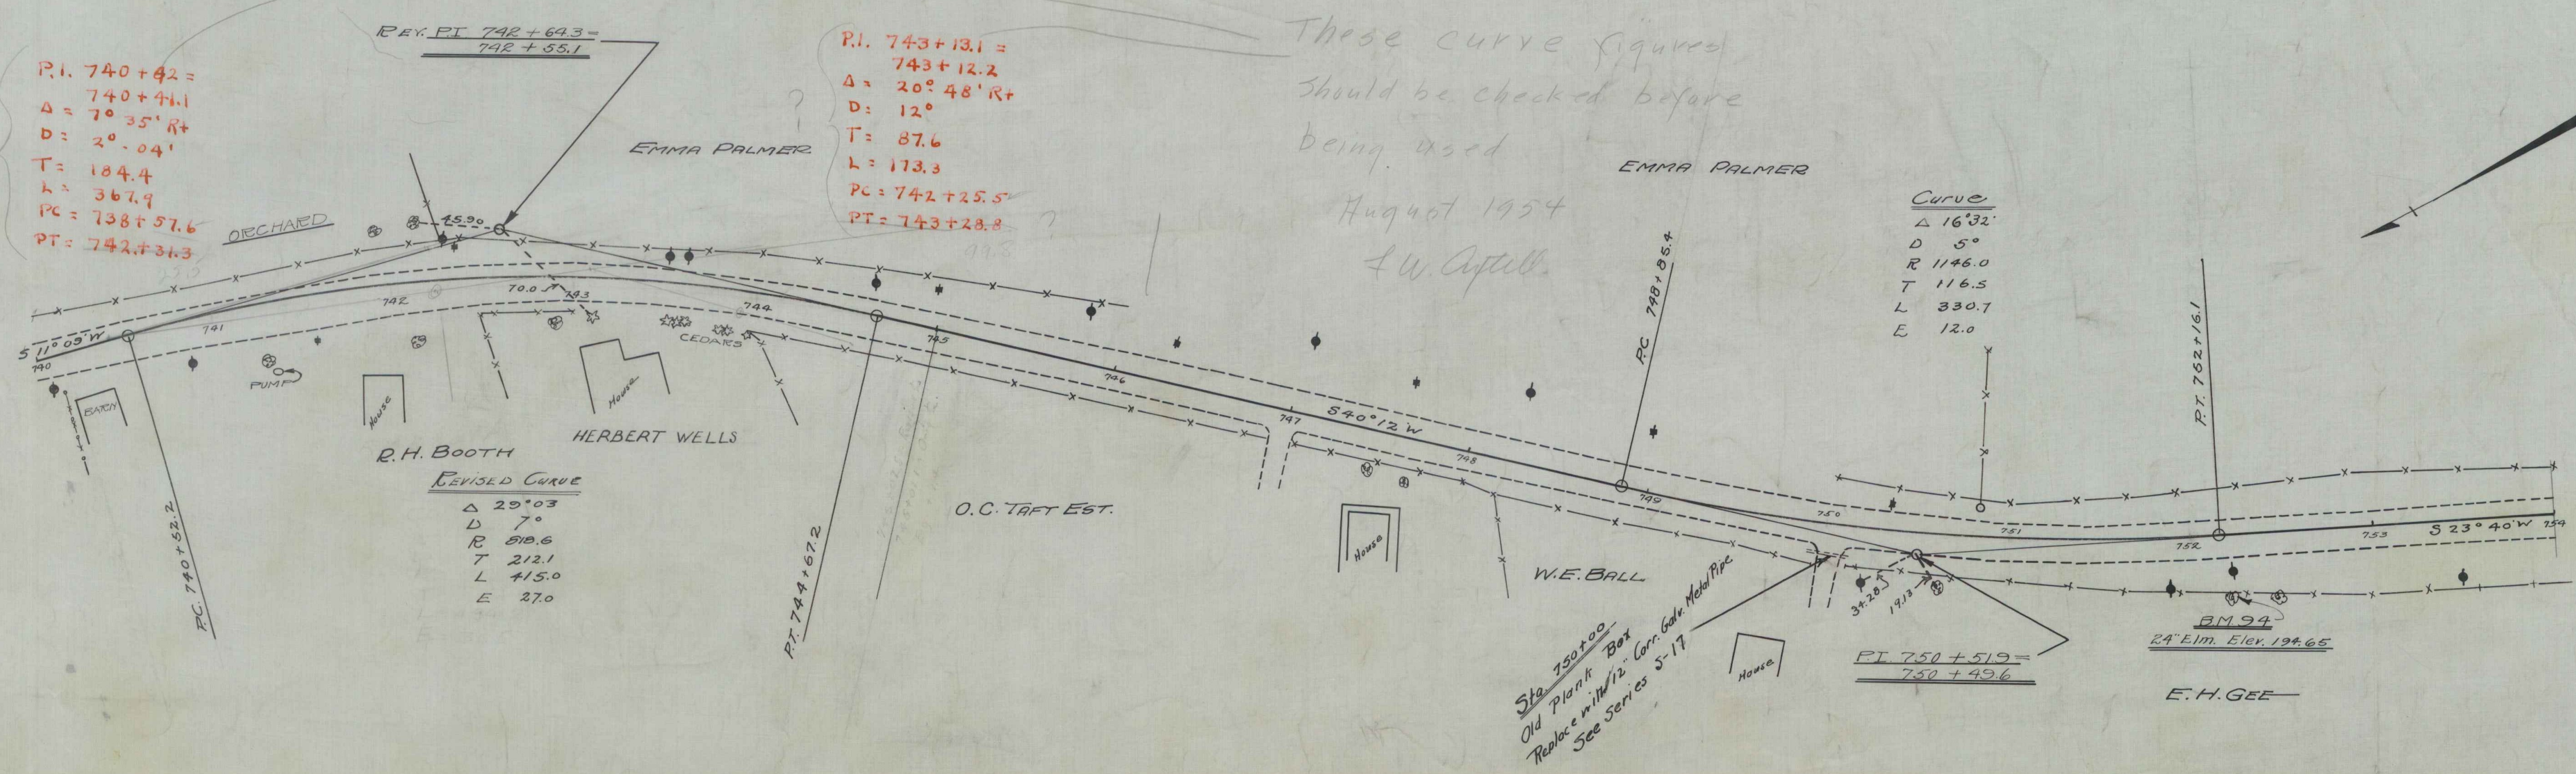

B.M. No. 24 Spike in 27" Elm Right of 752+00 Elev. 194.65