
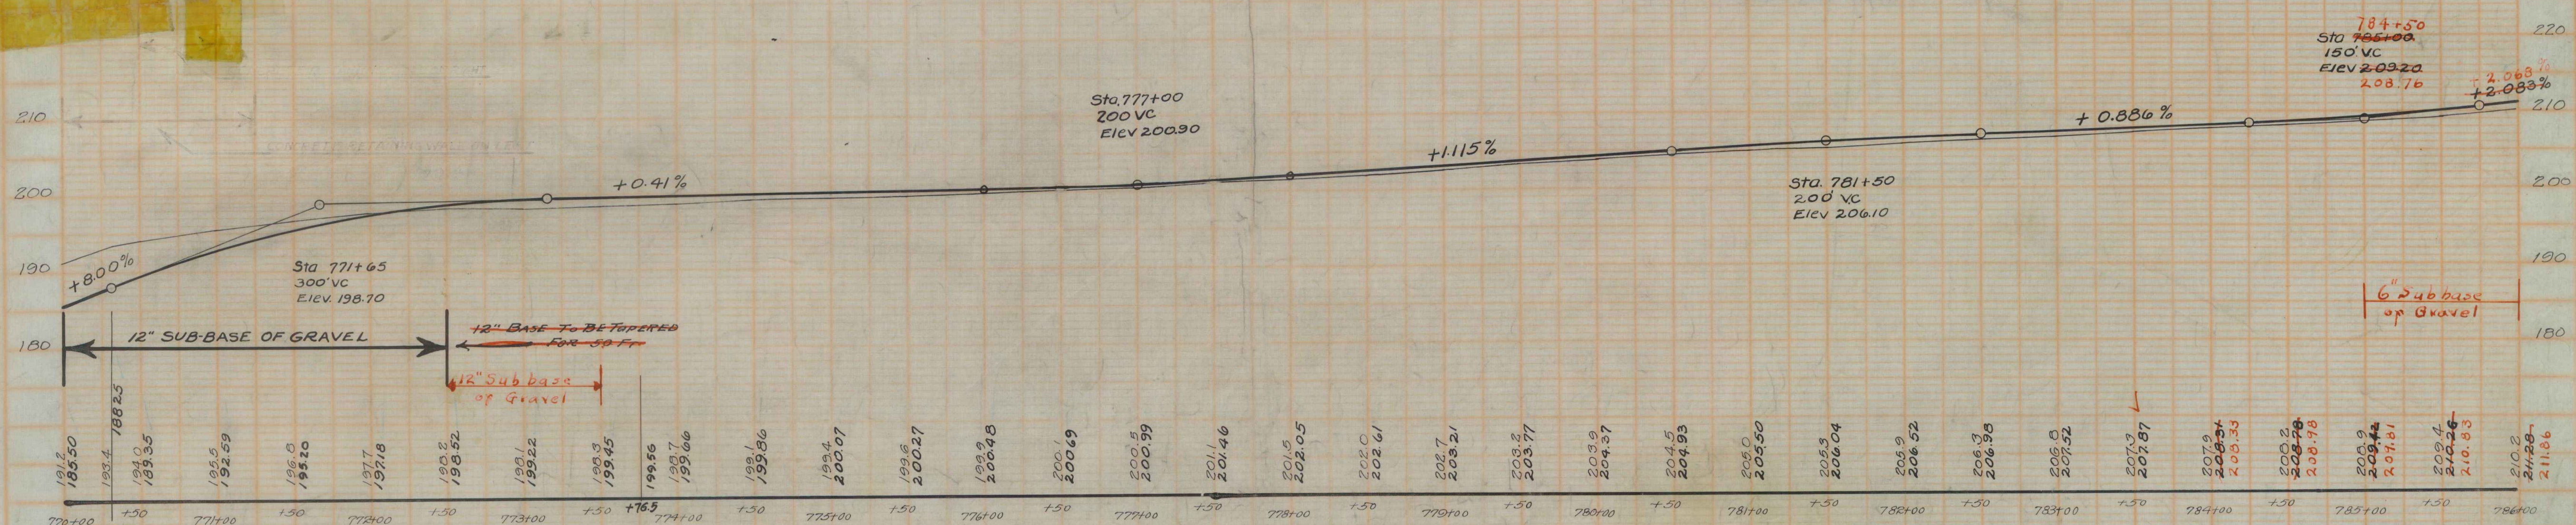


SUB-BASE OF GRAVEL REQUIRED. 350
 Sta 770+00 772+50 - 12" Sub-base of Gravel 250 Lb. ft.
 " 773+50
 " 785+00 786+00 6" " " " 100 " "

CONCRETE RETAINING WALLS REQUIRED

FED. ROAD DIST. NO.	STATE	FED. AID PROJ. NO.	FISCAL YEAR	SHEET NO.	TOTAL SHEETS
9	VI.	720	1920	24	104

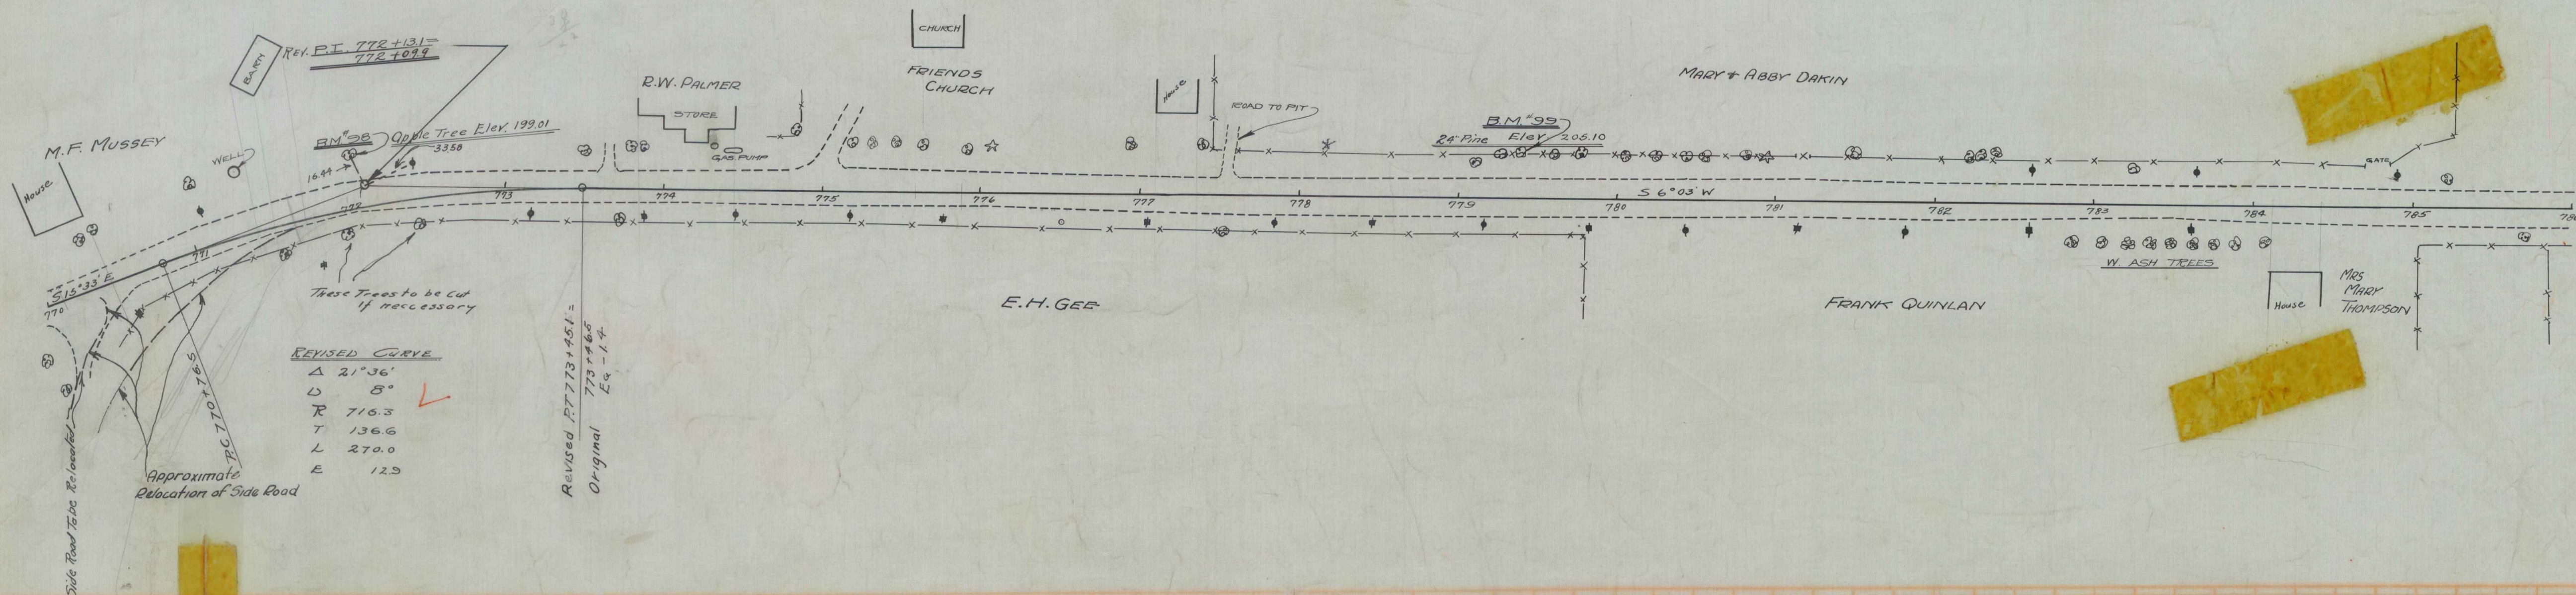

B.M. No. 98. Spike in Apple Tree Left of Sta. 772+00 Elev. 198.01
 B.M. No. 99. " " 24" Pine Left " " 779+39 Elev. 205.10

Series f No 728
 Sheet 24 of 104