



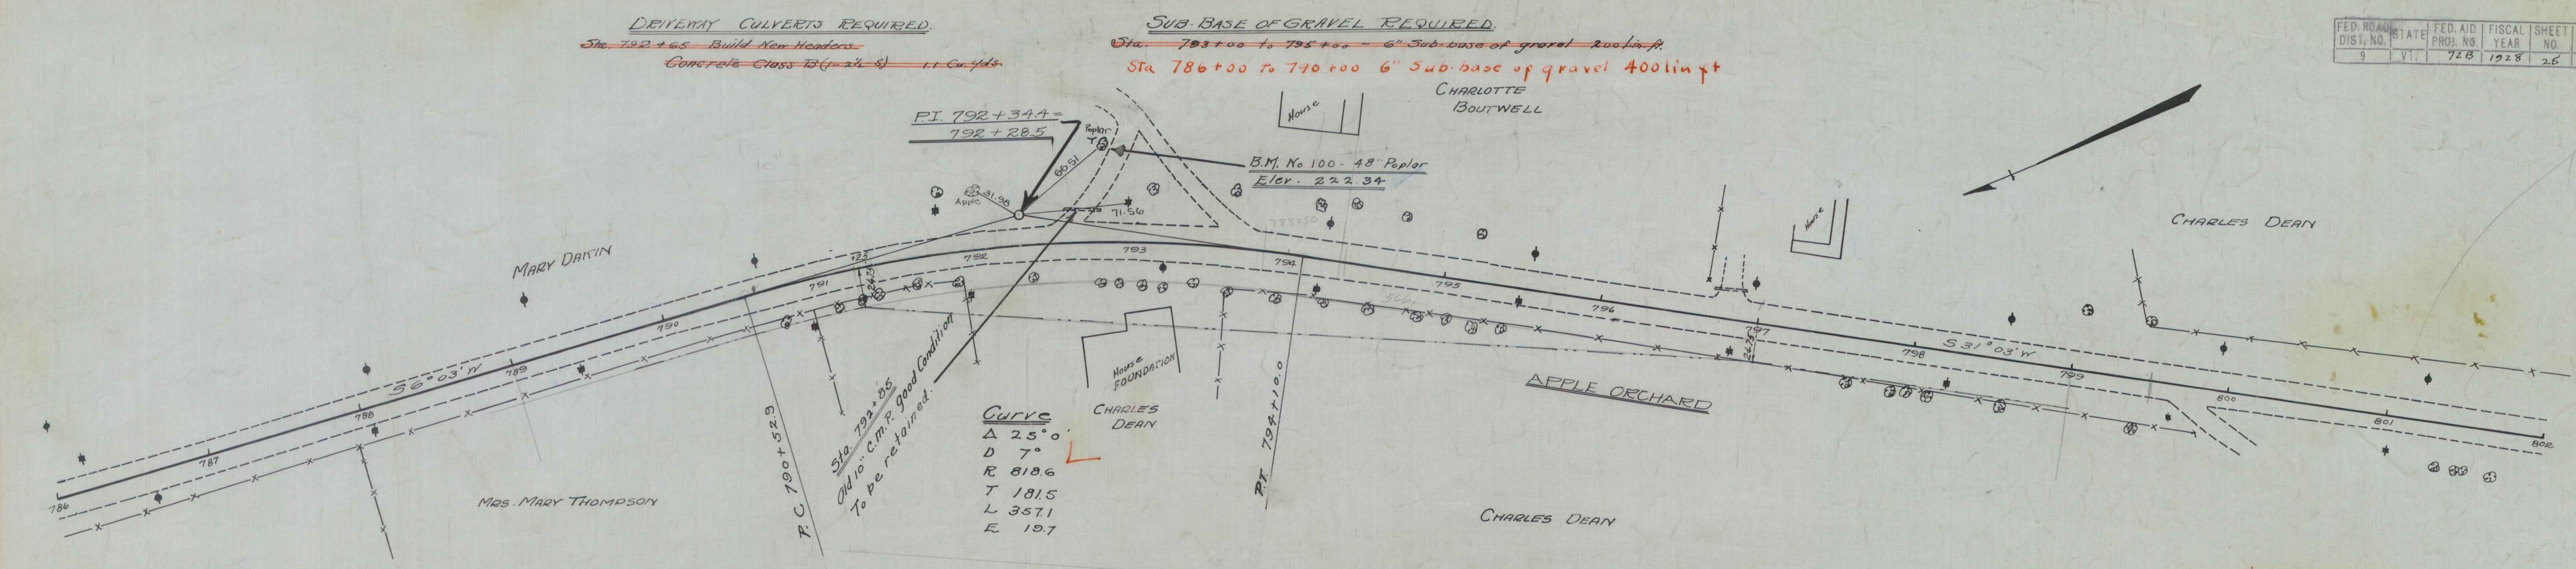

PARCEL	INSTRUMENT	DATE	GRANTOR	GRANTEE	RECORDED	REMARKS
A	W.D.O.E.	10-9-40	CH & MARTHA J. DEAN	ST. OF VT.	FERRISBURGH BOOK 31 PAGE 324 DATE 10-14-40	

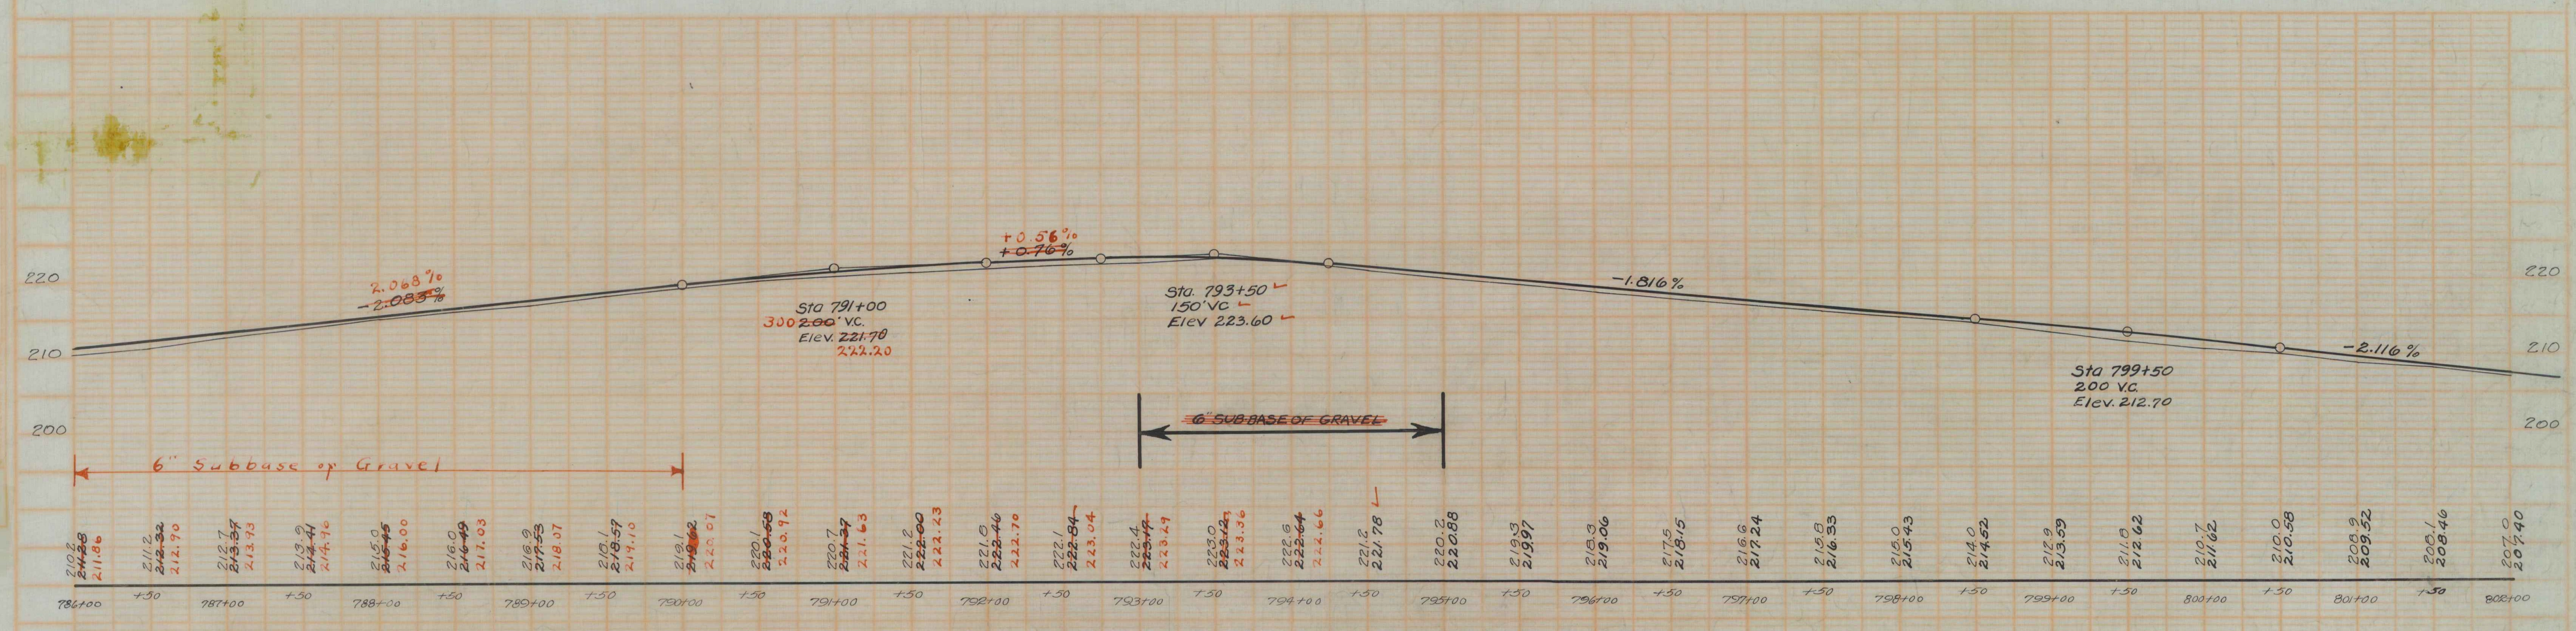

B.M. 100 Spike in 48" Poplar Left of Sta. 792+86 Elev. 222.34